


DRAWING NUMBER: MD-216-3420-EG-CV-GAD-1007
REV: D01

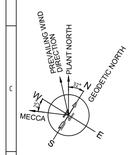


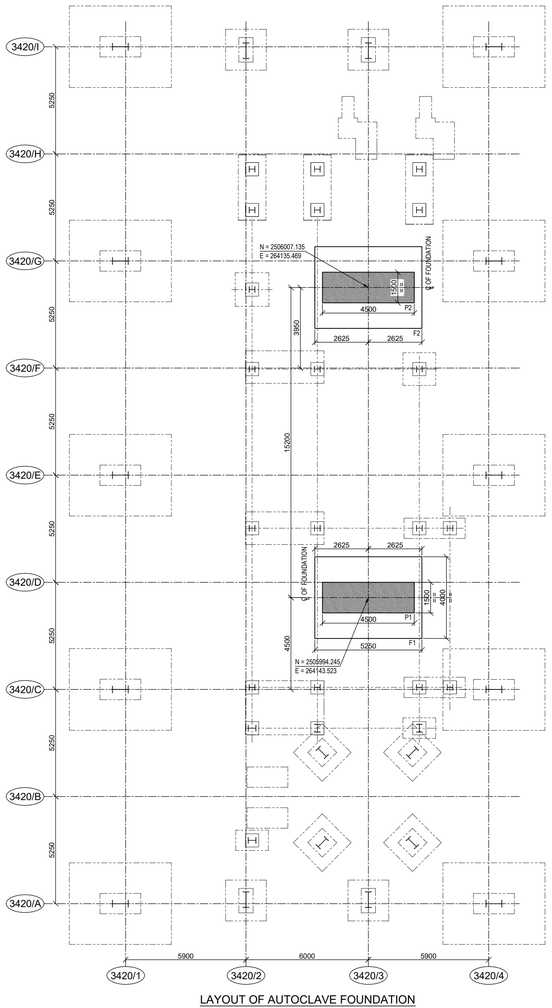


LAYOUT OF AUTOCLAVE FOUNDATION
(SCALE - 1:100)

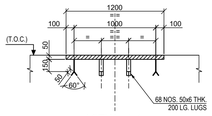


VIEW : 1-1
SCALE 1:25

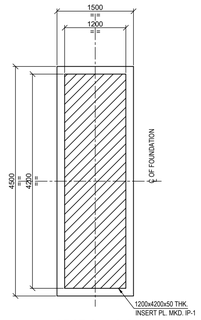


SECTION : B-B
SCALE 1:40

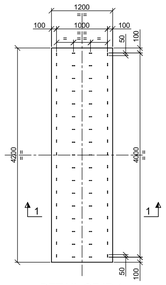


DETAIL OF IP-1
SCALE 1:40

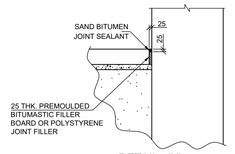


DETAIL - 'X'
SCALE 1:20

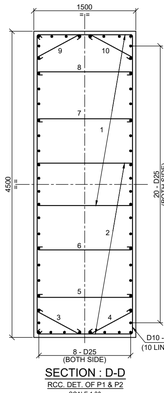


KEY PLAN
(SCALE- 1:750)

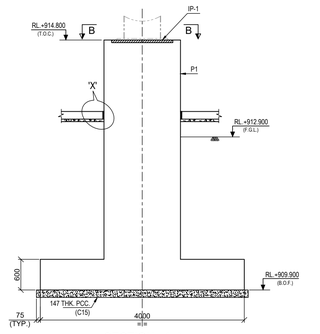

SECTION : A-A
SCALE 1:40

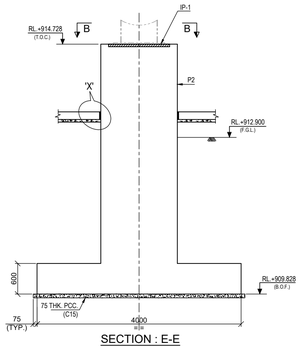


SECTION : E-E
SCALE 1:40

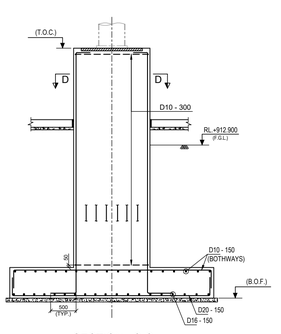


SECTION : C-C
SCALE 1:40


SECTION : D-D
RCC. DET. OF P1 & P2
SCALE 1:30

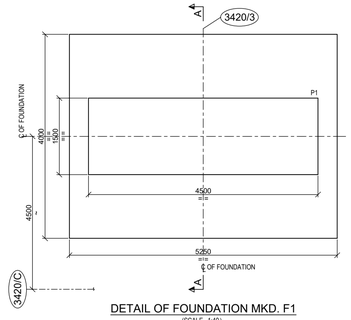

DETAIL OF FOUNDATION MKD. F1
(SCALE - 1:40)

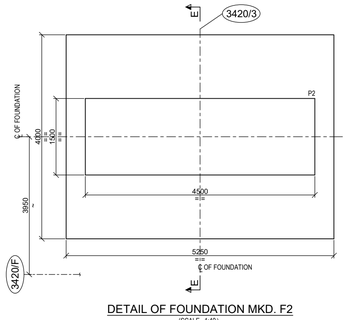

DETAIL OF FOUNDATION MKD. F2
(SCALE - 1:40)

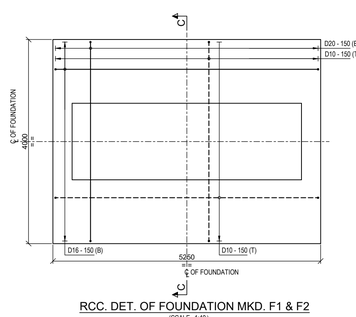

RCC. DET. OF FOUNDATION MKD. F1 & F2
(SCALE - 1:40)

LEGEND :-

AUTOCL. - AUTOCLAVE
V. - VESSEL
SCRUB. - SCRUBBER
R.L. - REDUCED LEVEL
℄ - CENTRE LINE
T.O.C. - TOP OF CONCRETE
T.O.G. - TOP OF GROUT
F.G.L. - FINISHED GROUND LEVEL
B.O.F. - BOTTOM OF FOUNDATION
TYP. - TYPICAL
R.C.C. - REINFORCED CEMENT CONCRETE
P.C.C. - PLAIN CEMENT CONCRETE
BOTTOM REBAR (B) : ———
TOP REBAR (T) : – – – – –
MKD. - MARKED
THK. - THICK
DET. - DETAIL
DRG. - DRAWING
I.P. - INSERT PLATE

NOTES :-

1. ALL DIMENSIONS ARE IN MILLIMETRES AND LEVELS AND CO-ORDINATES ARE IN METRES. UNLESS OTHERWISE STATED.
2. GRADE OF CONCRETE SHALL BE C35 (35MPa) FOR FOUNDATION & COLUMN.
3. GRADE OF REINFORCEMENT SHALL BE DEFORMED BAR ASTM A615 - GRADE 60 (fy = 420 MPa).
4. NET SAFE BEARING CAPACITY OF SOIL AT BOTTOM OF FOUNDATION CONSIDERED 475KN/SQ. M.
5. CLEAR COVER TO MAIN REINFORCEMENT SHALL BE AS
   a) FOUNDATION = 75 mm (BOTTOM & SIDE) 50 mm. (TOP)
   b) COLUMN = 50mm
6. MINIMUM LAP LENGTH OF REINFORCEMENT SHALL BE 40 x DIA. OF BAR. AS PER DRG. NO. MD-216-1000-EG-CV-DED-1001.
7. IF ANY PART OF FOUNDATION COMES ON BACKFILL ZONE OF ADJACENT FOUNDATION OR ANY LOOSE SOIL ARE ENCOUNTERED BELOW FOUNDATION LEVEL THE SAME SHALL BE REMOVED AND FILLED WITH PCC.
8. ALL WELDS ARE 6MM CONTINUOUS FILLET WELD UNLESS NOTED OTHERWISE.
9. GRADE OF STEEL FOR INSERT PLATE & LUGS SHALL BE ASTM A-36.

DOCUMENT NUMBER	REFERENCE DOCUMENTS	REV	DATE	REVISION DESCRIPTION	DRN	CHK	ENG	APP	EMP
MD-216-1000-EG-ST-CRT-1001	CIVIL, STRUCTURAL & ARCHITECTURAL - DESIGN CRITERIA								
				EMPLOYER COMMENTS ON 20/04/2020					
MD-216-3420-EG-ME-PLN-1001	3420-VSL-001 OKTOP AUTOCLAVE	A01	25/03/2020	ISSUED FOR REFERENCE	ABS	SJM	SOR	AG	
		D01	15/03/2023	AS-BUILT	ABS	SJM	SOR	AG	
		C03	12/08/2020	ISSUED FOR CONSTRUCTION & REVISED AS MARKED (3)	ABS	SJM	SOR	AG	
		C02	20/06/2020	ISSUED FOR CONSTRUCTION & REVISED AS MARKED (2)	ABS	SJM	SOR	AG	
		C01	23/04/2020	ISSUED FOR CONSTRUCTION & REVISED AS PER	ABS	SJM	SOR	AG	

RESERVED FOR VENDOR LOGO AND DRAWING NUMBER

This drawing is the property of LARSEN & TOUBRO and must not be passed on to any person or body not authorized by us to receive it nor be copied or otherwise made use either in full or in part by such person or body without our prior permission in writing.

The content of these documents are the sole property of Outotec Oyj. Any rights not expressly granted herein are reserved. Reproduction, transfer or distribution of part or all of the contents in any form without prior written permission of Outotec is prohibited.

This document and the information contained herein is Ma'aden proprietary know-how. This document or any part thereof should not be reproduced, stored in a retrieval system or transmitted by any means, electronic or otherwise, or divulged without prior written permission of Ma'aden.

LARSEN & TOUBRO DRAWING NUMBER: 019045_450_C_G_24980_001 — REVISION: 4
OUTOTEC DRAWING NUMBER: 900707__GAU01__HH12__MTL01__34223 — DOCUMENT ID: OU100671382 — REVISION: 4

DRAWN	ABS	13/01/2020
CHECKED	SJM	20/01/2020
ENGINEER	SOR	13/01/2020
APPROVED	AG	25/03/2020
EMPLOYER		
SCALE	1:100, 1:40, 1:30, 1:20	A0

MANSOURAH - MASSARAH GOLD PROJECT
GENERAL ARRANGEMENT DRAWING
PRESSURE OXIDATION-AUTOCL. FLASH V.&SCRUB.
G.A. & RCC. DETAILS OF FOUNDATION

DRAWING NUMBER: MD - 216 - 3420 - EG - CV - GAD - 1007
REV: D01