


DRAWING NUMBER: MD - 216 - 3420 - EG - CV - GAD - 1246
REV: D01

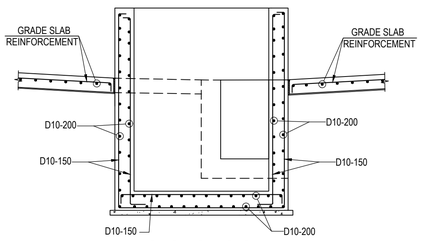


SECTION C-C
(RCC DETAIL)
SCALE 1:30

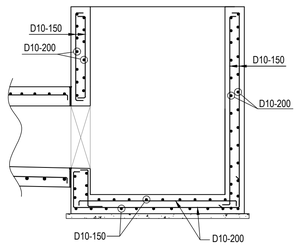


SECTION D-D
(RCC DETAIL)
SCALE 1:30

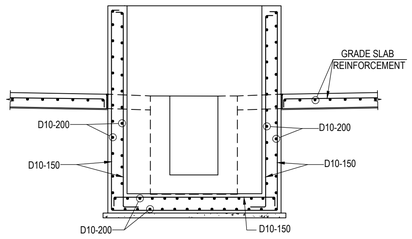


SECTION E-E
(RCC DETAIL)
SCALE 1:30

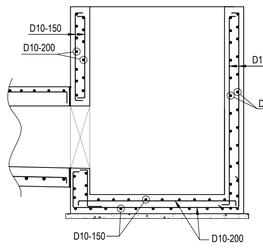


SECTION F-F
(RCC DETAIL)
SCALE 1:30

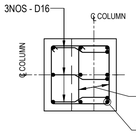


VIEW : M1-M1
SCALE 1:20

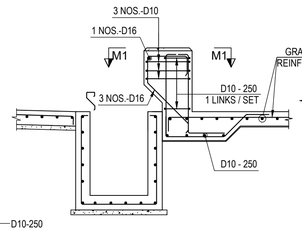


SECTION M-M, P-P
SECTION N-N (OPPOSITE HAND)
(RCC DETAIL)
SCALE 1:30

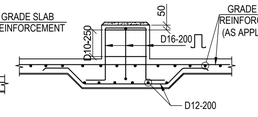


DETAIL OF P7,P8,P8A, P9
(RCC DETAIL)
SCALE 1:30

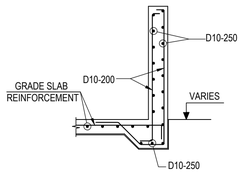


SECTION J-J
(RCC DETAIL)
SCALE 1:30

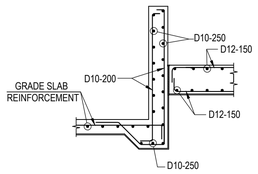


SECTION J1-J1 & K-K
(RCC DETAIL)
SCALE 1:30

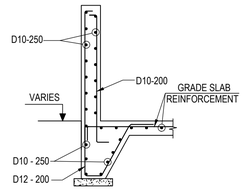


SECTION L-L
(RCC DETAIL)
SCALE 1:30

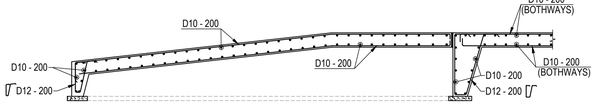


TYP DETAIL OF RAMP 1 & 2
(RCC DETAIL)
SCALE 1:50

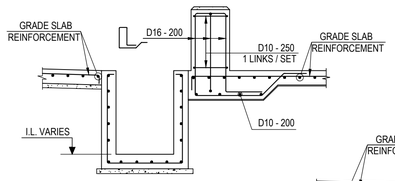


SECTION M2-M2
(RCC DETAIL)
SCALE 1:30

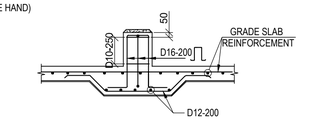


DETAIL OF P4, P5, P4A, P4B
(RCC DETAIL)
SCALE 1:30

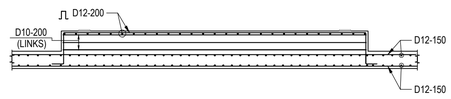


DETAIL OF P6
(RCC DETAIL)
SCALE 1:50

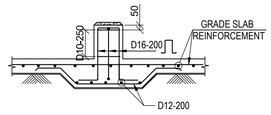


DETAIL OF P1,P1A,P1B,P2,P2A,P2B,P3, P3A,P3B,P3C, P3D,P3E
(RCC DETAIL)

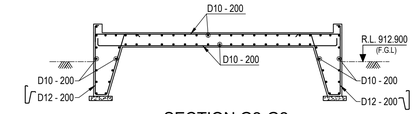


SECTION G2-G2
(RCC DETAIL)
SCALE 1:50

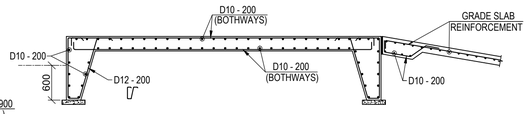


SECTION G1-G1
(RCC DETAIL)
SCALE 1:50

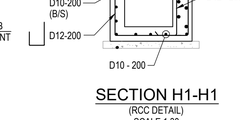


SECTION H1-H1
(RCC DETAIL)
SCALE 1:30

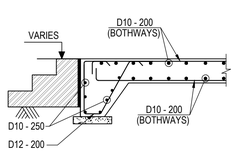


SECTION L1-L1
(RCC DETAIL)
SCALE 1:30

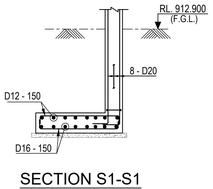


SECTION S1-S1
(SCALE-1:50)

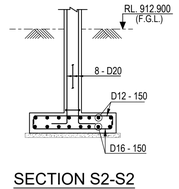


SECTION S2-S2
(SCALE-1:50)

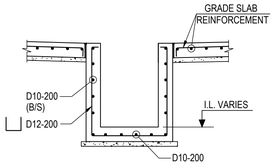


SECTION G-G & H-H
(RCC DETAIL)
SCALE 1:30

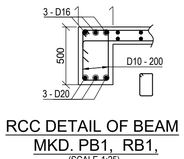


RCC DETAIL OF BEAM MKD. PB1, RB1,
(SCALE-1:25)

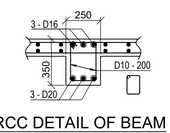


RCC DETAIL OF BEAM MKD. PB2, RB2,
(SCALE-1:25)

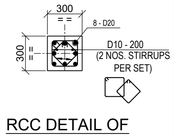

RCC DETAIL OF COLUMN MKD. C1
(SCALE 1:25)

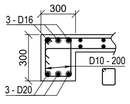


RCC DETAIL OF BEAM MKD. RB3
(SCALE-1:25)

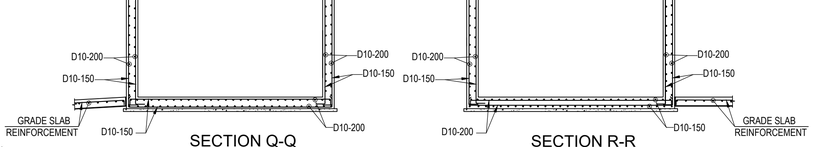


SECTION Q-Q
(RCC DETAIL)
SCALE 1:50


SECTION R-R
(RCC DETAIL)
SCALE 1:50

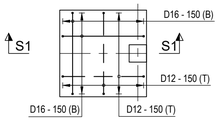


RCC DETAIL OF FDN. MKD. F3
(SCALE 1:50)

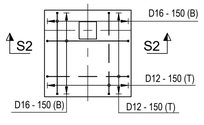

RCC DETAIL OF FDN. MKD. F4
(SCALE 1:50)

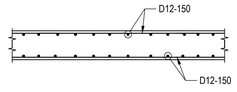


TYP. RCC DETAIL OF 300 THK. SLAB
SCALE 1:30

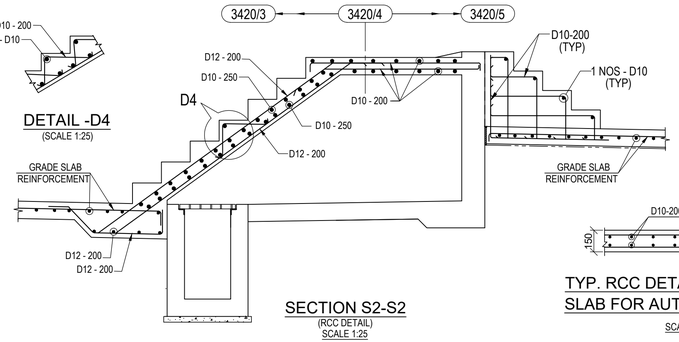


DETAIL -D4
(SCALE 1:25)


SECTION S2-S2
(RCC DETAIL)
SCALE 1:25

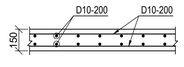


TYP. RCC DETAIL OF 150 THK. SLAB FOR AUTOCLAVE ROOM
SCALE 1:20

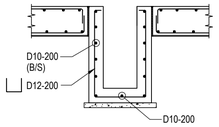


SECTION J2-J2 & J3-J3
(RCC DETAIL)
SCALE 1:30

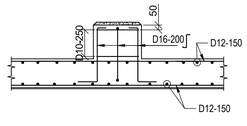


DETAIL OF P13 & P14
(RCC DETAIL)
SCALE 1:30

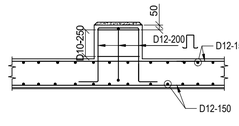

DETAIL OF P15, P16 & P18
(RCC DETAIL)
SCALE 1:30

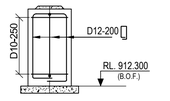

SECTION T-T
(RCC DETAIL)
SCALE 1:30

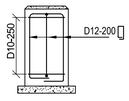

DETAIL OF P17
(RCC DETAIL)
SCALE 1:30

LEGEND :-

R.L - REDUCED LEVEL
T.O.C. - TOP OF CONCRETE.
F.G.L. - FINISHED GROUND LEVEL.
TYP. - TYPICAL.
P.C.C - PLAIN CEMENT CONCRETE
BOTTOM REINF.(B) - ———
TOP REINF.(T) - – – – – – –
MKD. - MARKED
℄ - CENTRE LINE
B.O.F. - BOTTOM OF FOUNDATION
THK. - THICK
FDN. - FOUNDATION
RCC - REINFORCED CEMENT CONCRETE
I.L - INVERT LEVEL
REINF.- REINFORCEMENT

NOTES:-

1. ALL DIMENSIONS ARE IN MILLIMETRES AND LEVELS AND CO-ORDINATES ARE IN METRES UNLESS OTHERWISE STATED.
2. FOR GENERAL ARRANGEMENT DRAWING REFER DRAWING NO. MD-216-3420-EG-CV-GAD-1245.
3. GRADE OF CONCRETE SHALL BE C35 (35MPa) FOR FOUNDATION & COLUMN.
4. GRADE OF REINFORCEMENT SHALL BE DEFORMED BAR ASTM A615 - GRADE 60 (fy = 420 MPa).
5. CLEAR COVER TO MAIN REINFORCEMENT SHALL BE AS
   a) FOUNDATION = 50 mm (BOTTOM & SIDE) 50 mm. (TOP)
   b) COLUMN = 50mm
6. IF ANY PART OF FOUNDATION COMES ON BACKFILL ZONE OF ADJACENT FOUNDATION OR ANY LOOSE SOIL ARE ENCOUNTERED BELOW FOUNDATION LEVEL THE SAME SHALL BE REMOVED AND FILLED WITH PCC.
7. FOR STANDARD REINFORCEMENT DETAIL & GENERAL NOTES FOR CIVIL WORKS REFER DRAWING NO. MD-216-1000-EG-CV-DED-1005 &1001.

DOCUMENT NUMBER	REFERENCE DOCUMENTS	REV	DATE	REVISION DESCRIPTION	DRN	CHK	ENG	APP	EMP
		D01	15/03/2023	AS-BUILT	PML	SJM	SOR	AG	
		C04	26/02/2021	ISSUED FOR CONSTRUCTION AND REVISED AS MARKED C04	PML	SJM	SOR	AG	
		C03	21/01/2021	ISSUED FOR CONSTRUCTION AND REVISED AS MARKED C03	PML	SJM	SOR	AG	
		C02	04/01/2021	ISSUED FOR CONSTRUCTION AND REVISED AS MARKED C02	PML	SJM	SOR	AG	
MD-216-3420-EG-ME-GAD-1011	PRESSURE OXIDATION - FEED STORAGE	C01	21/11/2020	ISSUED FOR CONSTRUCTION AND REVISED AS MARKED C01	PML	SJM	SOR	AG	
	PLAN AT EL. +912.900	A01	20/10/2020	ISSUED FOR REFERENCE	PML	SJM	SOR	AG	

RESERVED FOR VENDOR LOGO AND DRAWING NUMBER

LARSEN & TOUBRO

This drawing is the property of LARSEN & TOUBRO and must not be passed on to any person or body not authorized by us to receive it nor be copied or otherwise made use either in full or in part by such person or body without our prior permission in writing.

Outotec

The content of these documents are the sole property of Outotec Oyj. Any rights not expressly granted herein are reserved. Reproduction, transfer or distribution of part or all of the contents in any form without prior written permission of Outotec is prohibited.

MA'ADEN معادن
Saudi Arabian Mining Company شركة معادن العربية السعودية

This document and the information contained herein is Ma'aden proprietary know-how. This document or any part thereof should not be reproduced, stored in a retrieval system or transmitted by any means, electronic or otherwise, or divulged without prior written permission of Ma'aden.

LARSEN & TOUBRO DRAWING NUMBER: 019045_450_C_G_24566_002 — REVISION: 5
OUTOTEC DRAWING NUMBER: 900707 _GAU01 _HH12 _MTL01 _34251 — DOCUMENT ID: OU100704173 — REVISION: 5

DRAWN	PML	14/10/2020
CHECKED	SJM	16/10/2020
ENGINEER	SOR	14/10/2020
APPROVED	AG	20/10/2020
EMPLOYER		

MANSOURAH - MASSARAH GOLD PROJECT
GENERAL ARRANGEMENT DRAWING
PRESSURE OXIDATION - AUTOCLAVE BUILDING
RCC DETAILS OF GRADE SLAB

SCALE 1:30 — A1
DRAWING NUMBER: MD - 216 - 3420 - EG - CV - GAD - 1246 — REV: D01