


DRAWING NUMBER MD - 216 - 3420 - EG - CV - GAD - 2001 REV D01

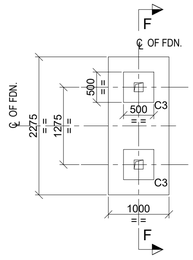


DETAILS OF FOUNDATION MKD. F3
SCALE 1:50

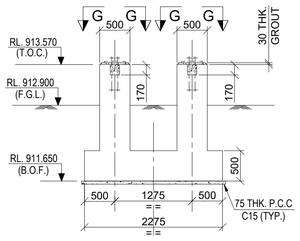


SECTION F-F
SCALE 1:50

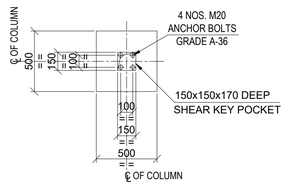


VIEW G-G
SCALE 1:25

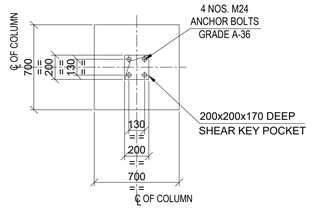


VIEW B-B
(FOR COLUMN MARKED C1A)
SCALE 1:25

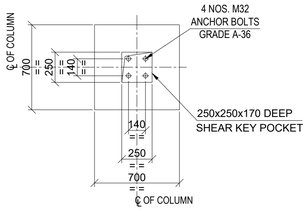


VIEW E-E
SCALE 1:25

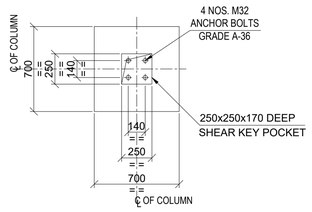


VIEW B-B
(FOR COLUMN MARKED C1)
SCALE 1:25

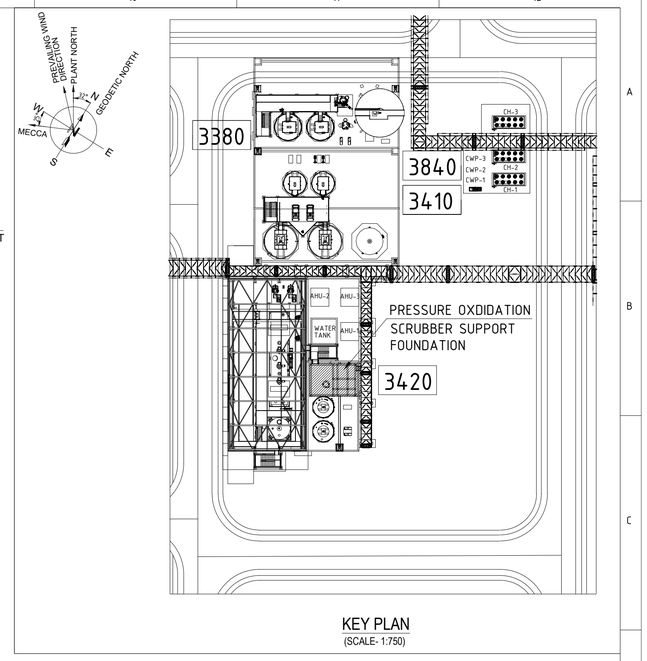


KEY PLAN
(SCALE- 1:750)

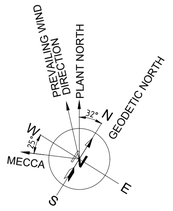


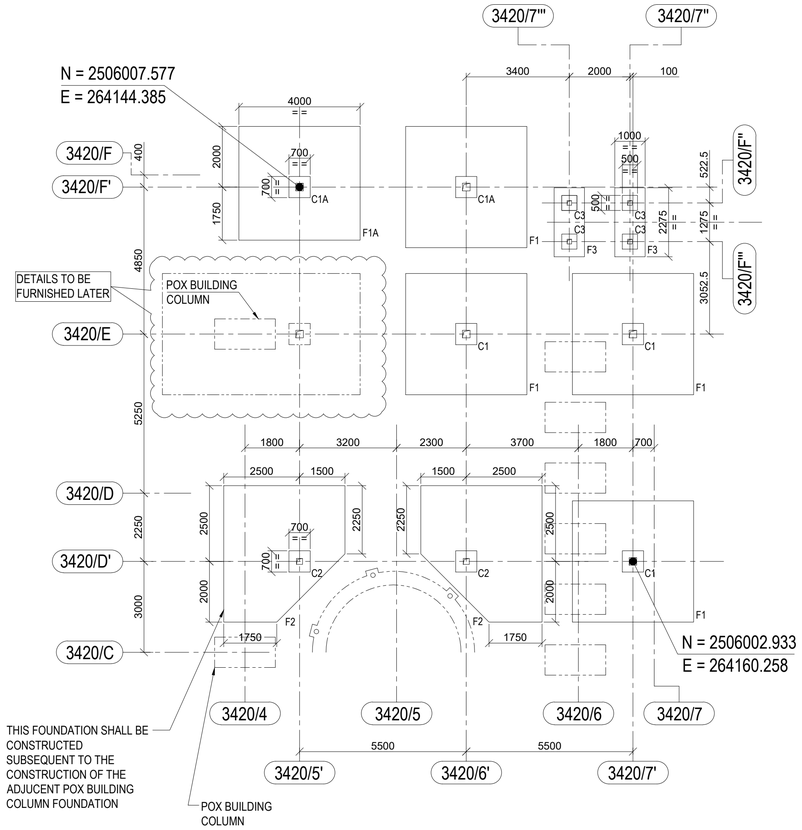


LAYOUT OF FOUNDATION
SCALE 1:100

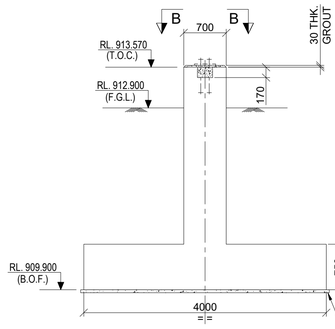


SECTION A-A
SCALE 1:50

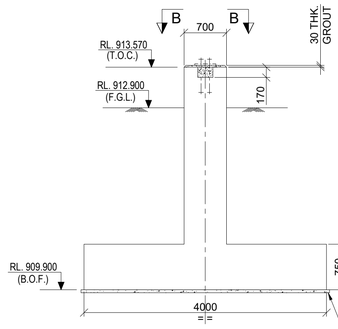


SECTION C-C
SCALE 1:50

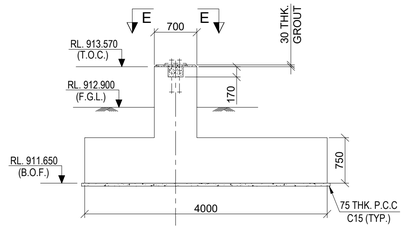


SECTION D-D
SCALE 1:50

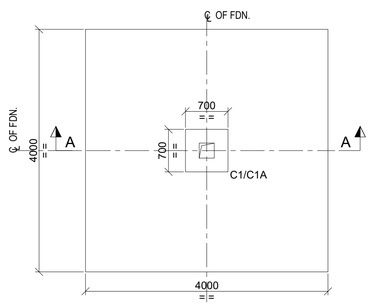

DETAILS OF FOUNDATION MKD. F1
SCALE 1:50

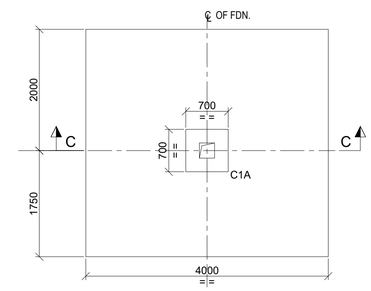

DETAILS OF FOUNDATION MKD. F1A
SCALE 1:50

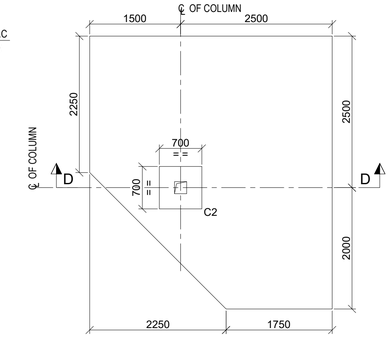

DETAILS OF FOUNDATION MKD. F2
SCALE 1:50

LEGEND :-

R.L. - REDUCED LEVEL
T.O.C. - TOP OF CONCRETE.
F.G.L. - FINISHED GROUND LEVEL.
TYP. - TYPICAL.
P.C.C - PLAIN CEMENT CONCRETE
℄ - CENTRE LINE
MKD. - MARKED
B.O.F. - BOTTOM OF FOUNDATION
THK. - THICK
FDN. - FOUNDATION
DIA - DIAMETER
OXDN. -OXIDATION
AUTOCL. - AUTOCLAVE
BLDG. - BUILDING

NOTES :-

1. ALL DIMENSIONS ARE IN MILLIMETRES AND LEVELS AND CO-ORDINATES ARE IN METRES. UNLESS OTHERWISE STATED.
2. GRADE OF CONCRETE SHALL BE C35 (35MPa) FOR FOUNDATION & COLUMN.
3. GRADE OF REINFORCEMENT SHALL BE DEFORMED BAR ASTM A615 - GRADE 60 (fy = 420 MPa).
4. NET SAFE BEARING CAPACITY OF SOIL AT BOTTOM OF FOUNDATION IS CONSIDERED AS 475KN/SQ.M. AT RL. 909.900 & 350KN/SQ.M. AT RL. 911.650.
5. IF ANY PART OF FOUNDATION COMES ON BACKFILL ZONE OF ADJACENT FOUNDATION OR ANY LOOSE SOIL ARE ENCOUNTERED BELOW FOUNDATION LEVEL THE SAME SHALL BE REMOVED AND FILLED WITH PCC.
6. FOR STANDARD DETAILS OF ANCHOR BOLTS REFER DRAWING NO. MD-216-1000-EG-CV-DED-1003.
7. FOR STANDARD REINFORCEMENT DETAIL & GENERAL NOTES FOR CIVIL WORKS REFER DRAWING NO. MD-216-1000-EG-CV-DED-1005 &1001.

DOCUMENT NUMBER	REFERENCE DOCUMENTS	REV	DATE	REVISION DESCRIPTION	DRN	CHK	ENG	APP	EMP
MD-216-3420-EG-ST-GAD-2239	PRESSURE OXIDATION SCRUBBER SUPPORT PLAN, ELEVATIONS & DETAILS								
MD-216-3420-EG-ST-GAD-2238	PRESSURE OXIDATION SCRUBBER SUPPORT PLAN, ELEVATIONS & DETAILS	D01	15/03/2023	AS-BUILT	PML	SJM	SOR	AG	
MD-216-3420-EG-ME-GAD-1013	PRESSURE OXIDATION - AUTOCLAVE PLAN AT EL. +912.900	C03	30/12/2020	ISSUED FOR CONSTRUCTION AND REVISED AS MARKED C03	SYA	SJM	SOR	AG	
MD-216-3420-EG-CV-GAD-1001	PRESSURE OXIDATION - AUTOCL. FLASH V. & SCRUBBER PLAN AT EL. +913.400	C02	18/07/2020	ISSUED FOR CONSTRUCTION AND REVISED AS MARKED C02	SYA	SJM	SOR	AG	
		C01	01/07/2020	ISSUED FOR CONSTRUCTION AND REVISED AS PER EMPLOYER COMMMENTS ON 24/06/2020	SYA	SJM	SOR	AG	
		A01	26/05/2020	ISSUED FOR REFERENCE	SYA	SJM	SOR	AG	

RESERVED FOR VENDOR LOGO AND DRAWING NUMBER

LARSEN & TOUBRO

This drawing is the property of *LARSEN & TOUBRO* and must not be passed on to any person or body not authorized by us to receive it nor be copied or otherwise made use either in full or in part by such person or body without our prior permission in writing.

Outotec

The content of these documents are the sole property of Outotec Oyj. Any rights not expressly granted herein are reserved. Reproduction, transfer or distribution of part or all of the contents in any form without prior written permission of Outotec is prohibited.

MA'ADEN معادن
Saudi Arabian Mining Company شركة معادن السعودية

This document and the information contained herein is Ma'aden proprietary know-how. This document or any part thereof should not be reproduced, stored in a retrieval system or transmitted by any means, electronic or otherwise, or divulged without prior written permission of Ma'aden.

LARSEN & TOUBRO DRAWING NUMBER		REVISION
019045_450_C_G_24982_001		4
OUTOTEC DRAWING NUMBER	DOCUMENT ID	REVISION
900707__GAU01__HH12__MTL01__34228	OU100685948	4

DRAWN	SYA	22/05/2020
CHECKED	SJM	25/05/2020
ENGINEER	SOR	22/05/2020
APPROVED	AG	26/05/2020
EMPLOYER		
SCALE 1:50, 1:10		A1

MANSOURAH - MASSARAH GOLD PROJECT
GENERAL ARRANGEMENT DRAWING
PRESSURE OXDN. - AUTOCL. BLDG.
GA & DETAILS OF SCRUBBER SUPPORT FOUNDATION

DRAWING NUMBER: MD - 216 - 3420 - EG - CV - GAD - 2001 REV: D01