


DRAWING NUMBER: MD-216-3420-EG-CV-GAD-2002 | REV: D01

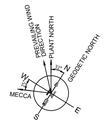


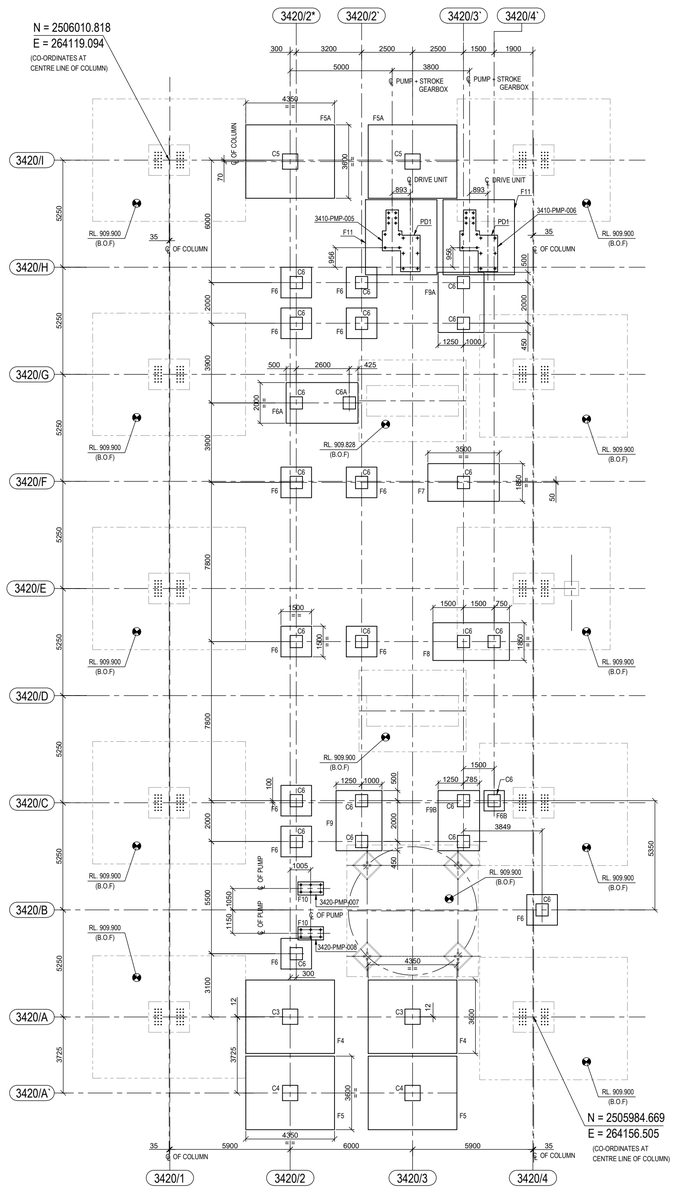


LAYOUT OF AUTOCLAVE BUILDING FOUNDATION
SCALE 1:100

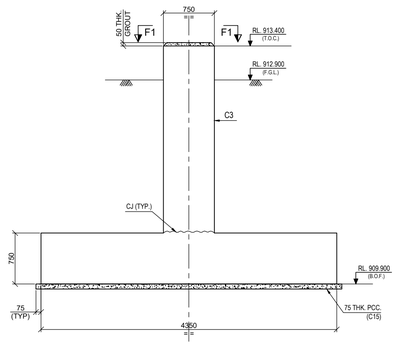


SECTION : F-F
SCALE 1:30

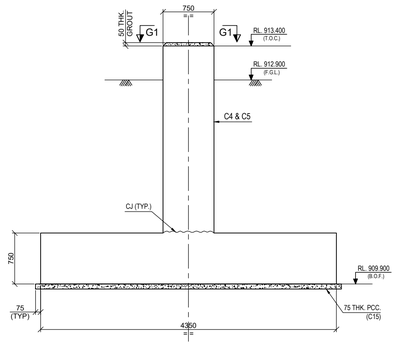


SECTION : G-G
SCALE 1:30

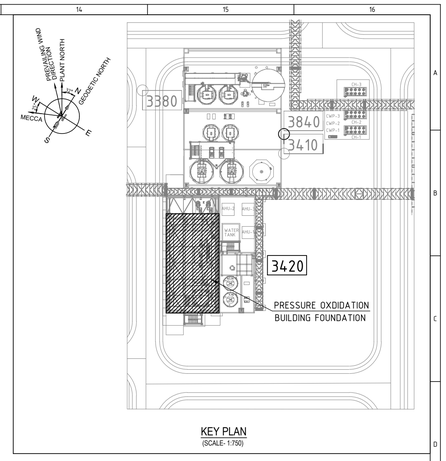


KEY PLAN
(SCALE: 1:750)

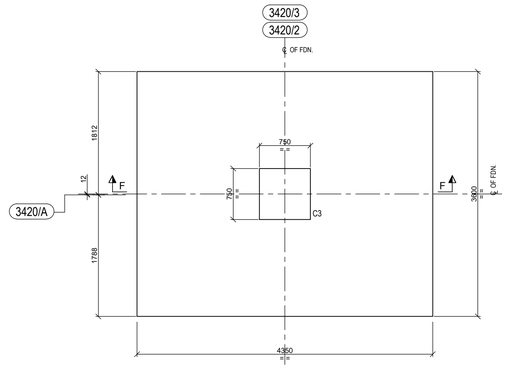

DETAILS OF FOUNDATION MKD. F4
(2 NOS. REQD.)
SCALE 1:30

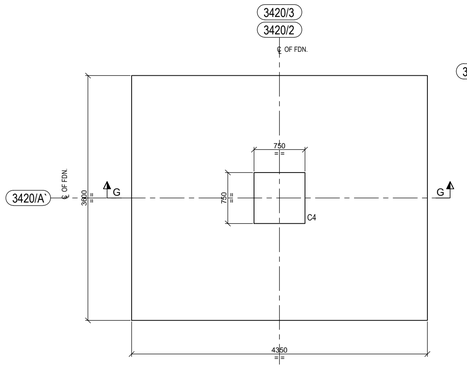


DETAILS OF FOUNDATION MKD. F5
(2 NOS. REQD.)
SCALE 1:30

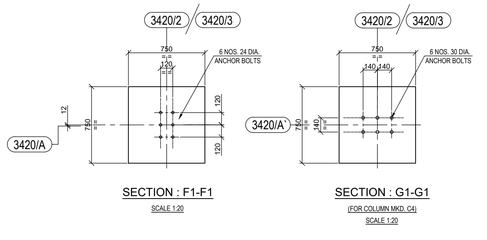


SECTION : F1-F1
SCALE 1:20


SECTION : G1-G1
(FOR COLUMN MKD. C4)
SCALE 1:20

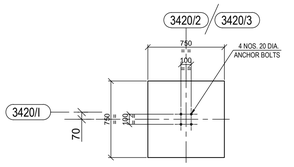

SECTION : G1-G1
(FOR COLUMN MKD. C5)
SCALE 1:20

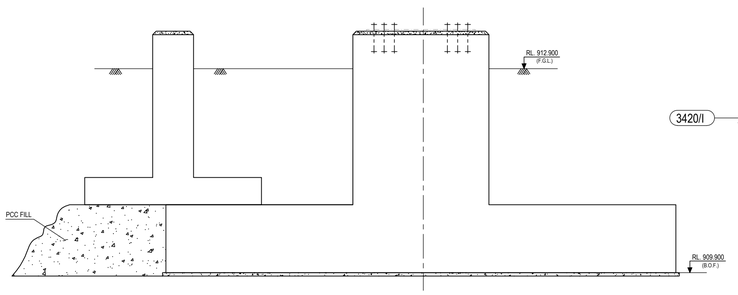

TYPICAL DETAIL OF OVERLAPPING FOUNDATIONS
SCALE 1:30

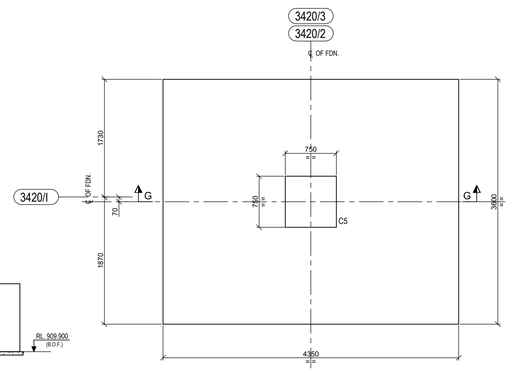

DETAILS OF FOUNDATION MKD. F5A
(2 NOS. REQD.)
SCALE 1:30

LEGEND :-

R.L - REDUCED LEVEL
T.O.C. - TOP OF CONCRETE.
F.G.L. - FINISHED GROUND LEVEL.
TYP. - TYPICAL.
P.C.C - PLAIN CEMENT CONCRETE
℄ - CENTRE LINE
MKD. - MARKED
B.O.F. - BOTTOM OF FOUNDATION
THK. - THICK
FDN. - FOUNDATION
DIA - DIAMETER
CJ - CONSTRUCTION JOINT
DET. - DETAIL
REQD. - REQUIRED
Ø - DIAMETER

NOTES :-

1. ALL DIMENSIONS ARE IN MILLIMETRES AND LEVELS AND CO-ORDINATES ARE IN METRES. UNLESS OTHERWISE STATED.
2. GRADE OF CONCRETE SHALL BE C35 (30MPa) FOR FOUNDATION & COLUMN.
3. GRADE OF REINFORCEMENT SHALL BE DEFORMED BAR ASTM A615 - GRADE 60 (fy = 420 MPa).
4. NET SAFE BEARING CAPACITY OF SOIL AT BOTTOM OF FOUNDATION IS CONSIDERED AS 475KN/SQ.M. AT RL. 909.900.
5. IF ANY PART OF FOUNDATION COMES ON BACKFILL ZONE OF ADJACENT FOUNDATION OR ANY LOOSE SOIL ARE ENCOUNTERED BELOW FOUNDATION LEVEL THE SAME SHALL BE REMOVED AND FILLED WITH PCC.
6. FOR DETAILS OF ANCHOR BOLTS REFER DRAWING NO. MD-216-3420-EG-ST-GAD-2229.
7. FOR STANDARD REINFORCEMENT DETAIL & GENERAL NOTES FOR CIVIL WORKS REFER DRAWING NO. MD-216-1000-EG-CV-DED-1005 &1001.

DOCUMENT NUMBER	REFERENCE DOCUMENTS	REV	DATE	REVISION DESCRIPTION	DRN	CHK	ENG	APP	EMP
MD-216-3420-EG-ST-GAD-2230	PRESSURE OXIDATION – AUTOCLAVE BUILDINGS COLUMN REACTIONS								
MD-216-3420-EG-ST-GAD-2229	PRESSURE OXIDATION – AUTOCLAVE BUILDINGS ANCHOR BOLT PLAN & DETAILS	D01	15/03/2023	AS-BUILT	PML	SJM	SOR	AG	
		C02	02/11/2020	ISSUED FOR CONSTRUCTION & REVISED AS MARKED 4	PML	SJM	SOR	AG	
MD-216-3420-EG-ME-GAD-1013	PRESSURE OXIDATION – AUTOCLAVE PLAN AT EL. +912.900	C01	01/10/2020	ISSUED FOR CONSTRUCTION & REVISED AS MARKED 4	PML	SJM	SOR	AG	
		A01	11/09/2020	ISSUED FOR REFERENCE	PML	SJM	SOR	AG	

RESERVED FOR VENDOR LOGO AND DRAWING NUMBER

LARSEN & TOUBRO

This drawing is the property of LARSEN & TOUBRO and must not be passed on to any person or body not authorized by us to receive it nor be copied or otherwise made use either in full or in part by such person or body without our prior permission in writing.

Outotec

The content of these documents are the sole property of Outotec Oyj. Any rights not expressly granted herein are reserved. Reproduction, transfer or distribution of part or all of the contents in any form without prior written permission of Outotec is prohibited.

MA'ADEN معادن Saudi Arabian Mining Company

This document and the information contained herein is Ma'aden proprietary know-how. This document or any part thereof should not be reproduced, stored in a retrieval system or transmitted by any means, electronic or otherwise, or divulged without prior written permission of Ma'aden.

LARSEN & TOUBRO DRAWING NUMBER	019045_450_C_G_24985_001
REVISION	3
OUTOTEC DRAWING NUMBER	900707__GAU01__HH12__MTL01__34237
DOCUMENT ID	OU100688024
REVISION	3
DRAWN	PML 07/09/2020
CHECKED	SJM 09/09/2020
ENGINEER	SOR 07/09/2020
APPROVED	AG 11/09/2020
EMPLOYER	
SCALE	1:100, 1:50, 1:25
	A0

MANSOURAH - MASSARAH GOLD PROJECT
GENERAL ARRANGEMENT DRAWING
PRESSURE OXIDATION - AUTOCLAVE BUILDING
GA & DETAILS OF FOUNDATION

DRAWING NUMBER: MD - 216 - 3420 - EG - CV - GAD - 2002
REV: D01