
DRAWING NUMBER: MD-216-1000-EG-CV-DED-1002 | REV: D01


TYPICAL CONCRETE PAVING AREA

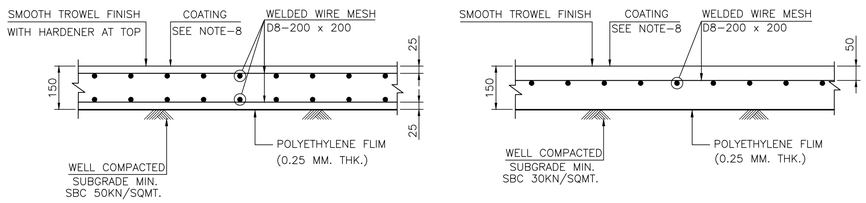

HEAVY DUTY
(FLOOR LOAD 15KN/SQM. TO 50KN/SQM.)
SCALE-1:10


LIGHT DUTY
(FLOOR LOAD UPTO 15KN/SQM.)
SCALE-1:10

GRAVEL PAVING DEAILS

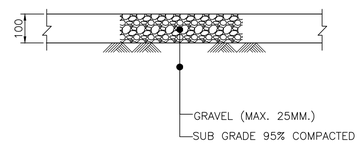


GRAVEL PAVING
SCALE-1:10


JOINT PLAN (CONCRETE PAVING AREA)

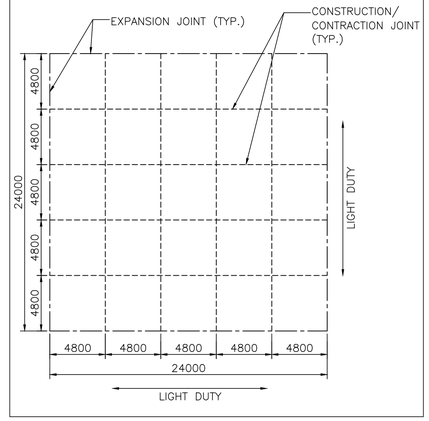


JOINT DETAILS FOR PAVING

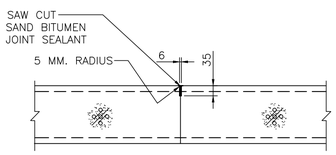


CONSTRUCTION / CONTRACTION JOINT
SCALE-1:10

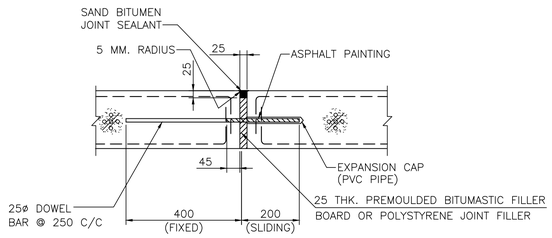

EXPANSION JOINT (HEAVY DUTY)
SCALE-1:10

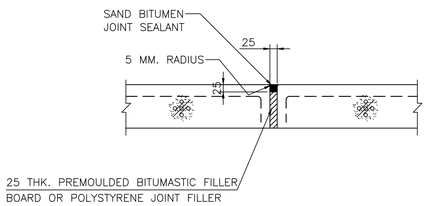


EXPANSION JOINT (LIGHT DUTY)
SCALE-1:10

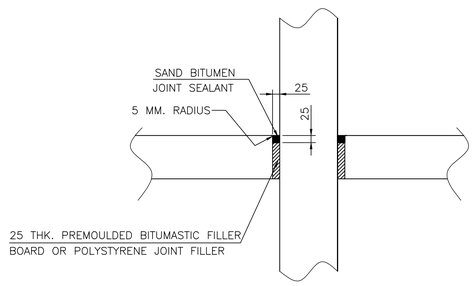


DETAIL OF ISOLATION GAP
SCALE-1:10

CONCRETE TILED PAVING

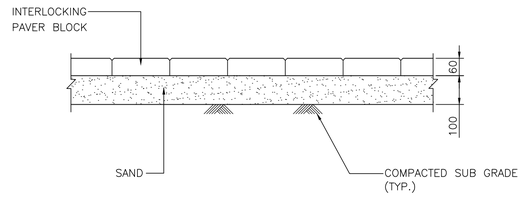

JOINT PLAN (CONCRETE PAVING AREA)

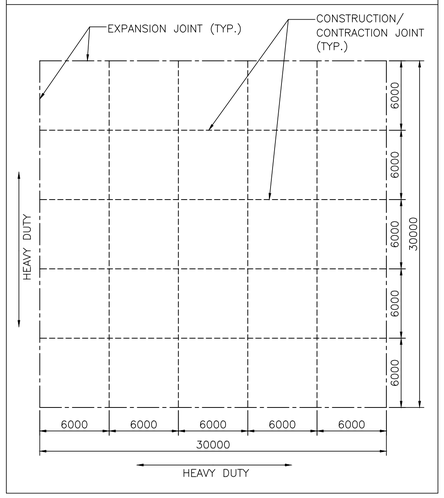

LEGEND:-

TYP. - TYPICAL
THK. - THICKNESS

NOTES:-

1. ALL DIMENSIONS ARE IN MILLIMETRES.
2. WELDED WIRE MESH SHALL BE GRADE 60 (fy=420 MPa) ACCORDING TO ASTM A1064.
3. EXTERNAL EXPOSED CORNERS TO BE CHAMFERED (25 X 25).
4. JOINT FILLER SHALL CONFORM TO ASTM D994 OR ASTM D1751.
5. GRADE OF CONCRETE SHALL BE 30 MPa FOR GRADE SLAB.
6. FLOORING DRAWINGS SHALL BE READ IN CONJUNCTION WITH BUILDING AND EQUIPMENT FOUNDATION GENERAL ARRANGEMENT DRAWINGS.
7. CONDUITS, EMBEDMENTS AND UNDERGROUND SERVICE LINES SHOWN IN THE EQUIPMENT FOUNDATION GENERAL ARRANGEMENT DRAWINGS BUT TO BE LAID UNDER/ WITHIN FLOOR SLAB SHALL BE INSTALLED BEFORE CONSTRUCTION TO THE FLOOR.
8. COATING IF REQUIRED AND AS INDICATED IN RESPECTIVE UNIT-WISE DRAWINGS OVER HARDENED FLOOR (SMOOTH TROWEL FINISH).

DOCUMENT NUMBER	REFERENCE DOCUMENTS	REV	DATE	REVISION DESCRIPTION	DRN	CHK	ENG	APP	EMP
		D01	15/03/2023	AS-BUILT	SYA	SJM	AVG	AG	
		C01	26/06/2020	ISSUED FOR CONSTRUCTION	SYA	SJM	AVG	AG	
		A02	29/05/2020	REVISED AS PER EMPLOYER COMMENTS ON 20/04/2020	SYA	SJM	AVG	AG	
MD-216-1000-EG-CV-CAL-1001	DESIGN CALCULATION GRADE SLAB DESIGN OF HEAVY DUTY GRADE SLAB	A01	19/03/2020	ISSUED FOR REFERENCE	SYA	SJM	AVG	AG	

RESERVED FOR VENDOR LOGO AND DRAWING NUMBER

LARSEN & TOUBRO

This drawing is the property of LARSEN & TOUBRO and must not be passed on to any person or body not authorized by us to receive it nor be copied or otherwise made use either in full or in part by such person or body without our prior permission in writing.

Outotec

The content of these documents are the sole property of Outotec Oyj. Any rights not expressly granted herein are reserved. Reproduction, transfer or distribution of part or all of the contents in any form without prior written permission of Outotec is prohibited.

MA'ADEN معادن
Saudi Arabian Mining Company شركة التعدين العربية السعودية

This document and the information contained herein is Ma'aden proprietary know-how. This document or any part thereof should not be reproduced, stored in a retrieval system or transmitted by any means, electronic or otherwise, or divulged without prior written permission of Ma'aden.

LARSEN & TOUBRO DRAWING NUMBER: 019045_900_C_D_24351_001 | REVISION: 3
OUTOTEC DRAWING NUMBER: 900707__GAU01__ZZ01__CTB17__10002 | DOCUMENT ID: OU100666797 | REVISION: 3

DRAWN	SYA	17/03/2020
CHECKED	SJM	18/03/2020
ENGINEER	AVG	17/03/2020
APPROVED	AG	19/03/2020
EMPLOYER		
SCALE	N.T.S	A1

MANSOURAH - MASSARAH GOLD PROJECT
DETAIL DRAWING
GRADE SLAB
STANDARD DETAILS FOR PAVING

DRAWING NUMBER: MD-216-1000-EG-CV-DED-1002 | REV: D01