




DETAIL 1 KERB ANGLE
FOR ANGLES 100x100 AND LESS

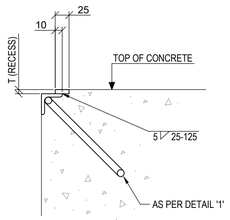


DETAIL 2 KERB ANGLE WITH RECESS
FOR ANGLES 100x100 AND LESS

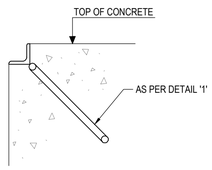


DETAIL 3 KERB ANGLE
FOR ANGLES 100x100 AND LESS

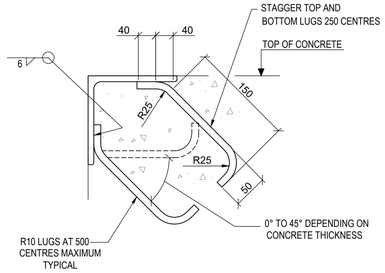


DETAIL 4 LARGE KERB ANGLE
FOR ANGLES 125x125 AND GREATER

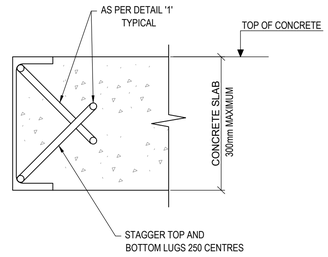

DETAIL 5 CHANNEL KERB

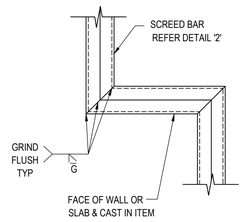


TYPICAL PLAN FOR DETAIL '2'
PLAN FOR DETAILS 1, 3, 4 & 5 SIMILAR

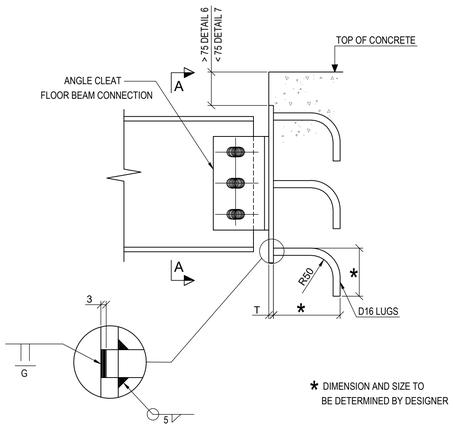

* DIMENSION AND SIZE TO BE DETERMINED BY DESIGNER

DETAIL 6 BEAM CONNECTION
DETAIL 7 AS NOTED

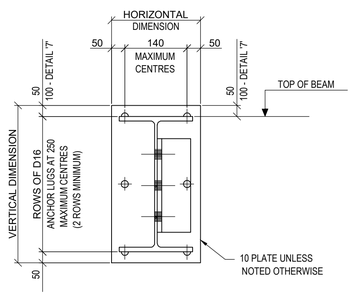

SECTION A-A

NOTE
1. WHERE PLATES OVERLAP THEY SHALL BE COMBINED AS ONE WITH ANCHOR LUGS SPACED ACROSS THE PLATE AT 140 MAXIMUM CENTRES WITH 50 EDGE DISTANCE.

NOTES:-
1. ALL DIMENSIONS ARE IN MILLIMETRES UNLESS OTHERWISE STATED.
2. ALL STEEL SHALL CONFORM TO ASTM A36.
3. THE CONTENTS OF THIS DRAWING SHALL CONFORM TO PROVISION OF DOCUMENT # MD-216-1000-EG-ST-CRT-1001.

DOCUMENT NUMBER	REFERENCE DOCUMENTS	REV	DATE	REVISION DESCRIPTION	DRN	CHK	ENG	APP	EMP
		D01	15/03/2023	AS-BUILT	ARU	SJM	SOR	AG	
MD-216-1000-EG-ST-CRT-1001	CIVIL, STRUCTURAL & ARCHITECTURAL DESIGN CRITERIA	C01	07/03/2020	ISSUED FOR CONSTRUCTION	ARU	SJM	SOR	AG	
MD-101-SMEM-EG-ST-DST-006	STRUCTURAL STANDARDS CAST-IN ITEM DETAILS	A01	30/12/2019	ISSUED FOR INFORMATION	ARU	SJM	AVG	AG	

RESERVED FOR VENDOR LOGO AND DRAWING NUMBER

LARSEN & TOUBRO DRAWING NUMBER: 019045_900_C_D_24353_001 — REVISION: 2

OUTOTEC DRAWING NUMBER: 900707__GAU01__ZZ01__CTB17__10004 — DOCUMENT ID: OU100666799 — REVISION: 2

LARSEN & TOUBRO
This drawing is the property of LARSEN & TOUBRO and must not be passed on to any person or body not authorized by us to receive it nor be copied or otherwise made use either in full or in part by such person or body without our prior permission in writing.

Outotec
The content of these documents are the sole property of Outotec Oyj. Any rights not expressly granted herein are reserved. Reproduction, transfer or distribution of part or all of the contents in any form without prior written permission of Outotec is prohibited.

MA'ADEN معادن
Saudi Arabian Mining Company شركة التعدين العربية السعودية
This document and the information contained herein is Ma'aden proprietary know-how. This document or any part thereof should not be reproduced, stored in a retrieval system or transmitted by any means, electronic or otherwise, or divulged without prior written permission of Ma'aden.

DRAWN	ARU	23/12/2019
CHECKED	SJM	24/12/2019
ENGINEER	AVG	26/12/2019
APPROVED	AG	27/12/2019
EMPLOYER		
SCALE	1:100	A1

MANSOURAH - MASSARAH GOLD PROJECT
DETAIL DRAWING
EMBEDDED PARTS
STANDARD DETAILS

DRAWING NUMBER: MD-216-1000-EG-CV-DED-1004 — REV: D01