DRAWING NUMBER MD-216-1000-EG-CV-GAD-1004 REV D01

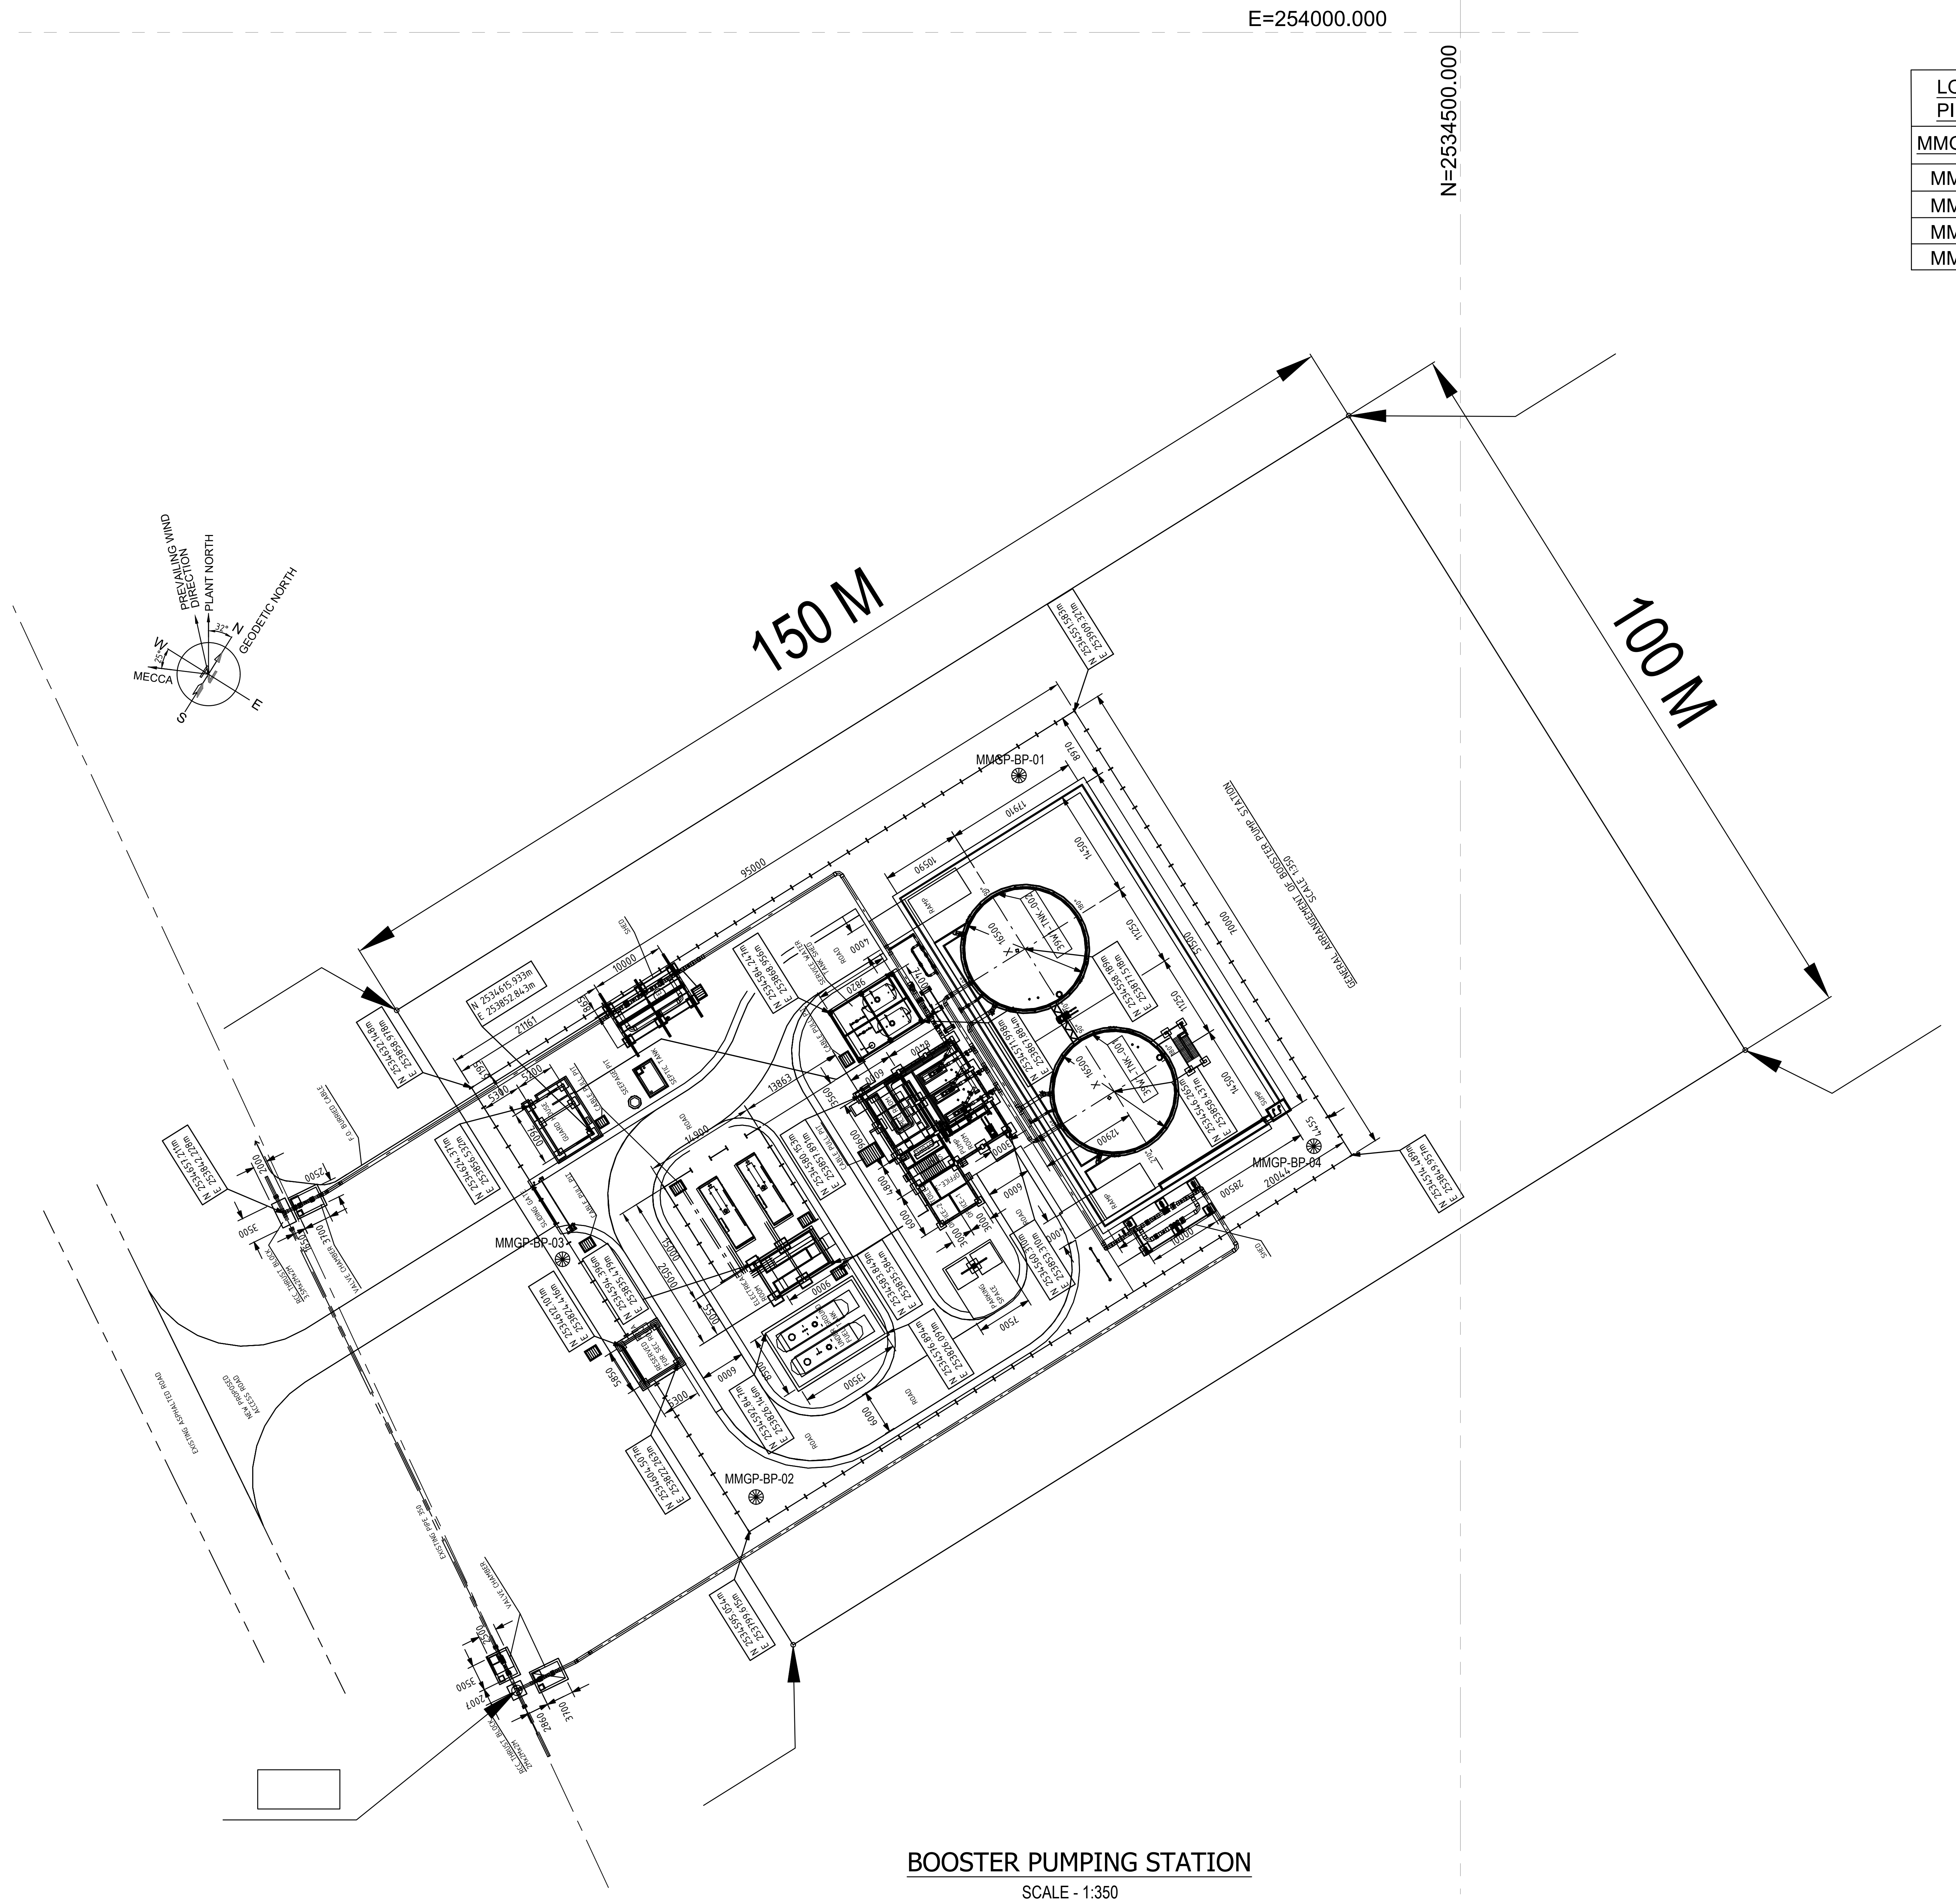

BOOSTER PUMPING STATION

SCALE - 1:350

LOCATIONS OF BENCH MARK SURVEY PILLARS FOR BOOSTER PUMP STATION

MMGP-BP MKD.	N - CORD.	E - CORD.
MMGP-BP-01	2534559.008	253900.687
MMGP-BP-02	2534594.129	253804.255
MMGP-BP-03	2534619.992	253836.025
MMGP-BP-04	2534519.609	253851.134

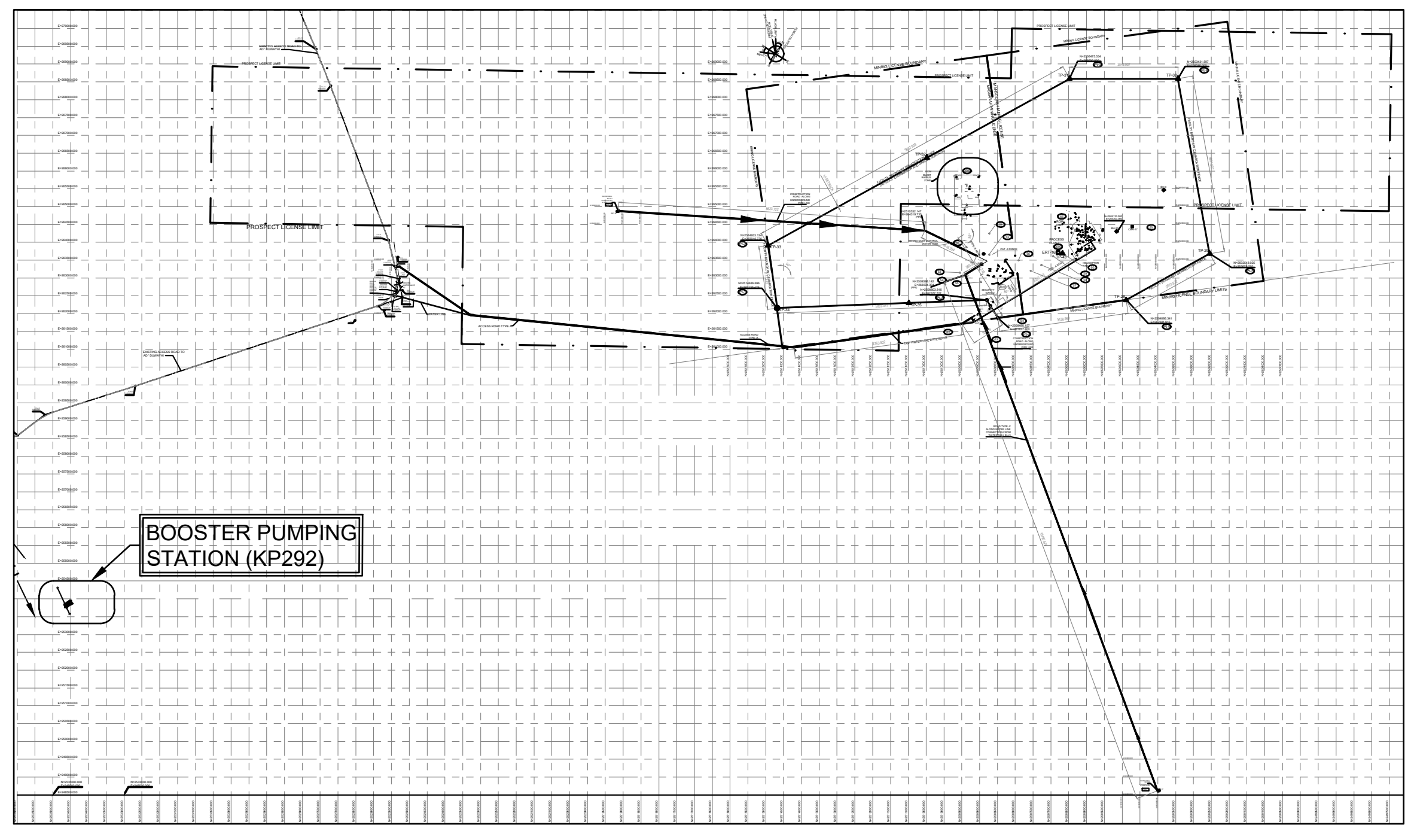

KEY PLAN

1:200000

LEGEND:-

✳ MMGP-BP - BENCH MARK SURVEY PILLARS FOR BOOSTER PUMP STATION

NOTES:-
1. ALL DIMENSIONS ARE IN METRE.
2. ALL CO ORDINATES ARE IN METRE.
3. THIS DRAWING SHALL BE READ IN CONJUNCTION WITH DRAWING NO. MD-216-1000-EG-CV-LAD-1001.

DOCUMENT NUMBER	REFERENCE DOCUMENTS	REV	DATE	REVISION DESCRIPTION	DRN	CHK	ENG	APP	EMP
		D01	15/03/2023	AS-BUILT	SYA	SJM	MLI	AG	
		C01	30/09/2020	ISSUED FOR CONSTRUCTION AND REVISED AS PER EMPLOYER'S COMMENT ON 23/09/2020	SYA	SJM	MLI	AG	
		A01	19/08/2020	ISSUED FOR REFERENCE	SYA	SJM	MLI	AG	

RESERVED FOR VENDOR LOGO AND DRAWING NUMBER

LARSEN & TOUBRO

This drawing is the property of LARSEN & TOUBRO and must not be passed on to any person or body not authorized by us to receive it nor be copied or otherwise made use either in full or in part by such person or body without our prior permission in writing.

Outotec

The content of these documents are the sole property of Outotec Oyj. Any rights not expressly granted herein are reserved. Reproduction, transfer or distribution of part or all of the contents in any form without prior written permission of Outotec is prohibited.

MA'ADEN معادن
Saudi Arabian Mining Company شركة التعدين العربية السعودية

This document and the information contained herein is Ma'aden proprietary know-how. This document or any part thereof should not be reproduced, stored in a retrieval system or transmitted by any means, electronic or otherwise, or divulged without prior written permission of Ma'aden.

LARSEN & TOUBRO DRAWING NUMBER	019045_900_C_G_24406_004	REVISION 2
OUTOTEC DRAWING NUMBER	900707_GAU01_ZZ01_MTL01_10011	
DOCUMENT ID	0U100688073	REVISION 2

DRAWN	SYA	17/08/2020
CHECKED	SJM	18/08/2020
ENGINEER	MLI	17/08/2020
APPROVED	AG	19/08/2020
EMPLOYER		
SCALE	1:350	A1

MANSOURAH - MASSARAH GOLD PROJECT
GENERAL ARRANGEMENT DRAWING
BENCHMARK SURVEY PILLAR LOCATION FOR BOOSTER PUMP STATION-KP292
SITE PLAN

DRAWING NUMBER MD-216-1000-EG-CV-GAD-1004
REV D01