

DRAWING NUMBER: MD-216-1000-EG-CV-GAD-1010 | REV: D01

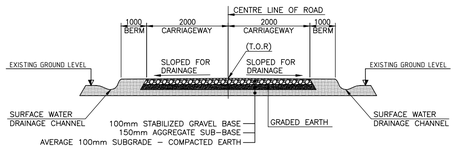


TYPICAL CROSS SECTION - GRADED ROAD SINGLE LANE EARTH

(NOT TO SCALE)

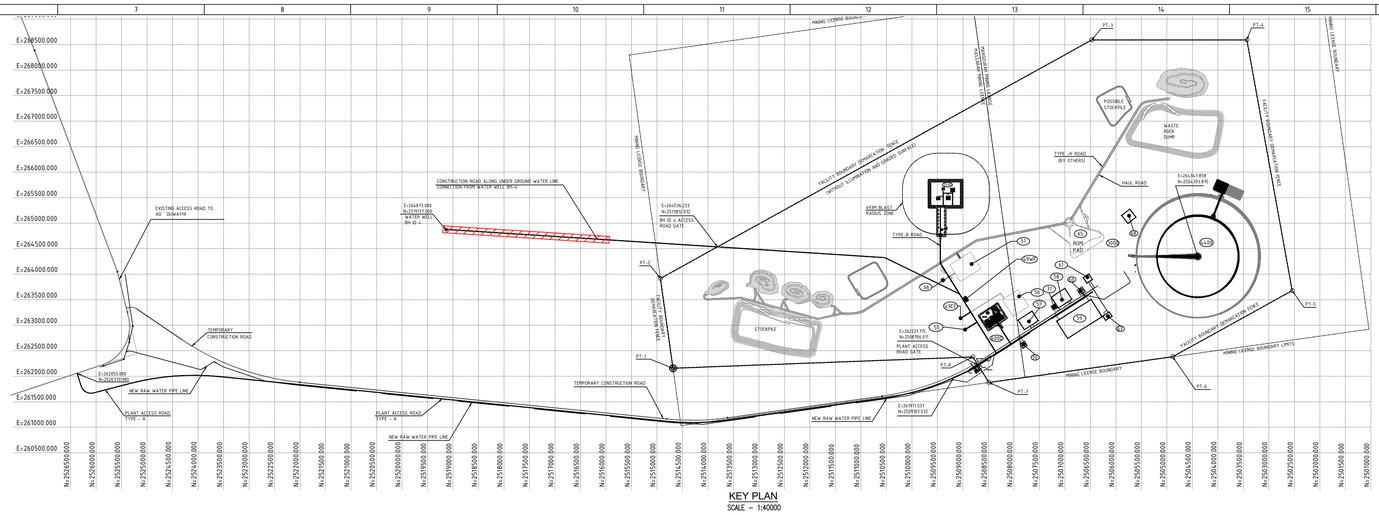


KEY PLAN

SCALE - 1:40000

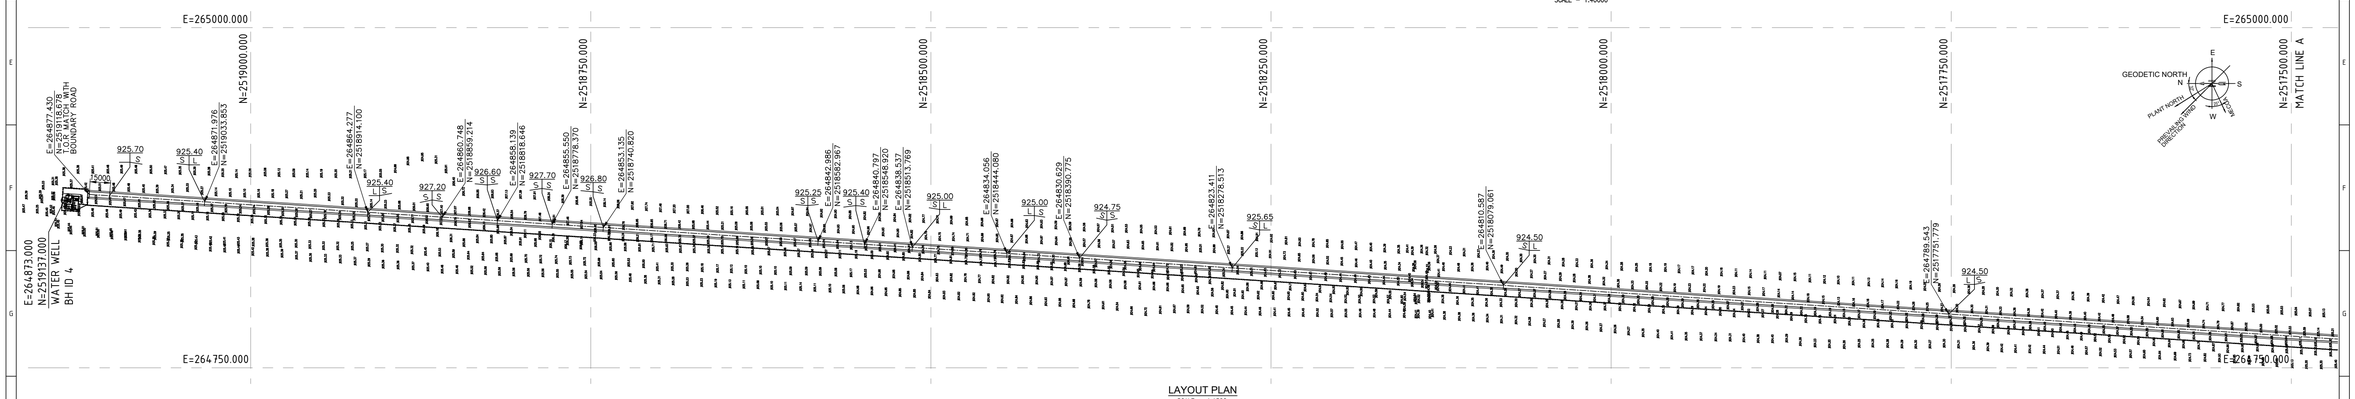

LAYOUT PLAN

SCALE - 1:1500

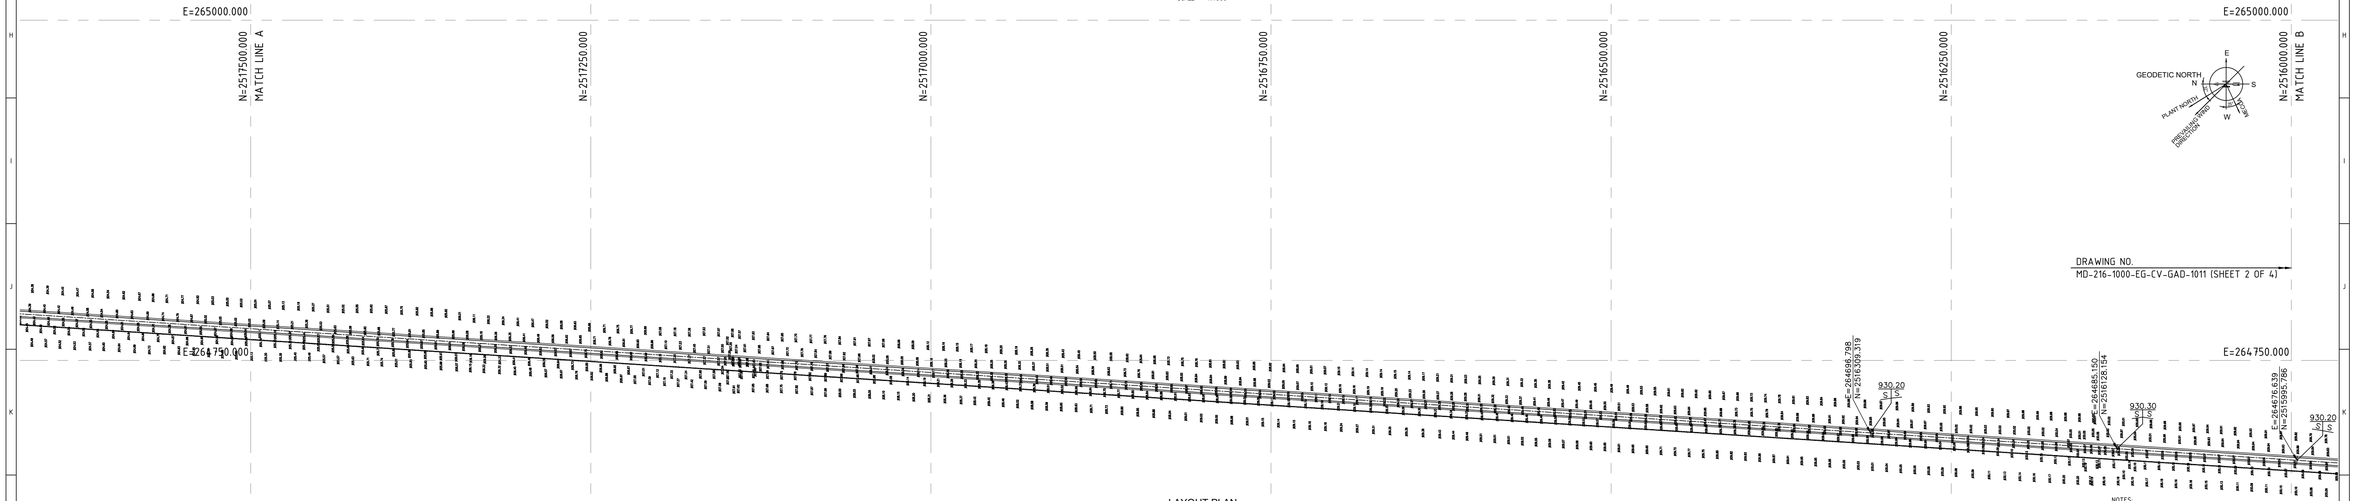

DRAWING NO.
MD-216-1000-EG-CV-GAD-1011 (SHEET 2 OF 4)

LAYOUT PLAN

SCALE - 1:1500

NOTES:
1. ALL DIMENSIONS ARE IN MILLIMETRES.
2. CO-ORDINATES AND LEVELS ARE IN METRES.
3. TOP OF ROAD (T.O.R). LEVEL SHOWN THUS..... 930.5 S L S
4. INSIDE RADIUS OF CURVATURE OF ROAD SHOWN THUS.....10R, INDICATES RADIUS = 10M.
5. SYMBOL USED AS:- 'S' = SLOPE AND 'L' = LEVEL.

DOCUMENT NUMBER	REFERENCE DOCUMENTS	REV	DATE	REVISION DESCRIPTION	DRN	CHK	ENG	APP	EMP
MD-216-1000-EG-CV-GAD-1013	ROAD LAYOUT-PLAN & SECTION (SHEET 4 OF 4)	D01	15/03/2023	AS-BUILT	APEX	MLI	APEX	SJM	
MD-216-1000-EG-CV-GAD-1012	ROAD LAYOUT-PLAN & SECTION (SHEET 3 OF 4)	C01	05/03/2021	ISSUED FOR CONSTRUCTION	APEX	MLI	APEX	SJM	
MD-216-1000-EG-CV-GAD-1011	ROAD LAYOUT-PLAN & SECTION (SHEET 2 OF 4)	A01	08/02/2021	ISSUED FOR REVIEW	APEX	MLI	APEX	SJM	

RESERVER FOR VENDOR LOGO AND DRAWING NUMBER

This drawing is the property of LARSEN & TOUBRO and must not be passed on to any person or body not authorized by us to receive it nor be copied or otherwise made use either in full or in part by such person or body without our prior permission in writing.

The content of these documents are the sole property of Outotec Oyj. Any rights not expressly granted herein are reserved. Reproduction, transfer or distribution of part or all of the contents in any form without prior written permission of Outotec is prohibited.

This document and the information contained herein is Ma'aden proprietary know-how. This document or any part thereof should not be reproduced, stored in a retrieval system or transmitted by any means, electronic or otherwise, or divulged without prior written permission of Ma'aden.

LARSEN & TOUBRO DRAWING NUMBER	019045_900_C_G_24599_001
REVISION	2
OUTOTEC DRAWING NUMBER	900707__GAU01__ZZ01__MTL01__10013
DOCUMENT ID	OU100712480
REVISION	2
DRAWN	APEX 04/02/2021
CHECKED	MLI 06/02/2021
ENGINEER	APEX 04/02/2021
APPROVED	SJM 08/02/2021
EMPLOYER	
SCALE	1:50, 1:1500
PAPER SIZE	A0

MANSOURAH - MASSARAH GOLD PROJECT

GENERAL ARRANGEMENT DRAWING

BORE WELL BH-4 TO PROCESS PLANT

ROAD LAYOUT-PLAN & SECTION (SHEET 1 OF 4)

DRAWING NUMBER: MD-216-1000-EG-CV-GAD-1010 | REV: D01