MA'ADEN معادن

Saudi Arabian Mining Company شركة التعدين العربية السعودية

Project **Mansourah Massarah Gold Project**

Customer: **MA'ADEN GOLD AND BASE METALS (MA'ADEN)**

Title: **GENERAL ARRANGEMENT DRAWING**
RAW WATER
LAYOUT & DETAIL OF GRADE SLAB


Document Number: **MD-216-39WL-EG-CV-GAD-1719**
Revision: **D01**
Revision Date: **09.03.2023**
Status: **AS BUILT**

Outotec Document Number:	900707	GAU01	AG11	MTL01	39252	OU100714972	6
L&T Document Number:	O19045	080	C	G	24588	001	6

REVISION HISTORY

Rev	Date	Revision Text	Prepared By	Reviewed By	Approved By	Employer
A01	15.02.2021	ISSUED FOR APPROVAL	AMJ	SJM	AG	
C01	08.04..2021	ISSUED FOR CONSTRUCTION & REVISED AS MKD. C01	AMJ	SJM	AG	
C02	04.09.2021	ISSUED FOR CONSTRUCTION & REVISED AS MKD. C02	PML	SJM	AG	
C03	30.09.2021	ISSUED FOR CONSTRUCTION & REVISED AS MKD. C03	SYA	SJM	AG	
C04	05.01.2022	ISSUED FOR CONSTRUCTION & REVISED AS MKD. C04	SYA	SJM	AG	
C05	21.02.2022	ISSUED FOR CONSTRUCTION & REVISED AS MKD. C05	SYA	SJM	AG	
D01	09.03.2023	AS BUILT	SYA	SJM	AG	

DRAWING NUMBER MD-216-39WL-EG-CV-GAD-1719 D01 REV

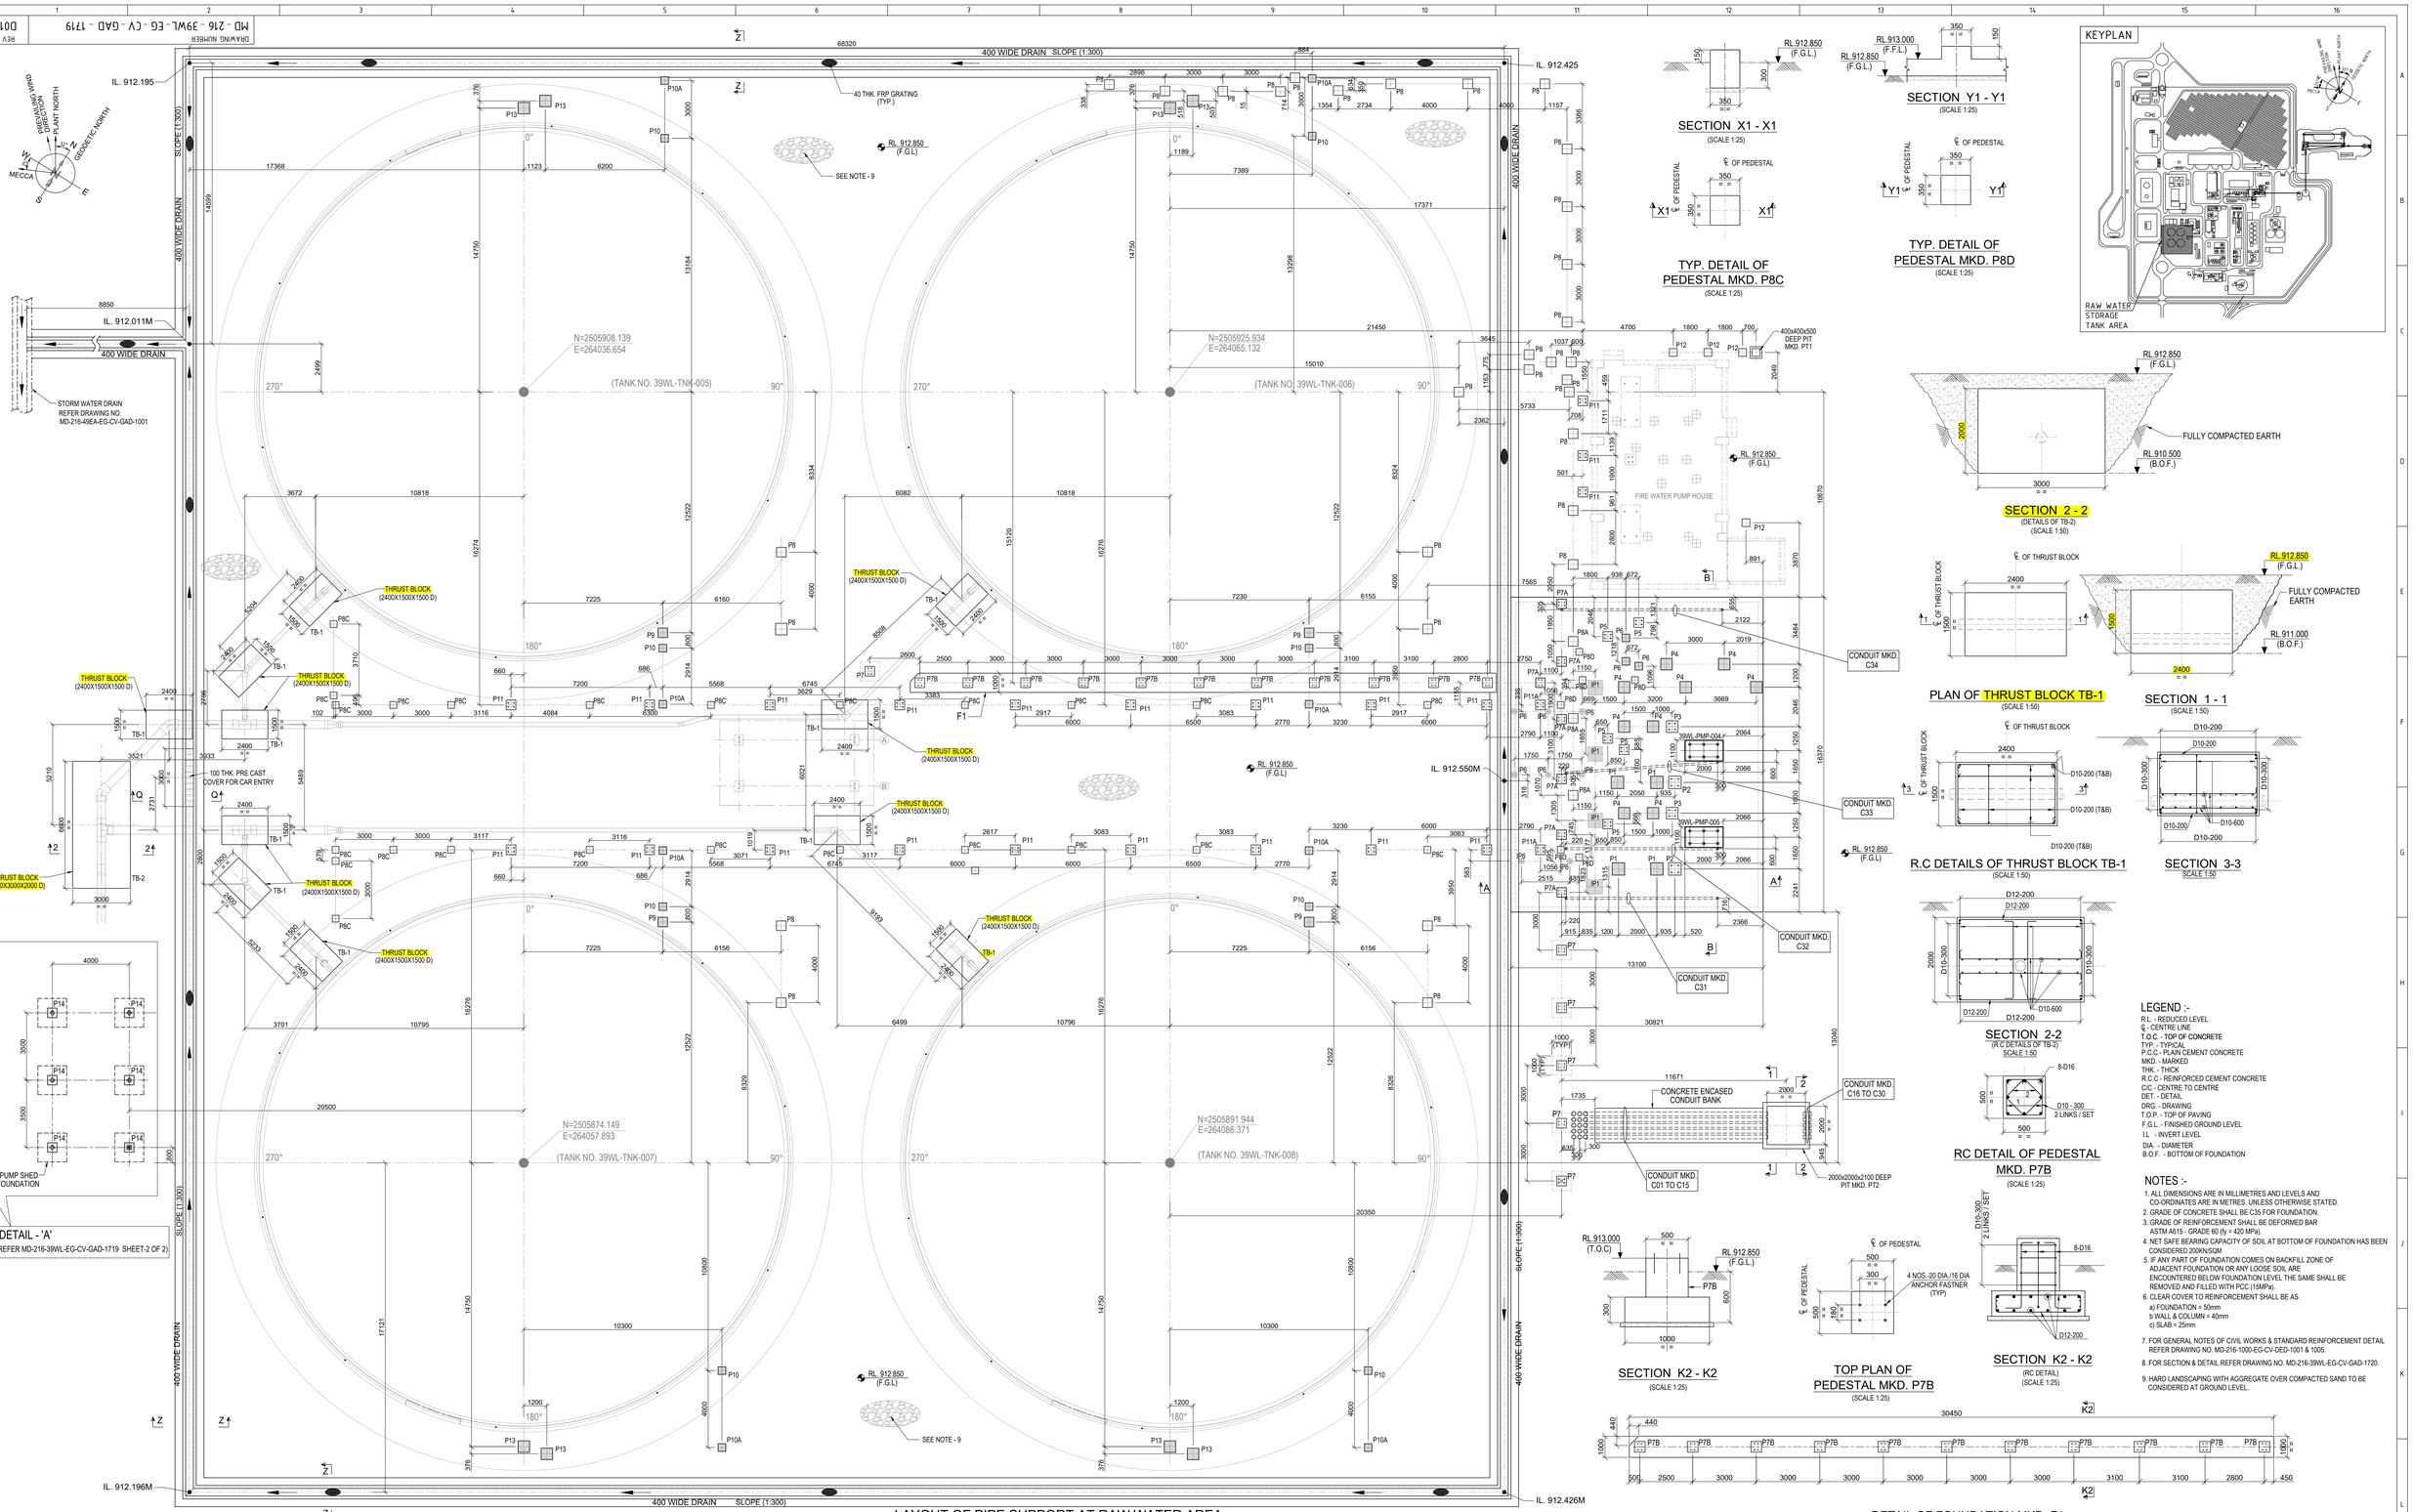

LAYOUT OF PIPE SUPPORT AT RAW WATER AREA

(SCALE - 1:125)

SECTION X1 - X1

(SCALE 1:25)

TYP. DETAIL OF PEDESTAL MKD. P8C

(SCALE 1:25)

SECTION Y1 - Y1

(SCALE 1:25)

TYP. DETAIL OF PEDESTAL MKD. P8D

(SCALE 1:25)

KEYPLAN

SECTION 2 - 2

(DETAILS OF TB-2)
(SCALE 1:50)

PLAN OF THRUST BLOCK TB-1

(SCALE 1:50)

SECTION 1 - 1

(SCALE 1:50)

R.C DETAILS OF THRUST BLOCK TB-1

(SCALE 1:50)

SECTION 3-3

SCALE 1:50

SECTION 2-2

(RC DETAILS OF TB-2)
SCALE 1:50

RC DETAIL OF PEDESTAL MKD. P7B

(SCALE 1:25)

SECTION K2 - K2

(SCALE 1:25)

TOP PLAN OF PEDESTAL MKD. P7B

(SCALE 1:25)

SECTION K2 - K2

(RC DETAIL)
(SCALE 1:25)

DETAIL OF FOUNDATION MKD. F1

(SCALE 1:100)

LEGEND :-

R.L - REDUCED LEVEL
℄ - CENTRE LINE
T.O.C - TOP OF CONCRETE
TYP - TYPICAL
P.C.C - PLAIN CEMENT CONCRETE
MKD. - MARKED
THK. - THICK
R.C.C - REINFORCED CEMENT CONCRETE
C/C - CENTRE TO CENTRE
DET. - DETAIL
DRG. - DRAWING
T.O.P - TOP OF PAVING
F.G.L - FINISHED GROUND LEVEL
I.L - INVERT LEVEL
DIA. - DIAMETER
B.O.F. - BOTTOM OF FOUNDATION

NOTES :-

1. ALL DIMENSIONS ARE IN MILLIMETRES AND LEVELS AND CO-ORDINATES ARE IN METRES. UNLESS OTHERWISE STATED.
2. GRADE OF CONCRETE SHALL BE C35 FOR FOUNDATION.
3. GRADE OF REINFORCEMENT SHALL BE DEFORMED BAR ASTM A615 - GRADE 60 (fy = 420 MPa).
4. NET SAFE BEARING CAPACITY OF SOIL AT BOTTOM OF FOUNDATION HAS BEEN CONSIDERED 200 KN/SQ.M
5. IF ANY PART OF FOUNDATION COMES ON BACKFILL ZONE OF ADJACENT FOUNDATION OR ANY LOOSE SOIL ARE ENCOUNTERED BELOW FOUNDATION LEVEL THE SAME SHALL BE REMOVED AND FILLED WITH PCC (15MPa).
6. CLEAR COVER TO REINFORCEMENT SHALL BE AS
   a) FOUNDATION = 50mm
   b) WALL & COLUMN = 40mm
   c) SLAB = 25mm
7. FOR GENERAL NOTES OF CIVIL WORKS & STANDARD REINFORCEMENT DETAIL REFER DRAWING NO. MD-216-1000-EG-CV-DED-1001 & 1005.
8. FOR SECTION & DETAIL REFER DRAWING NO. MD-216-39WL-EG-CV-GAD-1720.
9. HARD LANDSCAPING WITH AGGREGATE OVER COMPACTED SAND TO BE CONSIDERED AT GROUND LEVEL.

DOCUMENT NUMBER	REFERENCE DOCUMENTS	REV	DATE	REVISION DESCRIPTION	DRN	CHK	ENG	APP	EMP
		D01	09/03/2023	AS-BUILT	SYA	SJM	AVG	AG	
		C06	21/02/2022	ISSUED FOR CONSTRUCTION & REVISED AS MKD. (7,8,9)	SYA	SJM	AVG	AG	
		C04	05/01/2022	ISSUED FOR CONSTRUCTION & REVISED AS MKD. (5,6)	SYA	SJM	AVG	AG	
MD-216-1000-EG-ST-GAD-1007	RAW WATER - MISCELLANEOUS PIPE & CABLE SUPPORTS	C03	30/09/2021	ISSUED FOR CONSTRUCTION & REVISED AS MKD. (3,4)	SYA	SJM	AVG	AG	
	PLAN, ELEVATION & SECTION	C02	04/09/2021	ISSUED FOR CONSTRUCTION & REVISED AS MKD. (2,3)	PML	SJM	AVG	AG	
MD-216-39WL-EG-PE-GAD-V563-1020	39WL RAW WATER - RAW WATER DISTRIBUTION PIPE	C01	08/04/2021	ISSUED FOR CONSTRUCTION & REVISED AS MKD. (1)	AMJ	SJM	AVG	AG	
MD-216-1000-EG-ST-CRT-1001	CIVIL,STRUCTURAL AND ARCHITECTURAL DESIGN CRITERIA	A01	15/02/2021	ISSUED FOR APPROVAL	AMJ	SJM	AVG	AG	

RESERVED FOR VENDOR LOGO AND DRAWING NUMBER

LARSEN & TOUBRO

This drawing is the property of LARSEN & TOUBRO and must not be passed on to any person or body not authorized by us to receive it nor be copied or otherwise made use either in full or in part by such person or body without our prior permission in writing.

Outotec

The content of these documents are the sole property of Outotec Oyj. Any rights not expressly granted herein are reserved. Reproduction, transfer or distribution of part or all of the contents in any form without prior written permission of Outotec is prohibited.


MA'ADEN معادن Saudi Arabian Mining Company شركة معادن العربية السعودية


This document and the information contained herein is Ma'aden proprietary know-how. This document or any part thereof should not be reproduced, stored in a retrieval system or transmitted by any means, electronic or otherwise, or divulged without prior written permission of Ma'aden.

LARSEN & TOUBRO DRAWING NUMBER			REVISION
O19045_080_C_G_24588_001			6
OUTOTEC DRAWING NUMBER		DOCUMENT ID	REVISION
900707 __ GAU01 __ AG11 __ MTL01 __ 39252		OU100714972	6
DRAWN	AMJ	10/02/2021	MANSOURAH - MASSARAH GOLD PROJECT
CHECKED	SJM	11/02/2021	GENERAL ARRANGEMENT DRAWING
ENGINEER	AVG	10/02/2021	RAW WATER
APPROVED	AG	15/02/2021	LAYOUT & DETAIL OF GRADE SLAB
EMPLOYER			
SCALE 1:100, 50, 30, 10	A0	DRAWING NUMBER MD - 216 - 39WL - EG - CV - GAD - 1719	REV D01


SHEET 1 OF 2

DRAWING NUMBER MD - 216 - 39WL - EG - CV - GAD - 1719
REV D01

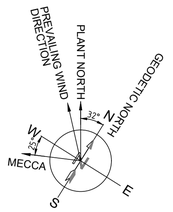


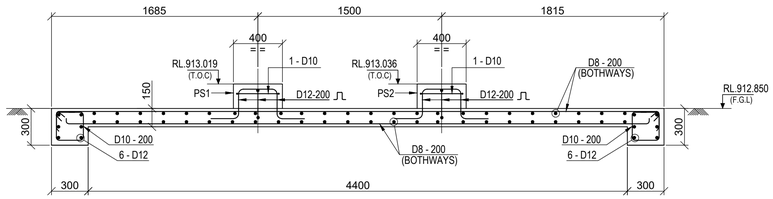

SECTION A - A
(SCALE 1:25)

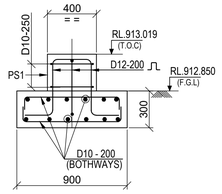

SECTION B - B
(SCALE 1:25)

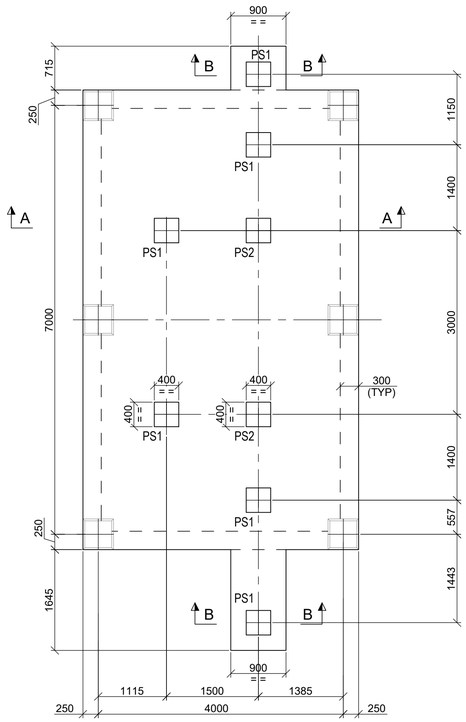

DETAIL - A
(SCALE 1:50)

LEGEND :-

R.L. - REDUCED LEVEL
℄ - CENTRE LINE
T.O.C. - TOP OF CONCRETE
TYP. - TYPICAL
P.C.C - PLAIN CEMENT CONCRETE
MKD. - MARKED
THK. - THICK
R.C.C - REINFORCED CEMENT CONCRETE
C/C - CENTRE TO CENTRE
DET. - DETAIL
DRG. - DRAWING
T.O.P. - TOP OF PAVING
F.G.L. - FINISHED GROUND LEVEL
I.L - INVERT LEVEL
DIA. - DIAMETER

NOTES :-

1. ALL DIMENSIONS ARE IN MILLIMETRES AND LEVELS AND CO-ORDINATES ARE IN METRES. UNLESS OTHERWISE STATED.
2. GRADE OF CONCRETE SHALL BE C35 FOR FOUNDATION.
3. GRADE OF REINFORCEMENT SHALL BE DEFORMED BAR ASTM A615 - GRADE 60 (fy = 420 MPa).
4. NET SAFE BEARING CAPACITY OF SOIL AT BOTTOM OF FOUNDATION HAS BEEN CONSIDERED 200KN/SQM
5. IF ANY PART OF FOUNDATION COMES ON BACKFILL ZONE OF ADJACENT FOUNDATION OR ANY LOOSE SOIL ARE ENCOUNTERED BELOW FOUNDATION LEVEL THE SAME SHALL BE REMOVED AND FILLED WITH PCC (15MPa).
6. CLEAR COVER TO REINFORCEMENT SHALL BE AS
   a) FOUNDATION = 50mm
   b WALL & COLUMN = 40mm
   c) SLAB = 25mm
7. FOR GENERAL NOTES OF CIVIL WORKS & STANDARD REINFORCEMENT DETAIL REFER DRAWING NO. MD-216-1000-EG-CV-DED-1001 & 1005.
8. FOR SECTION & DETAIL REFER DRAWING NO. MD-216-39WL-EG-CV-GAD-1720.
9. HARD LANDSCAPING WITH AGGREGATE OVER COMPACTED SAND TO BE CONSIDERED AT GROUND LEVEL.

SHEET 2 OF 2

DOCUMENT NUMBER	REFERENCE DOCUMENTS			REVISION DESCRIPTION	DRN	CHK	ENG	APP	EMP
		D01	09/03/2023	AS-BUILT	SYA	SJM	AVG	AG	
		C05	21/02//2022	ISSUED FOR CONSTRUCTION & REVISED AS MKD. C05	SYA	SJM	AVG	AG	
		C04	05/01/2022	ISSUED FOR CONSTRUCTION & REVISED AS MKD. C04	SYA	SJM	AVG	AG	
		C03	30/09/2021	ISSUED FOR CONSTRUCTION & REVISED AS MKD. C03	SYA	SJM	AVG	AG	
		C02	04/09/2021	ISSUED FOR CONSTRUCTION & REVISED AS MKD. C02	PML	SJM	AVG	AG	
		C01	08/04/2021	ISSUED FOR CONSTRUCTION & REVISED AS MKD. C01	AMJ	SJM	AVG	AG	
		A01	15/02/2021	ISSUED FOR APPROVAL	AMJ	SJM	AVG	AG	

RESERVED FOR VENDOR LOGO AND DRAWING NUMBER

LARSEN & TOUBRO

This drawing is the property of *LARSEN & TOUBRO* and must not be passed on to any person or body not authorized by us to receive it nor be copied or otherwise made use either in full or in part by such person or body without our prior permission in writing.

Outotec

The content of these documents are the sole property of Outotec Oyj. Any rights not expressly granted herein are reserved. Reproduction, transfer or distribution of part or all of the contents in any form without prior written permission of Outotec is prohibited.

MA'ADEN معادن
Saudi Arabian Mining Company شركة التعدين العربية السعودية

This document and the information contained herein is Ma'aden proprietary know-how. This document or any part thereof should not be reproduced, stored in a retrieval system or transmitted by any means, electronic or otherwise, or divulged without prior written permission of Ma'aden.

LARSEN & TOUBRO DRAWING NUMBER: 019045_080_C_G_24588_001 — REVISION: 6
OUTOTEC DRAWING NUMBER: 900707 _GAU01 _AG11 _MTL01 _39252 — DOCUMENT ID: OU100714972 — REVISION: 6

DRAWN	AMJ	10/02/2021
CHECKED	SJM	11/02/2021
ENGINEER	AVG	10/02/2021
APPROVED	AG	15/02/2021
EMPLOYER		
SCALE 1:50,15,10		A1

MANSOURAH - MASSARAH GOLD PROJECT
GENERAL ARRANGEMENT DRAWING
RAW WATER
LAYOUT & DETAIL OF GRADE SLAB

DRAWING NUMBER: MD - 216 - 39WL- EG - CV - GAD - 1719 — REV: D01