


DRAWING NUMBER: MD-216-39WL-EG-CV-GAD-1720 REV D01

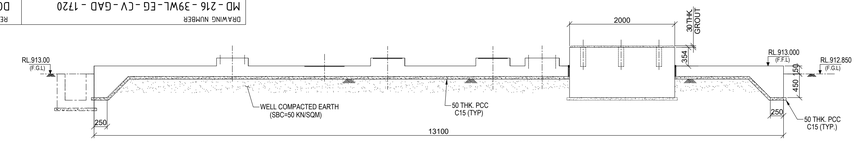


SECTION A - A
(SCALE - 1:40)

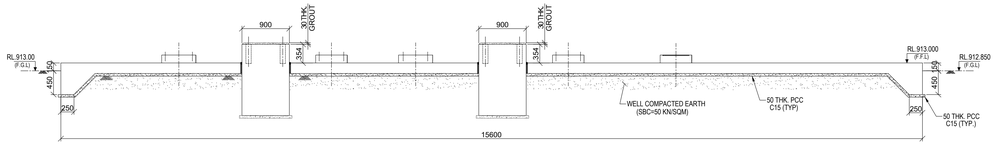


SECTION B - B
(SCALE - 1:40)

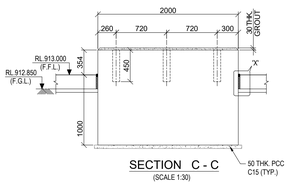


SECTION C - C
(SCALE 1:30)

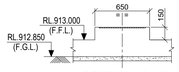


SECTION D - D
(SCALE 1:25)

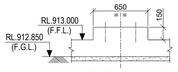


SECTION E - E
(SCALE 1:25)

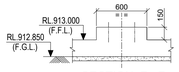


SECTION F - F
(SCALE 1:25)

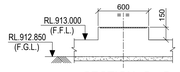


SECTION G - G
(SCALE 1:25)

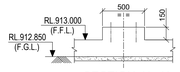


SECTION H - H
(SCALE 1:25)

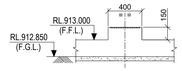


SECTION J - J
(SCALE 1:25)

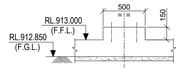


SECTION K1 - K1
(SCALE 1:25)

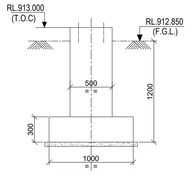


SECTION K - K
(SCALE 1:25)

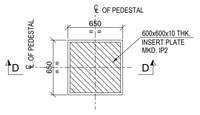


TYP. DETAIL OF PEDESTAL MKD. P1
(SCALE 1:25)

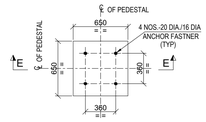


TYP. DETAIL OF PEDESTAL MKD. P2
(SCALE 1:25)

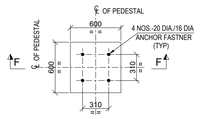


TYP. DETAIL OF PEDESTAL MKD. P3
(SCALE 1:25)

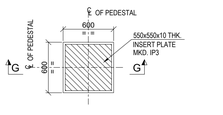


TYP. DETAIL OF PEDESTAL MKD. P4
(SCALE 1:25)

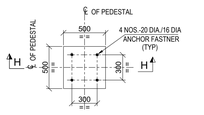


TYP. DETAIL OF PEDESTAL MKD. P5
(SCALE 1:25)

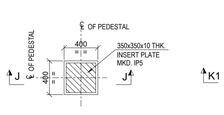


TYP. DETAIL OF PEDESTAL MKD. P6
(SCALE 1:25)

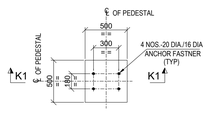


TYP. DETAIL OF PEDESTAL MKD. P7A
(SCALE 1:25)

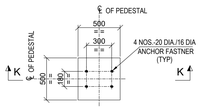


TYP. DETAIL OF PEDESTAL MKD. P7
(SCALE 1:25)

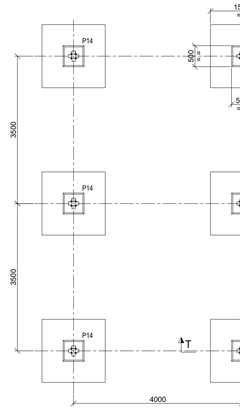


FOUNDATION PLAN FOR SHED
(SCALE 1:50)

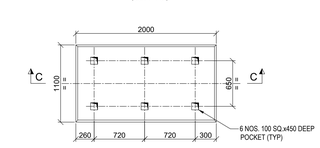


DETAIL OF PUMP FOUNDATION MKD. 39WL-PMP-004 & 39WL-PMP-005
(SCALE 1:30)

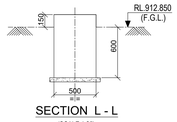


SECTION L - L
(SCALE 1:25)

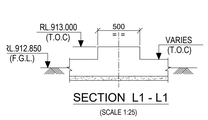


SECTION L1 - L1
(SCALE 1:25)

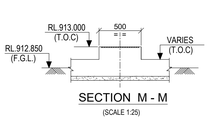


SECTION M - M
(SCALE 1:25)

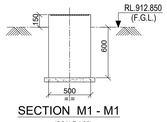


SECTION M1 - M1
(SCALE 1:25)

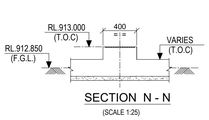


SECTION N - N
(SCALE 1:25)

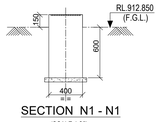


SECTION N1 - N1
(SCALE 1:25)

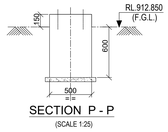


SECTION P - P
(SCALE 1:25)

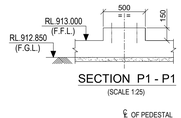


SECTION P1 - P1
(SCALE 1:25)

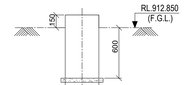


SECTION R - R
(SCALE 1:25)

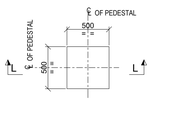


TYP. DETAIL OF PEDESTAL MKD. P8
(SCALE 1:25)

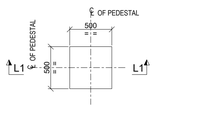


TYP. DETAIL OF PEDESTAL MKD. P8A
(SCALE 1:25)

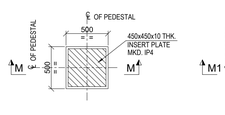


TYP. DETAIL OF PEDESTAL MKD. P9
(SCALE 1:25)

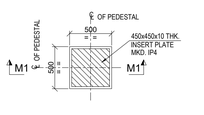


TYP. DETAIL OF PEDESTAL MKD. P9A
(SCALE 1:25)

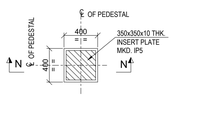


TYP. DETAIL OF PEDESTAL MKD. P10
(SCALE 1:25)

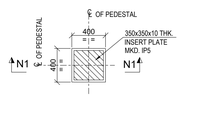


TYP. DETAIL OF PEDESTAL MKD. P10A
(SCALE 1:25)

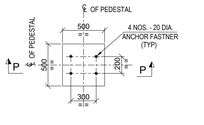


TYP. DETAIL OF PEDESTAL MKD. P11
(SCALE 1:25)

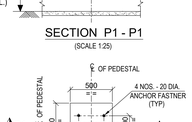


TYP. DETAIL OF PEDESTAL MKD. P11A
(SCALE 1:25)

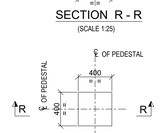


TYP. DETAIL OF PEDESTAL MKD. P12
(SCALE 1:25)

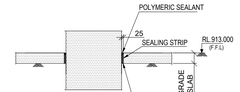


DETAIL - X
(SCALE 1:30)

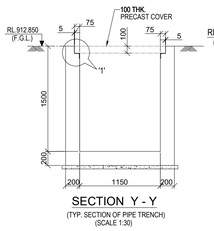


SECTION Y - Y
(TYP. SECTION OF PIPE TRENCH)
(SCALE 1:30)

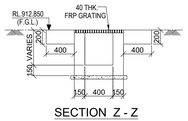


SECTION Z - Z
(TYP. SECTION OF OPEN DRAIN)
(SCALE 1:30)

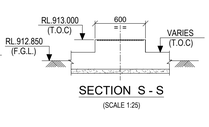


SECTION S - S
(SCALE 1:25)

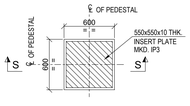


TYP. DETAIL OF PEDESTAL MKD. P13
(SCALE 1:25)

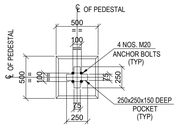


TYP. DETAIL OF PEDESTAL MKD. P14
(SCALE 1:25)

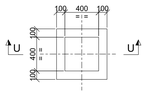


TYP. DETAIL OF PIT MKD. PT1
(SCALE 1:25)

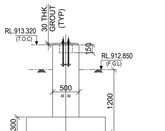


SECTION T - T
(SCALE - 1:40)

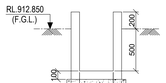

SECTION U - U
(SCALE 1:25)

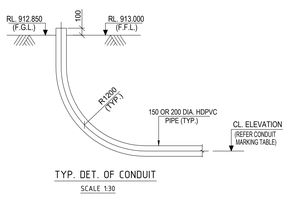


TYP. DET. OF CONDUIT
SCALE 1:30

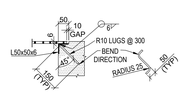


DETAIL - Y
(SCALE 1:10)

CONDUIT MARKING TABLE		
CONDUIT TAG	CL. OF ELEVATION	DIA. OF CONDUIT
C01	RL. 912.350	200
C02	RL. 912.350	200
C03	RL. 912.350	200
C04	RL. 912.350	200
C05	RL. 912.350	200
C06	RL. 912.050	200
C07	RL. 912.050	200
C08	RL. 912.050	200
C09	RL. 912.050	200
C10	RL. 912.050	200
C11	RL. 911.750	200
C12	RL. 911.750	200
C13	RL. 911.750	200
C14	RL. 911.750	200
C15	RL. 911.750	200


CONDUIT MARKING TABLE		
CONDUIT TAG	CL. OF ELEVATION	DIA. OF CONDUIT
C16	RL. 911.600	200
C17	RL. 911.600	200
C18	RL. 911.600	200
C19	RL. 911.600	200
C20	RL. 911.600	200
C21	RL. 911.300	200
C22	RL. 911.300	200
C23	RL. 911.300	200
C24	RL. 911.300	200
C25	RL. 911.300	200
C26	RL. 911.000	200
C27	RL. 911.000	200
C28	RL. 911.000	200
C29	RL. 911.000	200
C30	RL. 911.000	200
C31	RL. 912.100	100
C32	RL. 912.100	100
C33	RL. 912.100	100
C34	RL. 912.100	100

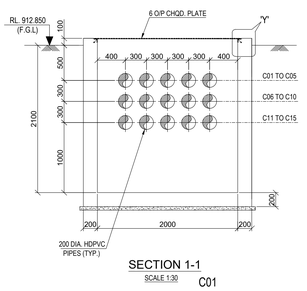


SECTION 1-1
SCALE 1:30 C01

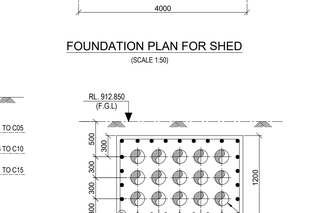


TYP. CROSS SECTION OF CONCRETE ENCASED CONDUIT BANK
(SCALE 1:30)

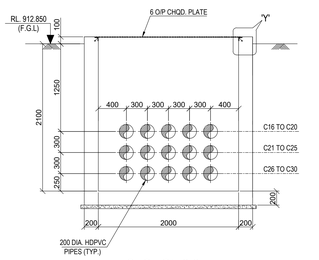


SECTION 2-2
SCALE 1:30

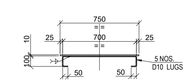


SECTION S1 - S1
(SCALE 1:20)

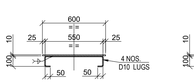


SECTION S2 - S2
(SCALE 1:20)

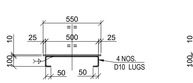


SECTION S3 - S3
(SCALE 1:20)

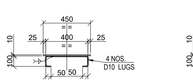


SECTION S4 - S4
(SCALE 1:20)

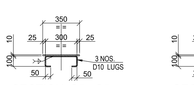


SECTION S5 - S5
(SCALE 1:20)

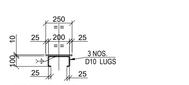


SECTION S6 - S6
(SCALE 1:20)

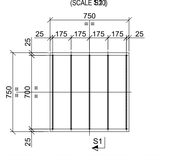


DETAIL OF INSERT PLATE MKD. IP1
(SCALE 1:20)

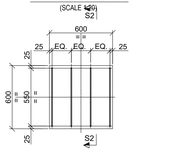


DETAIL OF INSERT PLATE MKD. IP2
(SCALE 1:20)

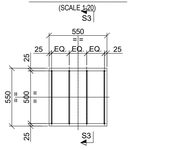


DETAIL OF INSERT PLATE MKD. IP3
(SCALE 1:20)

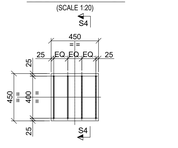

DETAIL OF INSERT PLATE MKD. IP4
(SCALE 1:20)

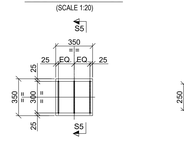

DETAIL OF INSERT PLATE MKD. IP5
(SCALE 1:20)

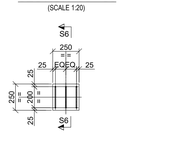

DETAIL OF INSERT PLATE MKD. IP6
(SCALE 1:20)

LEGEND :-

R.L - REDUCED LEVEL
℄ -CENTRE LINE
T.O.C. - TOP OF CONCRETE
TYP - TYPICAL
P.C.C - PLAIN CEMENT CONCRETE
MKD. - MARKED
THK. - THICK
R.C.C - REINFORCED CEMENT CONCRETE
C/C - CENTRE TO CENTRE
DET - DETAIL
DRG. - DRAWING
T.O.P - TOP OF PAVING
F.G.L - FINISHED GROUND LEVEL
I.L - INVERT LEVEL
F.F.L - FINISHED FLOOR LEVEL
DIA. - DIAMETER

NOTES :-

1. ALL DIMENSIONS ARE IN MILLIMETRES AND LEVELS AND CO-ORDINATES ARE IN METRES, UNLESS OTHERWISE STATED.
2. GRADE OF CONCRETE SHALL BE C35 FOR FOUNDATION.
3. GRADE OF REINFORCEMENT SHALL BE DEFORMED BAR ASTM A615 - GRADE 60 (fy = 420 MPa).
4. NET SAFE BEARING CAPACITY OF SOIL AT BOTTOM OF FOUNDATION HAS BEEN CONSIDERED 200KN/SQM
5. IF ANY PART OF FOUNDATION COMES ON BACKFILL ZONE OF ADJACENT FOUNDATION OR ANY LOOSE SOIL ARE ENCOUNTERED BELOW FOUNDATION LEVEL THE SAME SHALL BE REMOVED AND FILLED WITH PCC (15MPa).
6. STRUCTURAL FILL SHALL CONFORM TO PROVISIONS OF DOCUMENT MD-216-1000-EG-CV-MST-1698.
7. FOR GENERAL NOTES OF CIVIL WORKS & STANDARD REINFORCEMENT DETAIL REFER DRAWING NO. MD-216-1000-EG-CV-DED-1001 & 1005.
8. FOR PLAN DETAIL REFER DRAWING NO. MD-216-39WL-EG-CV-GAD-1719.

DOCUMENT NUMBER	REFERENCE DOCUMENTS	REV	DATE	REVISION DESCRIPTION	DRN	CHK	ENG	APP	EMP
MD-216-1000-EG-ST-GAD-1007	RAW WATER - MISCELLANEOUS PIPE & CABLE SUPPORTS	D01	09/03/2023	AS-BUILT	SYA	SJM	AVG	AG	
	PLAN, ELEVATION & SECTION	C02	21/02/2022	ISSUED FOR CONSTRUCTION & REVISED AS MKD. C02	SYA	SJM	AVG	AG	
MD-216-39WL-EG-PE-GAD-V563-1020	39WL RAW WATER - RAW WATER DISTRIBUTION PIPE	C01	08/04/2021	ISSUED FOR CONSTRUCTION & REVISED AS MKD. C01	AMJ	SJM	AVG	AG	
MD-216-1000-EG-ST-CRT-1001	CIVIL,STRUCTURAL AND ARCHITECTURAL DESIGN CRITERIA	A01	12/02/2021	ISSUED FOR APPROVAL	AMJ	SJM	AVG	AG	

RESERVED FOR VENDOR LOGO AND DRAWING NUMBER

LARSEN & TOUBRO

This drawing is the property of LARSEN & TOUBRO and must not be passed on to any person or body not authorized by us to receive it nor be copied or otherwise made use either in full or in part by such person or body without our prior permission in writing.

Outotec

The content of these documents are the sole property of Outotec Oyj. Any rights not expressly granted herein are reserved. Reproduction, transfer or distribution of part or all of the contents in any form without prior written permission of Outotec is prohibited.

MA'ADEN معادن
Saudi Arabian Mining Company شركة معادن العربية السعودية

This document and the information contained herein is Ma'aden proprietary know-how. This document or any part thereof should not be reproduced, stored in a retrieval system or transmitted by any means, electronic or otherwise, or divulged without prior written permission of Ma'aden.

LARSEN & TOUBRO DRAWING NUMBER: 019045_080_C_G_24643_001 — REVISION: 3
OUTOTEC DRAWING NUMBER: 900707__GAU01__AG11__MTL01__39254 — DOCUMENT ID: OU100717186 — REVISION: 3

DRAWN	AMJ	10/02/2021
CHECKED	SJM	11/02/2021
ENGINEER	AVG	10/02/2021
APPROVED	AG	15/02/2021
EMPLOYER		
SCALE	1:100, 50, 30, 10	A0

MANSOURAH - MASSARAH GOLD PROJECT
GENERAL ARRANGEMENT DRAWING
RAW WATER
DETAILS OF FOUNDATIONS & GRADE SLAB

DRAWING NUMBER: MD - 216 - 39WL-EG-CV-GAD - 1720 — REV: D01