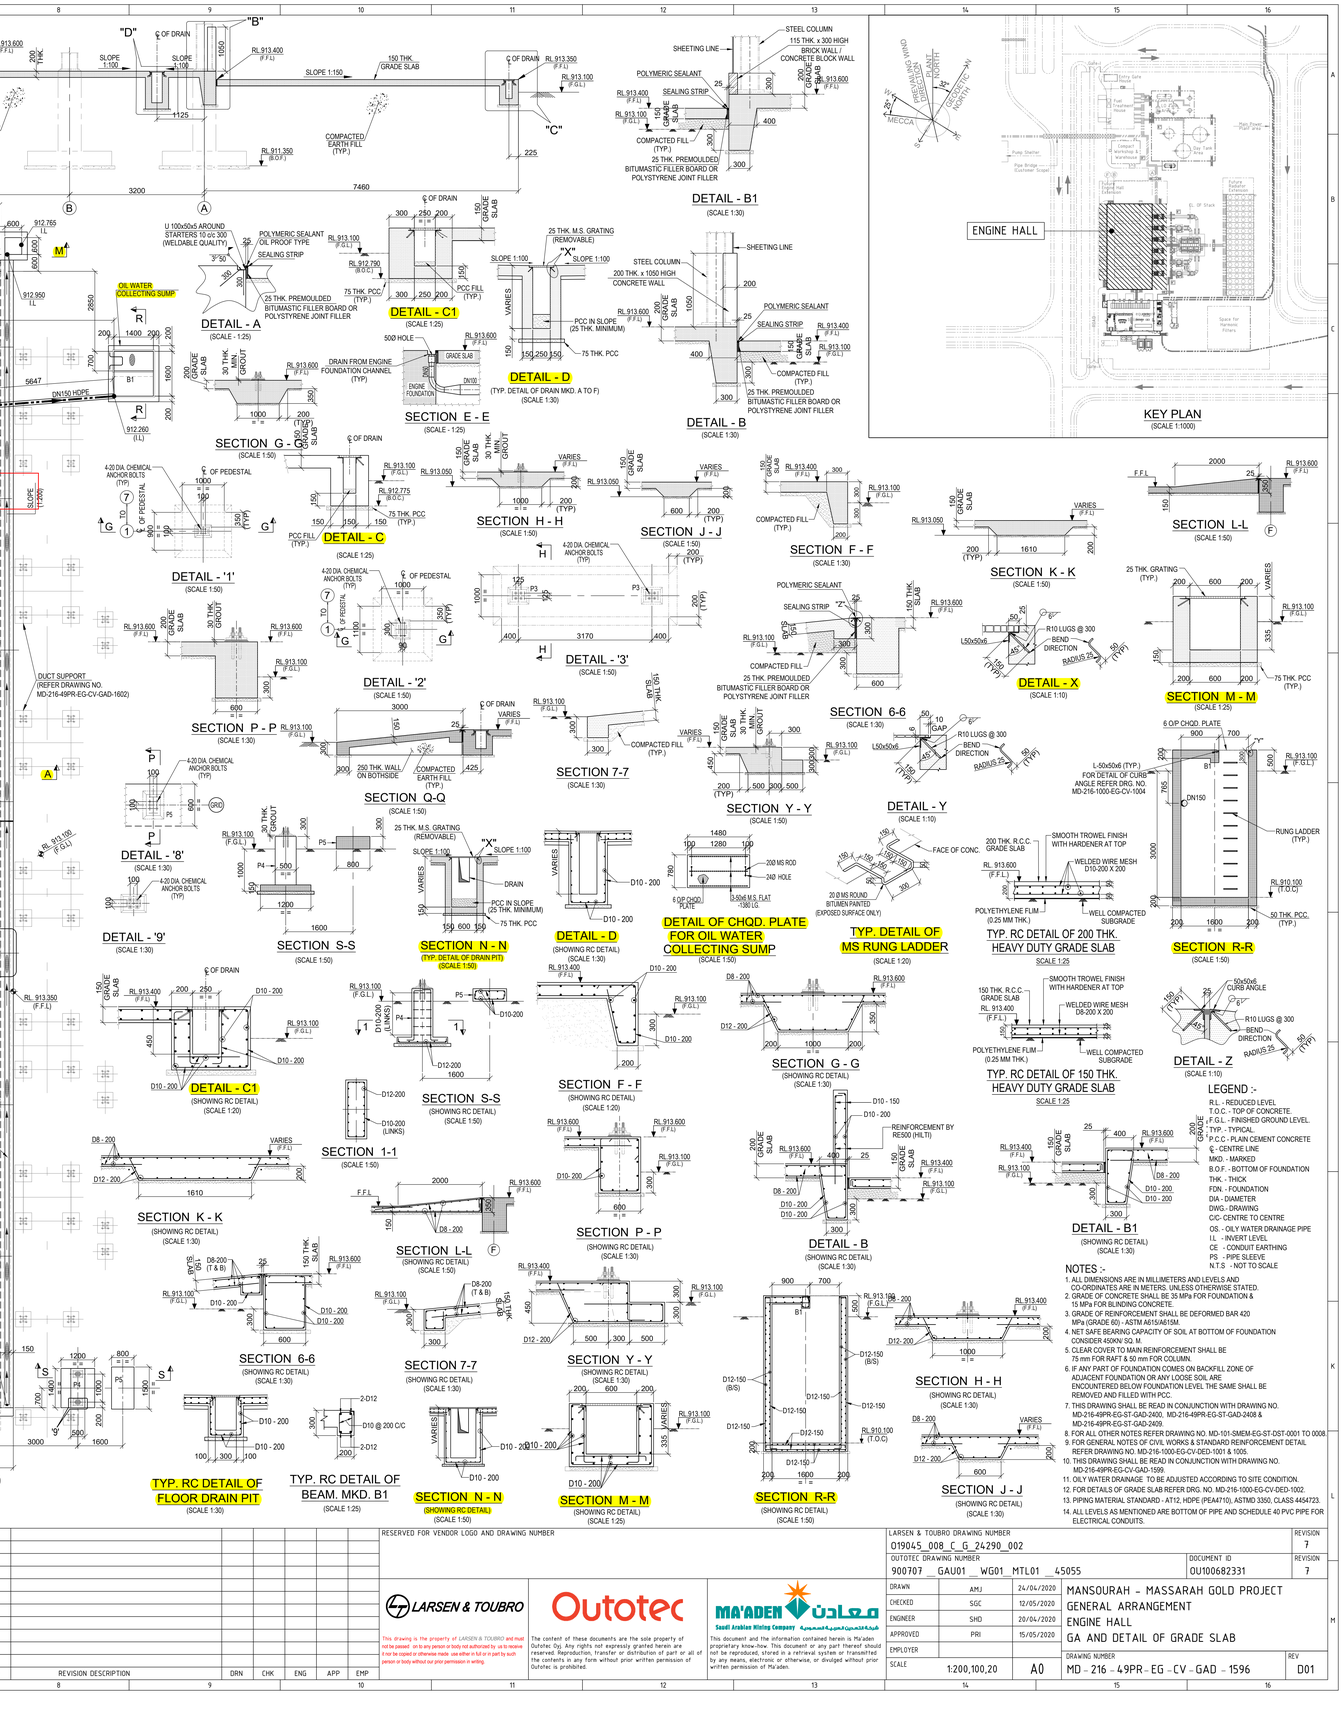


LEGEND :-

R.L - REDUCED LEVEL
T.O.C - TOP OF CONCRETE.
F.G.L - FINISHED GROUND LEVEL.
TYP - TYPICAL.
P.C.C - PLAIN CEMENT CONCRETE
℄ - CENTRE LINE
MKD - MARKED
B.O.F. - BOTTOM OF FOUNDATION
THK. - THICK
FDN. - FOUNDATION
DIA - DIAMETER
DWG - DRAWING
C/C- CENTRE TO CENTRE
OS - OIL WATER DRAINAGE PIPE
I.L - INVERT LEVEL
CE - CONDUIT EARTHING
PS - PIPE SLEEVE
N.T.S - NOT TO SCALE

NOTES :-

1. ALL DIMENSIONS ARE IN MILLIMETERS AND LEVELS AND CO-ORDINATES ARE IN METERS. UNLESS OTHERWISE STATED.
2. GRADE OF CONCRETE SHALL BE 35 MPa FOR FOUNDATION & 15 MPa FOR BLINDING CONCRETE.
3. GRADE OF REINFORCEMENT SHALL BE DEFORMED BAR 420 MPa (GRADE 60) - ASTM A615/A615M
4. NET SAFE BEARING CAPACITY OF SOIL AT BOTTOM OF FOUNDATION CONSIDER 450KN/ SQ. M.
5. CLEAR COVER TO MAIN REINFORCEMENT SHALL BE 75 mm FOR RAFT & 50 mm FOR COLUMN.
6. IF ANY PART OF FOUNDATION COMES ON BACKFILL ZONE OF ADJACENT FOUNDATION OR ANY LOOSE SOIL ARE ENCOUNTERED BELOW FOUNDATION LEVEL THE SAME SHALL BE REMOVED AND FILLED WITH PCC.
7. THIS DRAWING SHALL BE READ IN CONJUNCTION WITH DRAWING NO. MD-216-49PR-EG-ST-GAD-2400, MD-216-49PR-EG-ST-GAD-2408 & MD-216-49PR-EG-ST-GAD-2409.
8. FOR ALL OTHER NOTES REFER DRAWING NO. MD-101-SMEM-EG-ST-DST-0001 TO 0008
9. FOR GENERAL NOTES OF CIVIL WORKS & STANDARD REINFORCEMENT DETAIL REFER DRAWING NO. MD-216-1000-EG-CV-DED-1001 & 1005.
10. THIS DRAWING SHALL BE READ IN CONJUNCTION WITH DRAWING NO. MD-216-49PR-EG-CV-GAD-1599.
11. OIL WATER DRAINAGE TO BE ADJUSTED ACCORDING TO SITE CONDITION.
12. FOR DETAILS OF GRADE SLAB REFERRING NO. MD-216-1000-EG-CV-DED-1002.
13. PIPING MATERIAL STANDARD - AT12, HDPE (PE4710), ASTMD 3350, CLASS 4454723.
14. ALL LEVELS AS MENTIONED ARE BOTTOM OF PIPE AND SCHEDULE 40 PVC PIPE FOR ELECTRICAL CONDUITS.

DOCUMENT NUMBER	REFERENCE DOCUMENTS	REV	DATE	REVISION DESCRIPTION	DRN	CHK	ENG	APP	EMP
MD-216-49PR-EG-EL-LAD-V553-1019 & 1011	EARTHING LAYOUT								
MD-101-SMEM-EG-EL-DST-0066	ALL AREAS ELECTRICAL STANDARDS	D01	17/02/2023	AS-BUILT & REVISED AS MKD. 001	SYA	SJM	AVG	AG	
	STRUCTURAL STEEL EARTHING TYPICAL DETAILS	C06	30/07/2021	ISSUED FOR CONSTRUCTION AND REVISED AS MKD. 001	SYA	SJM	AVG	AG	
DBAF507308	ENGINE HALL CABLE CONDUIT	C05	07/12/2020	ISSUED FOR CONSTRUCTION AND REVISED AS MKD. 001	PDK	SGC	SHD	PRI	
MD-216-1000-EG-ST-CRT-1001	CIVIL, STRUCTURAL & ARCHITECTURAL-DESIGN CRITERIA	C04	28/11/2020	ISSUED FOR CONSTRUCTION AND REVISED AS MKD. 001	PDK	SGC	SHD	PRI	
MD-216-49PR-EG-ME-GAD-V553-1001	ENGINE & GENERATOR	C03	16/10/2020	ISSUED FOR CONSTRUCTION AND REVISED AS MKD. 001	AMJ	SGC	SHD	PRI	
MD-216-49PR-EG-ME-LAD-V553-1052	ENGINE HALL, LOAD PLAN	C02	22/09/2020	ISSUED FOR CONSTRUCTION AND REVISED AS MKD. 001	AMJ	SGC	SHD	PRI	
MD-216-49PR-EG-ME-LAD-V553-1053	ENGINE HALL, LOAD PLAN	C01	01/09/2020	ISSUED FOR CONSTRUCTION AND REVISED AS MKD. 001	AMJ	SGC	SHD	PRI	
MD-216-49PR-EG-ME-LAD-V553-1010	ENGINE HALL, OILY WATER DRAINAGE	A01	15/05/2020	ISSUED FOR REFERENCE	AMJ	SGC	SHD	PRI	

RESERVED FOR VENDOR LOGO AND DRAWING NUMBER

LARSEN & TOUBRO

This drawing is the property of LARSEN & TOUBRO and must not be passed on to any person or body not authorized by us to receive it nor be copied or otherwise made use either in full or in part by such person or body without our prior permission in writing.

Outotec

The content of these documents are the sole property of Outotec Oyj. Any rights not expressly granted herein are reserved. Reproduction, transfer or distribution of part or all of the contents in any form without prior written permission of Outotec is prohibited.

MA'ADEN معادن
Saudi Arabian Mining Company شركة معادن السعودية

This document and the information contained herein is Ma'aden proprietary know-how. This document or any part thereof should not be reproduced, stored in a retrieval system or transmitted by any means, electronic or otherwise, or divulged without prior written permission of Ma'aden.

LARSEN & TOUBRO DRAWING NUMBER	019045_008_C_G_24290_002
REVISION	7
OUTOTEC DRAWING NUMBER	900707__GAU01__WG01_MTL01__45055
DOCUMENT ID	OU100682331
REVISION	7
DRAWN	AMJ 24/04/2020
CHECKED	SGC 12/05/2020
ENGINEER	SHD 20/04/2020
APPROVED	PRI 15/05/2020
EMPLOYER	
SCALE	1:200,100,20
A0	

MANSOURAH - MASSARAH GOLD PROJECT
GENERAL ARRANGEMENT
ENGINE HALL
GA AND DETAIL OF GRADE SLAB

DRAWING NUMBER: MD - 216 - 49PR - EG - CV - GAD - 1596
REV: D01