MA'ADEN معادن

Saudi Arabian Mining Company شركة التعدين العربية السعودية

Project **Mansourah Massarah Gold Project**

Customer: **MA'ADEN GOLD AND BASE METALS (MA'ADEN)**

Title: **GENERAL ARRANGEMENT**
COMPACT WORKSHOP & WAREHOUSE
GA AND DETAIL OF GRADE SLAB


Document Number: **MD-216-49PR-EG-CV-GAD-1624**
Revision: **D01**
Revision Date: **17.02.2023**
Status: **AS BUILT**

Outotec Document Number:	900707	GAU01	WG01	MTL01	45054	OU100682330	6
L&T Document Number:	O19045	008	C	G	24290	007	6

REVISION HISTORY


Rev	Date	Revision Text	Prepared By	Reviewed By	Approved By	Employer
A01	25.05.2020	ISSUED FOR REVIEW	AMJ	SGC	PRI	
C01	16.12.2020	ISSUED FOR CONSTRUCTION & REVISED AS MKD. C01	AMJ	SGC	PRI	
C02	13.10.2020	ISSUED FOR CONSTRUCTION & REVISED AS MKD. C02	AMJ	SGC	PRI	
C03	16.12.2020	ISSUED FOR CONSTRUCTION & REVISED AS MKD. C03	AMJ	SGC	PRI	
C04	31.03.2021	ISSUED FOR CONSTRUCTION & REVISED AS MKD. C04	AMJ	SGC	PRI	
C05	23.08.2021	ISSUED FOR CONSTRUCTION & REVISED AS MKD. C05	SYA	SJM	AG	
D01	17.02.2023	AS BUILT	SYA	SJM	AG	

DRAWING NUMBER: MD-216-49PR-EG-CV-GAD-1624 REV D01

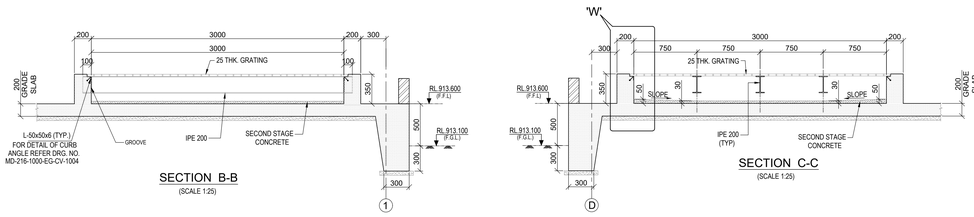


SECTION B-B
(SCALE 1:25)


SECTION C-C
(SCALE 1:25)

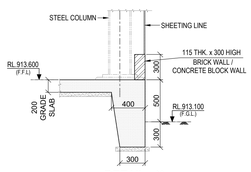


DETAIL - X
(SCALE 1:25)

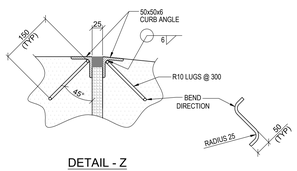


DETAIL - Z
(SCALE 1:5)

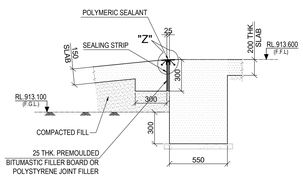


DETAIL - A
(SCALE 1:20)

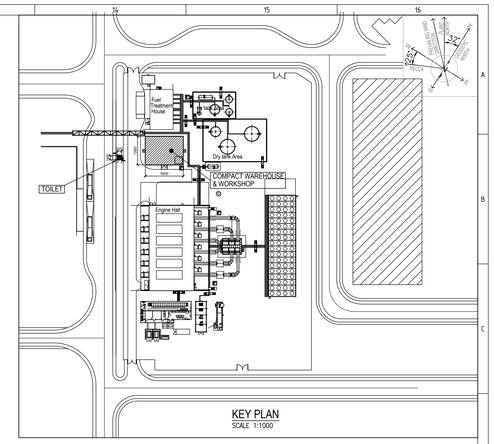


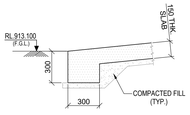


DETAIL - B
(SCALE 1:20)

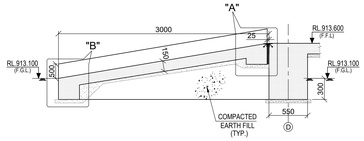


SECTION F-F
(SCALE 1:30)

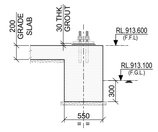

SECTION H - H
(SCALE 1:30)

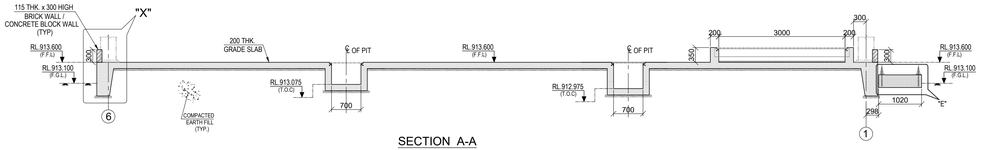


SECTION A-A
(SCALE 1:50)

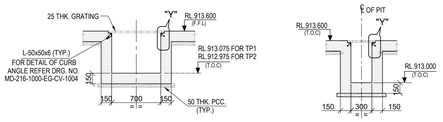


DETAIL OF PIT MKD. PT1 & PT2
(SCALE 1:30)


DETAIL OF PIT MKD. PT3 & PT3A
(SCALE 1:30)

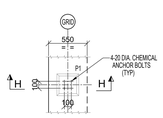


DETAIL - '1'
(SCALE 1:30)

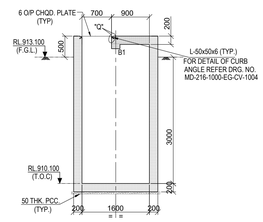


SECTION D-D
(SCALE 1:50)

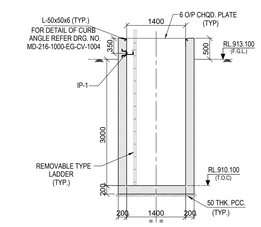


SECTION E-E
(SCALE 1:50)

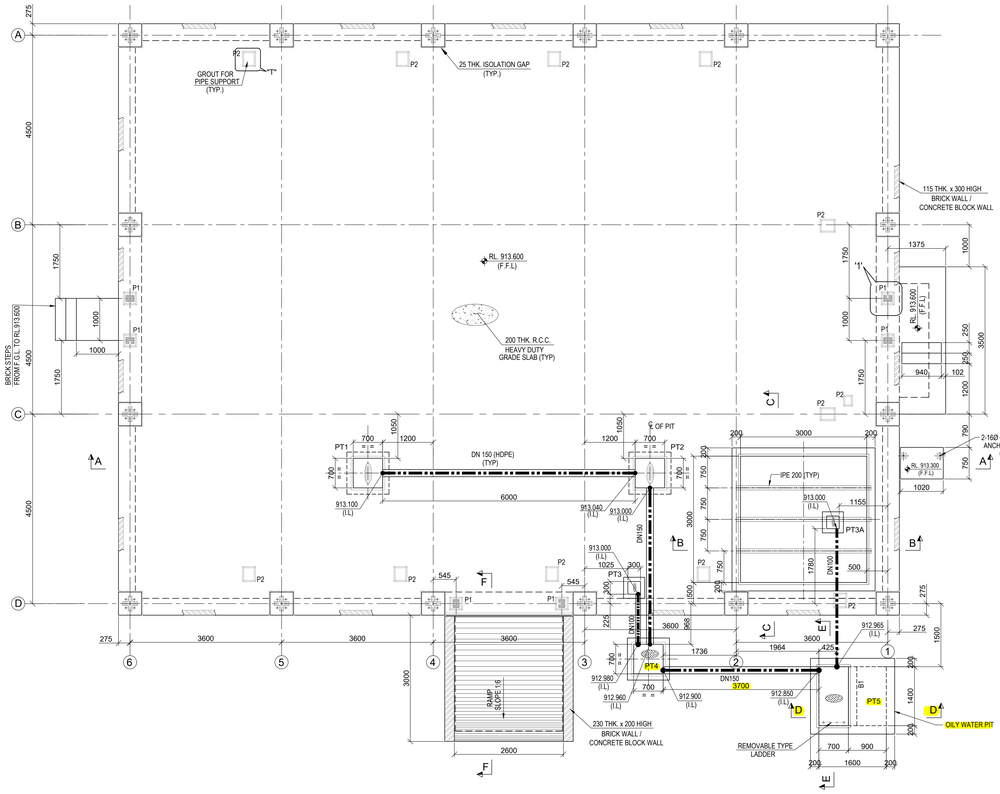


LAYOUT OF GRADE SLAB FOR COMPACT WORKSHOP & WAREHOUSE
(SCALE 1:50)

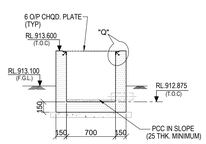


DETAIL OF PIT MKD. PT4
(SCALE 1:30)

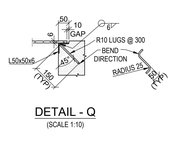


DETAIL - Q
(SCALE 1:10)

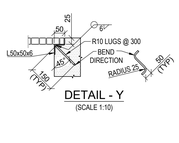


DETAIL - Y
(SCALE 1:10)

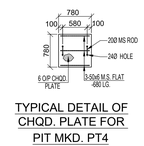


TYPICAL DETAIL OF CHQD. PLATE FOR PIT MKD. PT4
(SCALE 1:50)

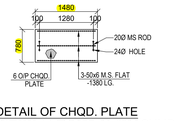


DETAIL OF CHQD. PLATE FOR OIL WATER COLLECTING SUMP MKD. PT5
(SCALE 1:50)

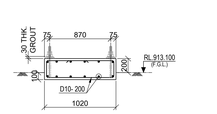

DETAIL - "E"
(SCALE 1:30)

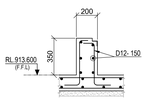


DETAIL 'W'
(SCALE 1:20)

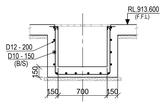


RC DETAIL OF PIT MKD. PT1 & PT2
(SCALE 1:30)




DETAIL - "T"
(DETAIL OF GROUT FOR PIPE SUPPORT MKD. P2)
(SCALE 1:30)

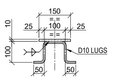


SECTION S1 - S1
(SCALE 1:10)

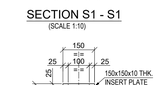


DETAIL OF INSERT PLATE - IP1
(SCALE 1:10)

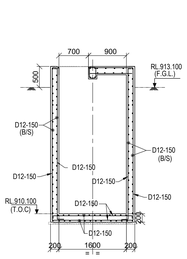


SECTION D-D
(SHOWING RC DETAIL)
(SCALE 1:50)

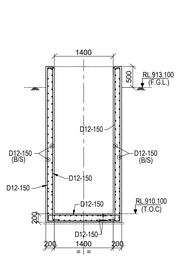


SECTION E-E
(SHOWING RC DETAIL)
(SCALE 1:50)

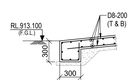


DETAIL - B
(SHOWING RC DETAIL)
(SCALE 1:30)

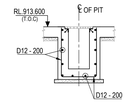


RC DETAIL OF PIT MKD. PT3 & PT3A
(SCALE 1:30)

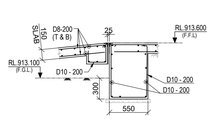


DETAIL - A
(SHOWING RC DETAIL)
(SCALE 1:30)

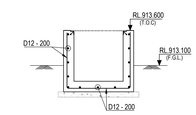


RC DETAIL OF PIT MKD. PT4
(SCALE 1:30)

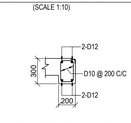


TYP. RC DETAIL OF BEAM. MKD. B1
(SCALE 1:25)

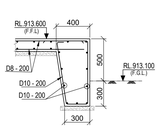

DETAIL - X
(SHOWING RC DETAIL)
(SCALE 1:25)

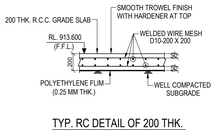

TYP. RC DETAIL OF 200 THK. HEAVY DUTY GRADE SLAB
SCALE 1:25

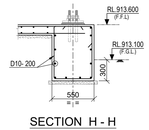

SECTION H - H
(SHOWING RC DETAIL)
(SCALE 1:30)

LEGEND :-

RL - REDUCED LEVEL.
T.O.C. - TOP OF CONCRETE.
F.G.L. - FINISHED GROUND LEVEL.
B.O.F. - BOTTOM OF FOOTING.
F.F.L - FINISHED FLOOR LEVEL.
℄ - CENTRE LINE.
TYP. - TYPICAL.
THK. - THICK.
MKD. - MARKED.
C/C - CENTER TO CENTRE.
DIA. - DIAMETRE.
OS. - OILY WATER DRAINAGE PIPE
CHQD. - CHEQUERED PLATE.
I.L - INVERT LEVEL.
T & B - TOP & BOTTOM
DRG. - DRAWING
DOC. - DOCUMENT

NOTES :-

1. ALL DIMENSIONS ARE IN MILLIMETRES AND LEVELS AND CO-ORDINATES ARE IN METRES. UNLESS OTHERWISE STATED.
2. GRADE OF CONCRETE SHALL BE 35 MPa FOR FOUNDATION & 15 MPa FOR BLINDING CONCRETE.
3. GRADE OF REINFORCEMENT SHALL BE DEFORMED BAR 420 MPa (GRADE 60) - ASTM A615/A615M.
4. NET SAFE BEARING CAPACITY OF SOIL AT BOTTOM OF FOUNDATION CONSIDER 500 KN/ SQ. M.
5. CLEAR COVER TO MAIN REINFORCEMENT SHALL BE 75 mm FOR RAFT & 50 mm FOR COLUMN.
6. IF ANY PART OF FOUNDATION COMES ON BACKFILL ZONE OF ADJACENT FOUNDATION OR ANY LOOSE SOIL ARE ENCOUNTERED BELOW FOUNDATION LEVEL THE SAME SHALL BE REMOVED AND FILLED WITH PCC.
7. FOR DETAILS OF GRADE SLAB REFER DRG. NO. MD-216-1000-EG-CV-DED-1002.
8. THE CONTENT OF THIS DRAWING SHALL CONFORM TO THE PROVISIONS OF CIVIL, STRUCTURAL AND ARCHITECTURAL DESIGN CRITERIA DOC NO. MD-216-1000-EG-ST-CRT-1001.
9. THIS DRAWING SHALL BE READ IN CONJUNCTION WITH DRAWING NO. MD-216-49PR-EG-ST-GAD-2419.
10. ALL OTHER NOTES REFER DRAWING NO. MD-101-SMEM-EG-ST-DST-0001 TO 0008.
11. GENERAL NOTES FOR CIVIL WORKS & STANDARD REINFORCEMENT DETAIL REFER DRAWING NO. MD-216-1000-EG-CV-DED-1001 & 1005.
12. THIS DRAWING SHALL BE READ IN CONJUNCTION WITH DRAWING NO. MD-216-49PR-EG-CV-GAD-1623.
13. OILY WATER DRAINAGE TO BE ADJUSTED ACCORDING TO SITE CONDITION.
14. PIPING MATERIAL STANDARD - AT12, HDPE (PE4710).
15. ALL LEVELS AS MENTIONED ARE BOTTOM OF PIPE.
16. FOR STANDARD DETAILS OF GRADE SLAB REFER DRAWING NO. MD-216-1000-EG-CV-DED-1002.

SHEET-1 OF 2

DOCUMENT NUMBER	REFERENCE DOCUMENTS	REV	DATE	REVISION DESCRIPTION	DRN	CHK	ENG	APP	EMP
		D01	17/02/2023	AS-BUILT	SYA	SJM	AVG	AG	
		C05	23/08/2021	ISSUED FOR CONSTRUCTION & REVISED AS MKD. C05	SYA	SJM	AVG	AG	
		C04	31/03/2021	ISSUED FOR CONSTRUCTION & REVISED AS MKD. C04	AMJ	SGC	SHD	PRI	
		C03	16/12/2020	ISSUED FOR CONSTRUCTION & REVISED AS MKD. C03	AMJ	SGC	SHD	PRI	
		C02	13/10/2020	ISSUED FOR CONSTRUCTION & REVISED AS MKD. C02	AMJ	SGC	SHD	PRI	
		C01	25/06/2020	ISSUED FOR CONSTRUCTION & REVISED AS MKD. C01	AMJ	SGC	SHD	PRI	
MD-216-49PR-EG-ME-GAD-V553-1057	COMPACT WORKSHOP & WAREHOUSE	A01	25/05/2020	ISSUED FOR REFERENCE	AMJ	SGC	SHD	PRI	

RESERVED FOR VENDOR LOGO AND DRAWING NUMBER

LARSEN & TOUBRO
This drawing is the property of LARSEN & TOUBRO and must not be passed on to any person or body not authorized by us to receive it nor be copied or otherwise made use either in full or in part by such person or body without our prior permission in writing.

Outotec
The content of these documents are the sole property of Outotec Oyj. Any rights not expressly granted herein are reserved. Reproduction, transfer or distribution of part or all of the contents in any form without prior written permission of Outotec is prohibited.


MA'ADEN معادن Saudi Arabian Mining Company شركة المعادن العربية السعودية
This document and the information contained herein is Ma'aden proprietary know-how. This document or any part thereof should not be reproduced, stored in a retrieval system or transmitted by any means, electronic or otherwise, or divulged without prior written permission of Ma'aden.

LARSEN & TOUBRO DRAWING NUMBER	019045_008_C_G_24290_007	REVISION 6
OUTOTEC DRAWING NUMBER	900707 _ GAU01 _ WG01_ MTL01 _ 45054	DOCUMENT ID OU100682330 / REVISION 6
DRAWN	AMJ	13/05/2020
CHECKED	SGC	22/05/2020
ENGINEER	SHD	12/05/2020
APPROVED	PRI	25/05/2020
EMPLOYER		
SCALE	1:200,100,20	A0

MANSOURAH - MASSARAH GOLD PROJECT
GENERAL ARRANGEMENT
COMPACT WORKSHOP & WAREHOUSE
GA AND DETAIL OF GRADE SLAB


DRAWING NUMBER: MD - 216 - 49PR - EG - CV - GAD - 1624 REV: D01

DRAWING NUMBER MD-216-49PR-EG-CV-GAD-1624 REV D01

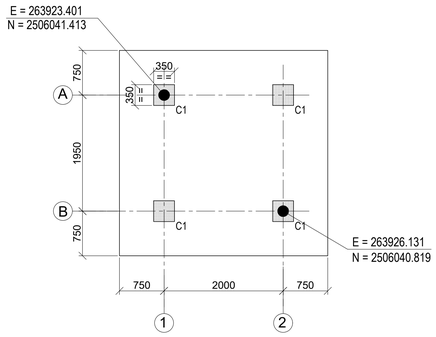


FOUNDATION PLAN AT RL.911.600 (B.O.F.)

(DETAIL OF TOILET BLOCK)
(SCALE 1:50)

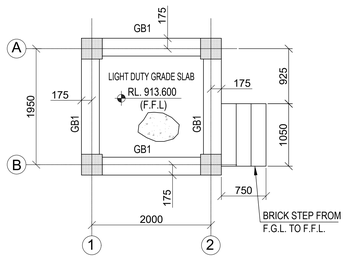


PLAN OF GRADE BEAM
AT RL. 913.400 (T.O.C.)

(SCALE 1:50)

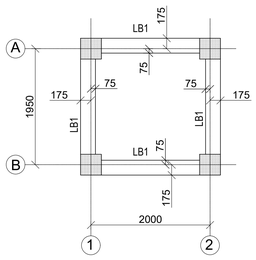


PLAN OF LINTEL BEAM
AT RL. 915.950 (T.O.C.)

(SCALE 1:50)

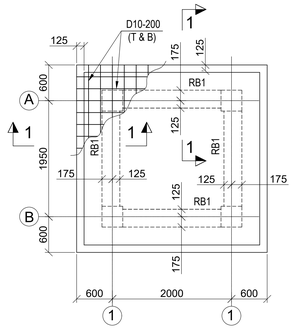




PLAN AT RL. 916.800


(SCALE 1:50)

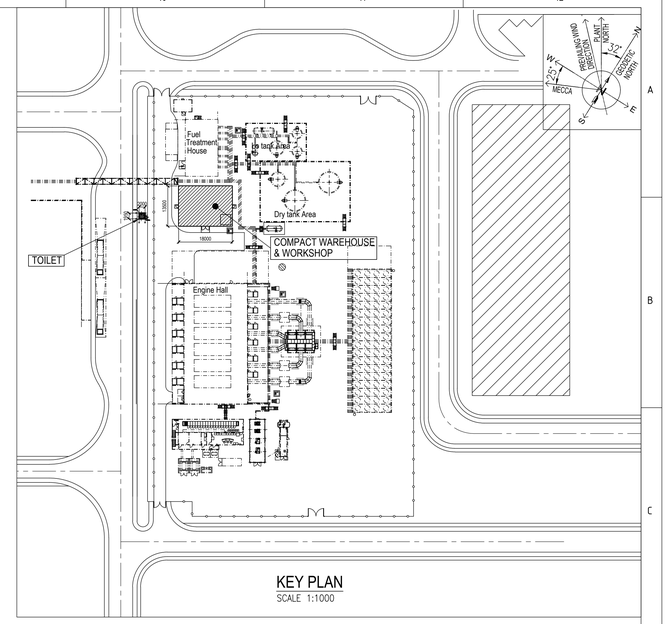


KEY PLAN
SCALE 1:1000

RCC SCHEDULE OF BEAM

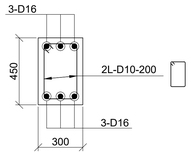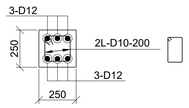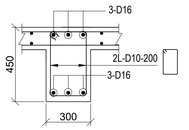
BEAM MKD.	SIZE	CROSS SECTION	TOP OF BEAM (T.O.B)
GB1	300 x 450		RL. 913.400
LB1	250 x 250		RL. 915.950
RB1	300X450		RL. 916.800

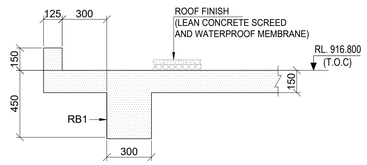

SECTION 1-1
(SCALE 1:20)

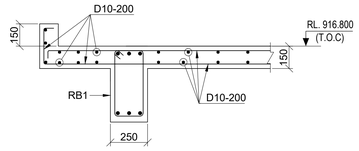


SECTION 1-1
(SHOWING RC DETAIL)
(SCALE 1:20)

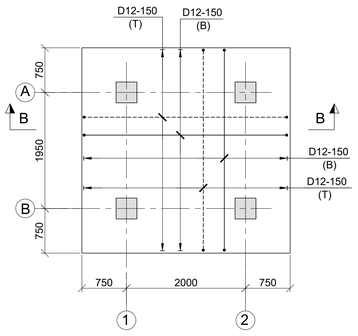


R.C. DETAIL OF FOUNDATION
FOR TOILET BLOCK

(SCALE 1:50)

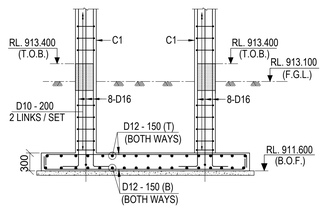

SECTION B - B
(SCALE-1:50)

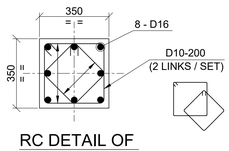

RC DETAIL OF
COLUMN MKD. C1

(4 NOS. REQUIRED)
(SCALE- 1:15)

LEGEND :-

RL. - REDUCED LEVEL.
T.O.C. - TOP OF CONCRETE.
T.O.B. - TOP OF BEAM.
F.G.L. - FINISHED GROUND LEVEL.
B.O.F. - BOTTOM OF FOOTING.
B.O.B. - BOTTOM OF BEAM.
HCS - HOLLOW CORE SLAB
SSL - STRUCTURAL SLAB LEVEL
CL - CENTRE LINE.
TYP. - TYPICAL.
THK. - THICK.
MKD. - MARKED.
G.A. - GENERAL ARRANGEMENT.
R.C.C. - REINFORCED CEMENT CONRETE.
WWF - WELDED WIRE FABRIC
U.N.O. - UNLESS NOTED OTHERWISE
T - TOP.
B - BOTTOM.
DRG - DRAWING.

NOTES :-

1. ALL DIMENSIONS ARE IN MILLIMETRES AND LEVELS AND CO-ORDINATES ARE IN METRES. UNLESS OTHERWISE STATED.
2. FGL CORRESPONDS TO RL. (+) 913.100 M LEVEL.
3. GRADE OF CONCRETE SHALL BE 35 MPa FOR FOUNDATION & 15 MPa FOR BLINDING CONCRETE.
4. GRADE OF REINFORCEMENT SHALL BE DEFORMED BAR 420 MPa (GRADE 60) - ASTM A615/A615M.
5. NET SAFE BEARING CAPACITY OF SOIL AT BOTTOM OF FOUNDATION CONSIDER 500KN/ SQ. M.
6. CLEAR COVER TO MAIN REINFORCEMENT SHALL BE
   a) FOUNDATION = 75 mm (BOTTOM & SIDE) 50 mm. (TOP)
   b) COLUMN & PEDESTAL = 50mm
   c) BEAM = 50mm
   d) SLAB = 20mm
7. IF ANY PART OF FOUNDATION COMES ON BACKFILL ZONE OF ADJACENT FOUNDATION OR ANY LOOSE SOIL ARE ENCOUNTERED BELOW FOUNDATION LEVEL THE SAME SHALL BE REMOVED AND FILLED WITH PCC.
8. ALL OTHER NOTES REFER DRAWING NO. MD-101-SMEM-EG-ST-DST-0001 TO 0008.
9. GENERAL NOTES FOR CIVIL WORKS & STANDARD REINFORCEMENT DETAIL REFER DRAWING NO. MD-216-1000-EG-CV-DED-1001 & 1005.
10. FOR STANDARD DETAILS OF GRADE SLAB REFER DRAWING NO. MD-216-1000-EG-CV-DED-1002.

SHEET-2 OF 2

DOCUMENT NUMBER	REFERENCE DOCUMENTS	REV	DATE	REVISION DESCRIPTION	DRN	CHK	SHD	PRI	EMP
		D01	17/02/2023	AS-BUILT	SYA	SJM	AVG	AG	
		C05	23/08/2021	ISSUED FOR CONSTRUCTION & REVISED AS MKD. C05	SYA	SJM	AVG	AG	
MD-216-49PR-EG-AR-GAD-3188	POWER GENERATION:COMPACT WAREHOUSE & WORKSHOP	C04	31/03/2021	ISSUED FOR CONSTRUCTION	AMJ	SGC	SHD	PRI	
	PLUMBING AND SANITARY DETAILS	C03	16/12/2020	ISSUED FOR CONSTRUCTION & REVISED AS MKD. C03	AMJ	SGC	SHD	PRI	
MD-216-49PR-EG-AR-GAD-3185	POWER GENERATION : COMPACT WAREHOUSE & WORKSHOP	C02	13/10/2020	ISSUED FOR CONSTRUCTION & REVISED AS MKD. C02	AMJ	SGC	SHD	PRI	
	PLAN, ELEVATION,SECTIONS & DETAILS (SHEET 2 OF 2)	C01	25/06/2020	ISSUED FOR CONSTRUCTION & REVISED AS MKD. C01	AMJ	SGC	SHD	PRI	
MD-216-49PR-EG-ME-GAD-V553-1057	COMPACT WORKSHOP & WAREHOUSE	A01	25/05/2020	ISSUED FOR APPROVAL	AMJ	SGC	SHD	PRI	

RESERVED FOR VENDOR LOGO AND DRAWING NUMBER

LARSEN & TOUBRO DRAWING NUMBER: 019045_008_C_G_24290_007 — REVISION: 6
OUTOTEC DRAWING NUMBER: 900707__GAU01__WG01__MTL01__45054 — DOCUMENT ID: OU100682330 — REVISION: 6

LARSEN & TOUBRO
This drawing is the property of LARSEN & TOUBRO and must not be passed on to any person or body not authorized by us to receive it nor be copied or otherwise made use either in full or in part by such person or body without our prior permission in writing.

Outotec
The content of these documents are the sole property of Outotec Oyj. Any rights not expressly granted herein are reserved. Reproduction, transfer or distribution of part or all of the contents in any form without prior written permission of Outotec is prohibited.

MA'ADEN معادن
Saudi Arabian Mining Company شركة معادن العربية السعودية
This document and the information contained herein is Ma'aden proprietary know-how. This document or any part thereof should not be reproduced, stored in a retrieval system or transmitted by any means, electronic or otherwise, or divulged without prior written permission of Ma'aden.

DRAWN	AMJ	30/03/2021
CHECKED	S	31/03/2021
ENGINEER	SHD	30/03/2021
APPROVED	PRI	31/03/2021
EMPLOYER		
SCALE	1:30	A1

MANSOURAH - MASSARAH GOLD PROJECT
GENERAL ARRANGEMENT
COMPACT WORKSHOP & WAREHOUSE
GA AND DETAIL OF GRADE SLAB

DRAWING NUMBER: MD-216-49PR-EG-CV-GAD-1624 — REV: D01