


DRAWING NUMBER: MD-216-3660-EG-CV-GAD-2004
REV: D01

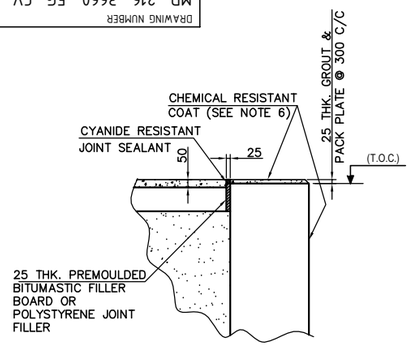


DETAIL - 'X'
SCALE 1:20

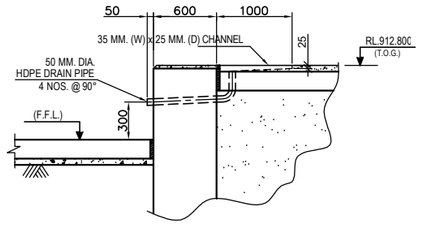


SECTION : B-B
SCALE 1:25

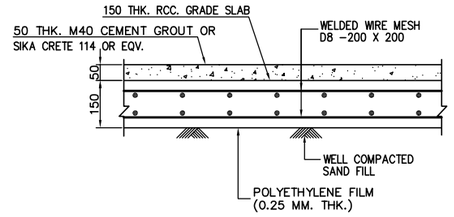


TYP. DET. OF 150 THK. GRADE SLAB
SCALE 1:10

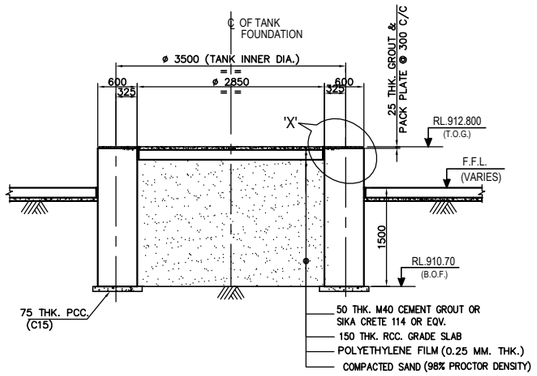


SECTION : A-A
SCALE 1:40

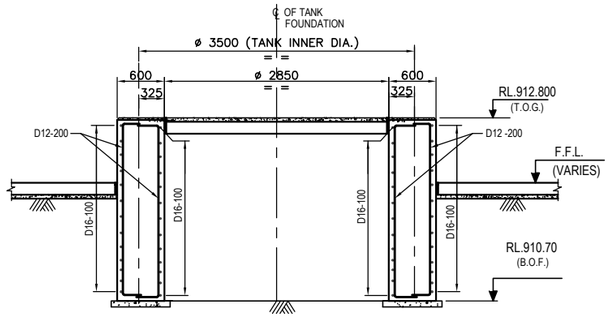

SECTION : B-B
SCALE 1:40

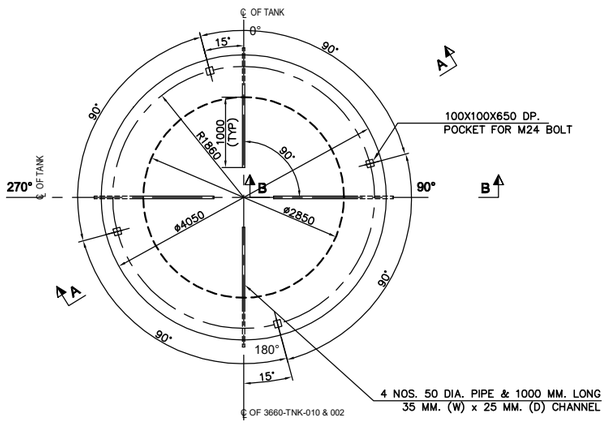

G.A.. DETAIL OF
TANK FOUNDATION MKD. F1
(FOR 3660-TNK-010 & 3660-TNK-002)
SCALE 1:40

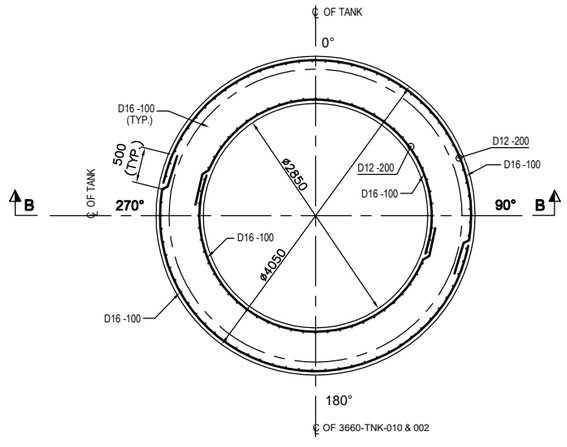

RCC. DETAIL OF
TANK FOUNDATION MKD. F1
SCALE 1:40

LEGEND :-

R.L. - REDUCED LEVEL
℄ - CENTRE LINE
T.O.C. - TOP OF CONCRETE
F.G.L. - FINISHED GROUND LEVEL
F.F.L. - FINISHED FLOOR LEVEL
B.O.F. - BOTTOM OF FOUNDATION
TYP. - TYPICAL
R.C.C - REINFORCED CEMENT CONCRETE
P.C.C - PLAIN CEMENT CONCRETE
MKD. - MARKED
I.D. - INTERNAL DIAMETER
THK. - THICK
T.O.G. - TOP OF GROUT
EQV. - EQUIVALENT
DET. - DETAIL
FDN. - FOUNDATION
HDPE - HIGH DENSITY POLYETHYLENE
Ø - DIAMETER
DIA. - DIAMETER
R - RADIUS
G.A. - GENERAL ARRANGEMENT
REGEN. - REGENERATION
HDPE - HIGH DENSITY POLYETHYLENE

NOTES:-

1. ALL DIMENSIONS ARE IN MILLIMETRES AND LEVELS AND CO-ORDINATES ARE IN METRES UNLESS OTHERWISE STATED.
2. GRADE OF CONCRETE SHALL BE C35 (35MPa) FOR FOUNDATION, C30 (30MPa) FOR GRADE SLAB & C15 (15MPa) FOR BLINDING CONCRETE.
3. GRADE OF REINFORCEMENT SHALL BE DEFORMED BAR 420 MPa (GRADE 60) - ASTM A615/A615M.
4. GRADE OF WELDED WIRE MESH SHALL BE GRADE 60 (fy = 420 MPa) ACCORDING TO A1064.
5. NET SAFE BEARING CAPACITY OF SOIL AT BOTTOM OF FOUNDATION IS CONSIDERED AS 450KN/ SQ. M.
6. CLEAR COVER TO REINFORCEMENT SHALL BE AS FOLLOWS
   a) FOUNDATION = 50 mm
   b) WALLS = 50mm
   c) SLAB = 20mm
7. FOR STANDARD REINFORCEMENT DETAIL & GENERAL NOTES FOR CIVIL WORKS REFER DRAWING NO. MD-216-1000-EG-CV-DED-1005 & 1001.
8. ACID/ALKALI RESISTANT COATING TO BE APPLIED ON ALL EXPOSED CONCRETE SURFACE.

DOCUMENT NUMBER	REFERENCE DOCUMENTS	REV	DATE	REVISION DESCRIPTION	DRN	CHK	ENG	APP	EMP
MD-216-3660-EG-ME-GAD-1035	3660-TNK-002 LG ELUTION TANK	D01	05/05/2023	AS - BUILT	TEC	BJB	TEC	SJM	
MD-216-3660-EG-ME-GAD-1004	3660-TNK-010 COPPER ELUATE TANK	C01	21/12/2020	ISSUED FOR CONSTRUCTION & REVISED AS PER EMPLOYER'S COMMENTS ON 17.12.2020 & REVISED AS MARKED (C01)	TEC	BJB	TEC	SJM	
MD-216-3660-EG-CV-GAD-2002	LAYOUT & DETAIL OF FOUNDATION	A01	07/11/2020	ISSUED FOR REFERENCE	TEC	BJB	TEC	SJM	

RESERVED FOR VENDOR LOGO AND DRAWING NUMBER

LARSEN & TOUBRO
This drawing is the property of LARSEN & TOUBRO and must not be passed on to any person or body not authorized by us to receive it nor be copied or otherwise made use either in full or in part by such person or body without our prior permission in writing.

Outotec
The content of these documents are the sole property of Outotec Oyj. Any rights not expressly granted herein are reserved. Reproduction, transfer or distribution of part or all of the contents in any form without prior written permission of Outotec is prohibited.

MA'ADEN معادن
Saudi Arabian Mining Company شركة التعدين العربية السعودية
This document and the information contained herein is Ma'aden proprietary know-how. This document or any part thereof should not be reproduced, stored in a retrieval system or transmitted by any means, electronic or otherwise, or divulged without prior written permission of Ma'aden.

LARSEN & TOUBRO DRAWING NUMBER: 019045_450_C_G_24448_003 — REVISION: 2
OUTOTEC DRAWING NUMBER: 900707 _GAU01 _EE13 _MTL01 _36649 — DOCUMENT ID: OU100705930 — REVISION: 2

DRAWN	TEC	04/11/2020	MANSOURAH - MASSARAH GOLD PROJECT
CHECKED	BJB	06/11/2020	GENERAL ARRANGEMENT DRAWING
ENGINEER	TEC	04/11/2020	**LOW GRADE ACID WASH/ELUTION/CARBON REGEN**
APPROVED	SJM	07/11/2020	**LAYOUT & DETAIL OF FOUNDATION**
EMPLOYER			
SCALE	1:40, 1:25, 1:20	A1	DRAWING NUMBER: MD - 216 - 3660 - EG - CV - GAD - 2004 — REV: D01

MA'ADEN معادن
Saudi Arabian Mining Company شركة التعدين العربية السعودية

BECHTEL

Mansourah Massarah Gold Project
Comment Resolution Log Sheet / Compliance Report

Outotec
LARSEN & TOUBRO

PROJECT: MANSOURAH MASSARAH GOLD PROJECT **PROJECT NO.: 216**
STAGE: 4 - PROJECT EXECUTION. **REVIEW LOG DOC. NO. & REV.:**
ACONEX REF. NO. & DATE: BECHTEL-WTRAN-007168, 17 December 2020
STATUS CODE: A - APPROVED, C - APPROVED WITH COMMENTS, R - REVISE & RESUBMIT & O - OTHERS (INFORMATION, REFERENCE, REVIEWED)

DOCUMENT NUMBER	Area / Title	Comment No.	PMC/PMT COMMENT DATE: 17 December 2020	Comment by	EPC Response DATE: 21 December 2020	Status	Remarks
			General Comments (cc)				
MD-216-3660-EG-CV-GAD-2004-A01	3660	1	Please make reference to coating specification	Mr. Doron Golan Bechtel	Noted & Incorporated.	Closed	