




SECTION 1–1
SCALE 1:50

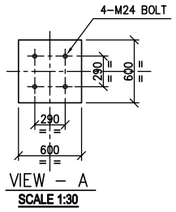


VIEW – A
SCALE 1:30

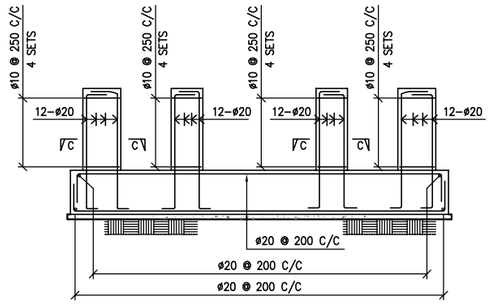


SECTION 1'–1'
SCALE 1:50

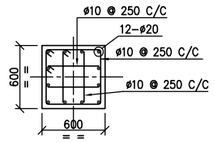


SECTION C–C
SCALE 1:30

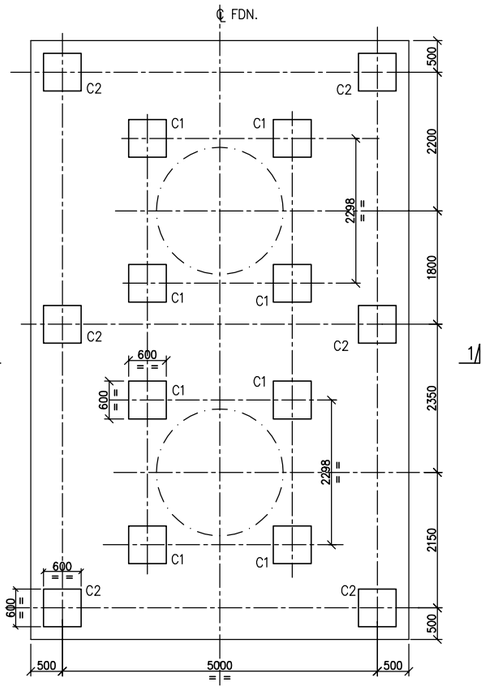

DETAIL OF FOUNDATION MKD. F3
SCALE 1:50

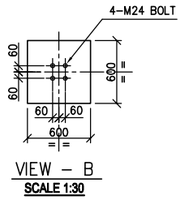

VIEW – B
SCALE 1:30

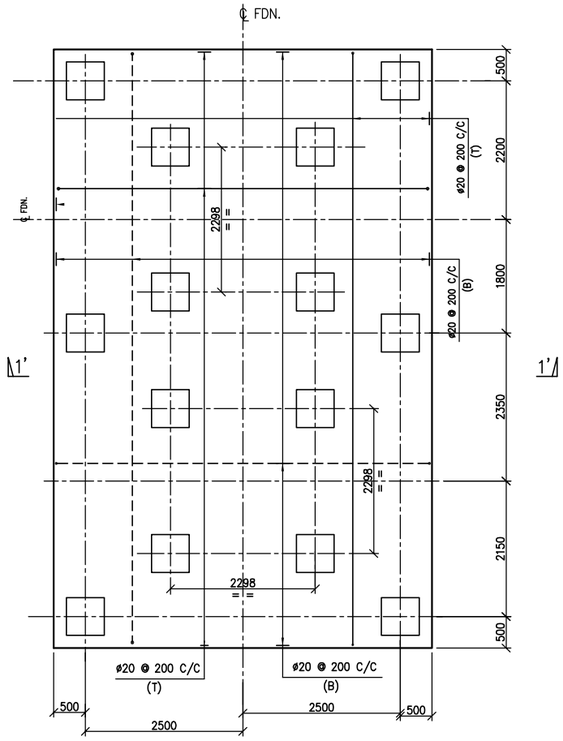

RC. DET. OF FOUNDATION MKD. F3
SCALE 1:50

LEGENDS :-

R.L. - REDUCED LEVEL
℄ - CENTRE LINE
T.O.C. - TOP OF CONCRETE
T.O.G. - TOP OF GROUT
TYP. - TYPICAL
F.G.L. - FINISHED GROUND LEVEL
F.F.L. - FINISHED FLOOR LEVEL
B.O.F. - BOTTOM OF FOUNDATION
MKD. - MARKED
THK. - THICK
BOTTOM REINFORCEMENT (B) - – – – –
TOP REINFORCEMENT (T) - ————
R.C. - REINFORCED CONCRETE
P.C.C - PLAIN CEMENT CONCRETE
FDN. - FOUNDATION
DET. - DETAIL
COL. - COLUMN
DIA. - DIAMETER
Ø - DIAMETER OF REINFORCEMENT
C/C - CENTER TO CENTER
REGEN. - REGENERATION

NOTES:-

1. ALL DIMENSIONS ARE IN MILLIMETRES AND LEVELS AND CO-ORDINATES ARE IN METRES UNLESS OTHERWISE STATED.
2. GRADE OF CONCRETE SHALL BE C35 (35MPa) FOR FOUNDATION & C15 (15MPa) FOR BLINDING CONCRETE.
3. GRADE OF REINFORCEMENT SHALL BE DEFORMED BAR 420 MPa (GRADE 60) - ASTM A615/A615M.
4. NET SAFE BEARING CAPACITY OF SOIL AT BOTTOM OF FOUNDATION CONSIDERED AS 450KN/ SQ. M
5. CLEAR COVER TO REINFORCEMENT SHALL BE FOUNDATIONS = 50 MM., COLUMNS = 50 MM.
6. FOR STANDARD REINFORCEMENT DETAIL & GENERAL NOTES FOR CIVIL WORKS REFER DRAWING NO. MD-216-1000-EG-CV-DED-1005 & 1001.

REFERENCE DOCUMENTS	REV	DATE	REVISION DESCRIPTION	DRN	CHK	ENG	APP	EMP
	D01	05/05/2023	AS-BUILT	TEC	BJB	TEC	SJM	
	C02	16/01/2021	ISSUED FOR CONSTRUCTION & REVISED AS MARKED (M2)	TEC	BJB	**TEC**	SJM	
	C01	21/12/2020	ISSUED FOR CONSTRUCTION	**TEC**	**BJB**	TEC	**SJM**	
MD-216-2660-EG-GAD-2002	A01	07/11/2020	ISSUED FOR REFERENCE	**TEC**	**BJB**	TEC	**SJM**	
LAYOUT AND R.C DETAIL OF FOUNDATIONS								

LARSEN & TOUBRO
This drawing is the property of LARSEN & TOUBRO and must not be passed on to any person or body not authorized by us to receive it nor be copied or otherwise made use either in full or in part by such person or body without our prior permission in writing.

Outotec
The content of these documents are the sole property of Outotec Oyj. Any rights not expressly granted herein are reserved. Reproduction, transfer or distribution of part or all of the contents in any form without prior written permission of Outotec is prohibited.

MA'ADEN معادن
Saudi Arabian Mining Company شركة معادن العربية السعودية
This document and the information contained herein is Ma'aden proprietary know-how. This document or any part thereof should not be reproduced, stored in a retrieval system or transmitted by any means, electronic or otherwise, or divulged without prior written permission of Ma'aden.

LARSEN & TOUBRO DRAWING NUMBER: 019045_450_C_G_24440_005 — REVISION: 3
OUTOTEC DRAWING NUMBER: 900707 _GAU01 _EE13 _MTL01 _36651 — DOCUMENT ID: OU100705932 — REVISION: 3

DRAWN	TEC	04/11/2020
CHECKED	BJB	06/11/2020
ENGINEER	TEC	04/11/2020
APPROVED	SJM	07/11/2020
EMPLOYER		
SCALE	1:30	A1

MANSOURAH - MASSARAH GOLD PROJECT
GENERAL ARRANGEMENT DRAWING
LOWGRADE ACID WASH/ELUTION/CARBON REGEN
LAYOUT & DETAIL OF FOUNDATION

DRAWING NUMBER: MD-216-3660-EG-CV-GAD-2006 — REV: D01