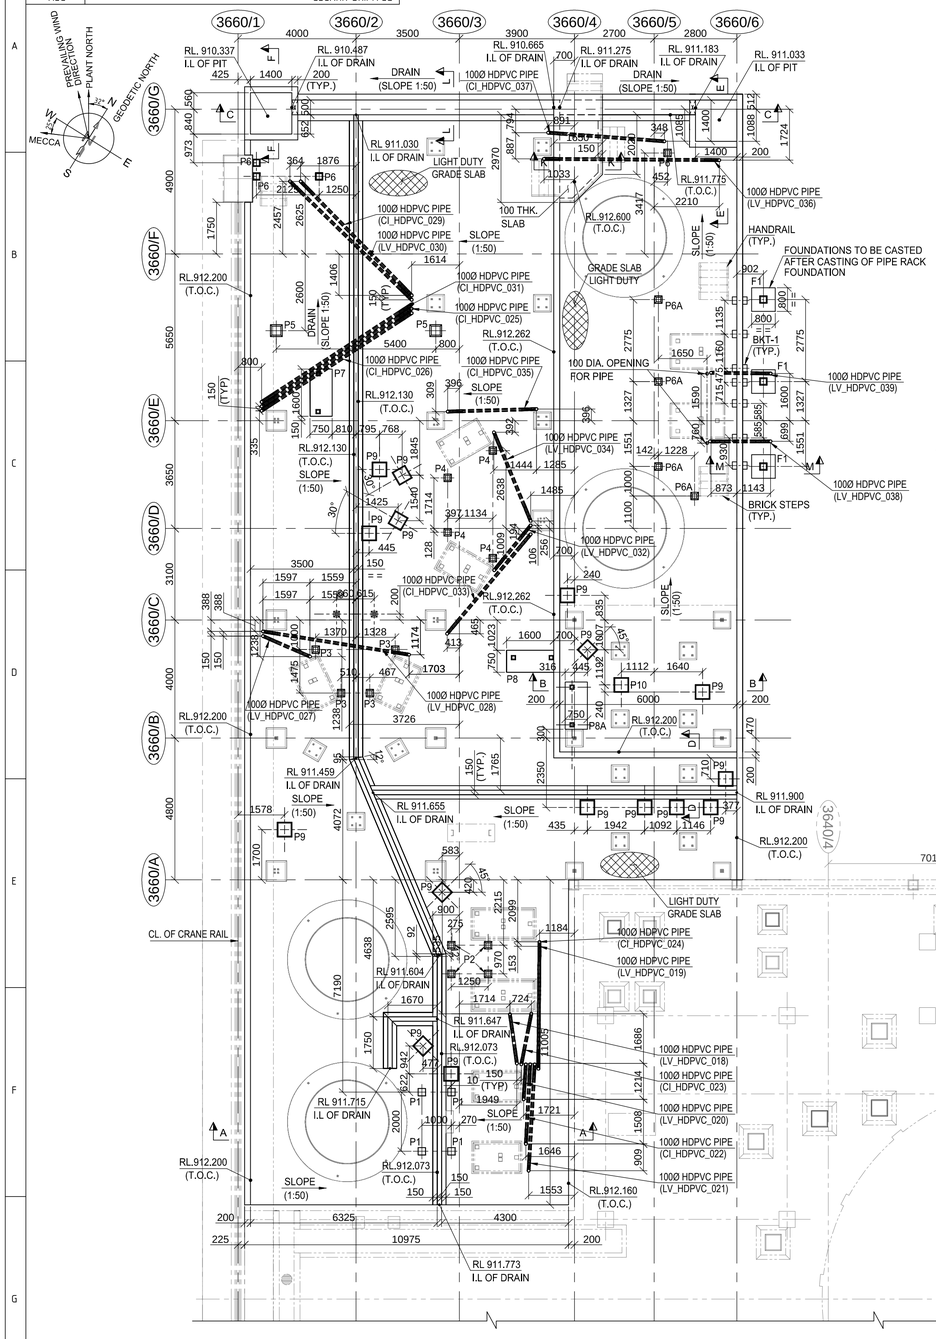
DRAWING NUMBER MD-216-3660-EG-CV-GAD-2009 REV D01





## LAYOUT OF GRADE SLAB
SCALE 1:100
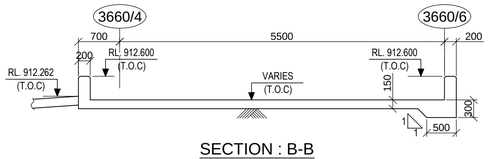
## SCHEDULE OF CONDUIT


| CONDUIT MKD. | ELEVATION AT ℄ OF CONDUIT |
|---|---|
| LV_HDPVC_018 | RL 911.075 |
| LV_HDPVC_019 | RL 911.075 |
| LV_HDPVC_020 | RL 911.075 |
| LV_HDPVC_021 | RL 911.075 |
| CI_HDPVC_022 | RL 911.225 |
| CI_HDPVC_023 | RL 911.225 |
| CI_HDPVC_024 | RL 910.875 |
| LV_HDPVC_025 | RL 910.950 |
| CI_HDPVC_026 | RL 910.950 |
| LV_HDPVC_027 | RL 911.250 |
| LV_HDPVC_028 | RL 911.150 |

## SCHEDULE OF CONDUIT


| CONDUIT MKD. | ELEVATION AT ℄ OF CONDUIT |
|---|---|
| CI_HDPVC_029 | RL 910.850 |
| LV_HDPVC_030 | RL 910.850 |
| LV_HDPVC_031 | RL 910.950 |
| LV_HDPVC_032 | RL 911.300 |
| CI_HDPVC_033 | RL 911.300 |
| LV_HDPVC_034 | RL 911.300 |
| CI_HDPVC_035 | RL 911.300 |
| LV_HDPVC_036 | RL 911.300 |
| CI_HDPVC_037 | RL 911.300 |
| LV_HDPVC_038 | RL 911.530 |
| LV_HDPVC_039 | RL 911.530 |





## SECTION : B-B
SCALE 1:50

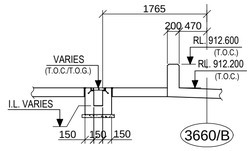


## SECTION : D-D
SCALE 1:50

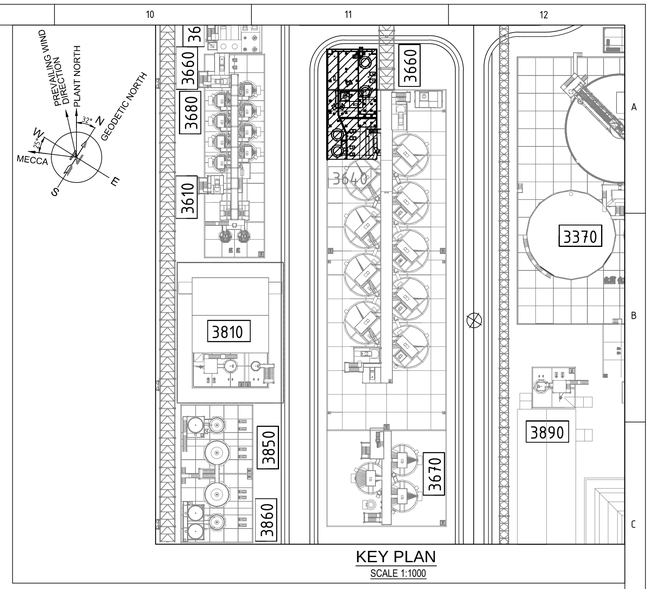


## KEY PLAN
SCALE 1:1000

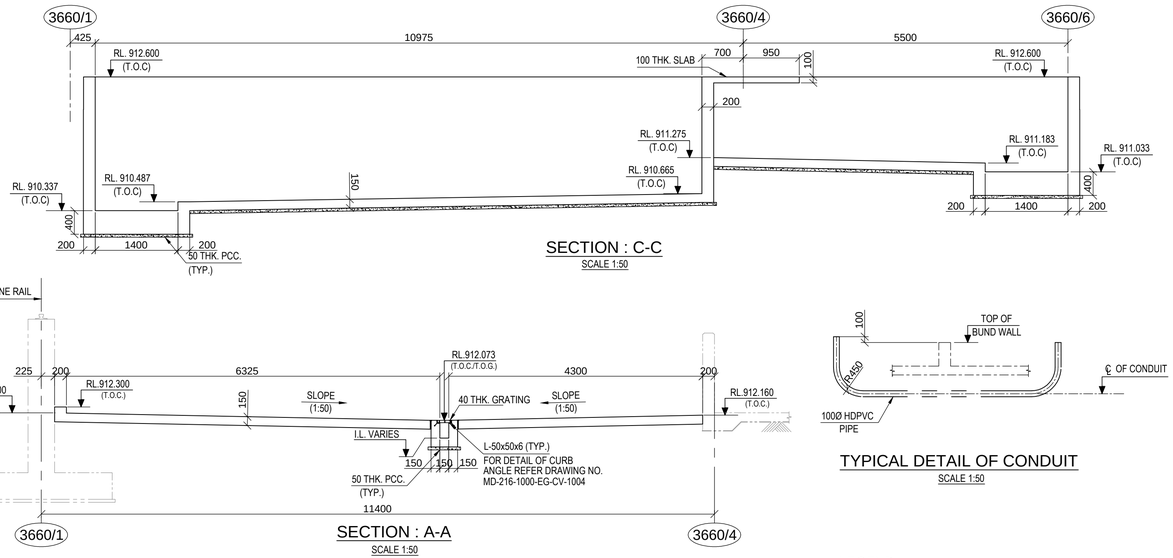



## SECTION : C-C
SCALE 1:50




## SECTION : A-A
SCALE 1:50



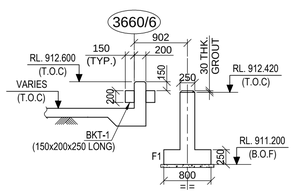
## TYPICAL DETAIL OF CONDUIT
SCALE 1:50




## SECTION : M-M
SCALE 1:50

## LEGEND :-
R.L. - REDUCED LEVEL
CL. - CENTRE LINE
I.L - INVERT LEVEL
F.G.L - FINISHED GROUND LEVEL
T.O.C. - TOP OF CONCRETE
P.C.C - PLAIN CEMENT CONCRETE
T.O.G. - TOP OF GRATING
THK. - THICK
TYP. - TYPICAL
REGEN. - REGENERATION
B.O.F. - BOTTOM OF FOUNDATION
DIA. - DIAMETER

## NOTES:-
1. ALL DIMENSIONS ARE IN MILLIMETRES AND LEVELS AND CO-ORDINATES ARE IN METRES UNLESS OTHERWISE STATED.
2. FOR DETAILS OF GRADE SLAB REFER DRAWING NO. MD-216-1000-EG-CV-DED-1002.
3. CHEMICAL RESISTANT COATING SHALL BE APPLIED FOR PROTECTING CONCRETE AGAINST CYANIDE, ACID & ALKALI.

| DOCUMENT NUMBER | REFERENCE DOCUMENTS | REV | DATE | REVISION DESCRIPTION | DRN | CHK | ENG | APP | EMP |
|---|---|---|---|---|---|---|---|---|---|
| MD-216-3660-EG-CV-GAD-2010 | DETAILS OF GRADE SLAB | | | | | | | | |
| MD-216-3640-EG-CV-GAD-1314 | LAYOUT & DETAIL OF GRADE SLAB | D01 | 16/03/2023 | AS-BUILT | ABS | AVG | TEC | SJM | |
| MD-216-1000-EG-ST-CRT-1001 | CIVIL, STRUCTURAL & ARCHITECTURAL - DESIGN CRITERIA | C02 | 13/04/2021 | ISSUED FOR CONSTRUCTION AND REVISED AS MKD. △C02 | ABS | AVG | TEC | SJM | |
| MD-216-3660-EG-ME-GAD-1044 | LOW GRADE ACID WASH/ELUTION/CARBON REGEN. | C01 | 04/02/2021 | ISSUED FOR CONSTRUCTION AND REVISED AS MKD. △C01 | ABS | BJB | TEC | SJM | |
| MD-216-3660-EG-ME-GAD-1039 | LOW GRADE ACID WASH/ELUTION/CARBON REGEN. | A01 | 05/01/2021 | ISSUED FOR REVIEW | ABS | BJB | TEC | SJM | |

RESERVED FOR VENDOR LOGO AND DRAWING NUMBER

LARSEN & TOUBRO

This drawing is the property of LARSEN & TOUBRO and must not be passed on to any person or body not authorized by us to receive it nor be copied or otherwise made use either in full or in part by such person or body without our prior permission in writing.

Outotec

The content of these documents are the sole property of Outotec Oyj. Any rights not expressly granted herein are reserved. Reproduction, transfer or distribution of part or all of the contents in any form without prior written permission of Outotec is prohibited.

MA'ADEN معادن
Saudi Arabian Mining Company شركة المعادن العربية السعودية

This document and the information contained herein is Ma'aden proprietary know-how. This document or any part thereof should not be reproduced, stored in a retrieval system or transmitted by any means, electronic or otherwise, or divulged without prior written permission of Ma'aden.

| | | |
|---|---|---|
| LARSEN & TOUBRO DRAWING NUMBER | 019045_450_C_G_24585_001 | REVISION 3 |
| OUTOTEC DRAWING NUMBER | 900707__GAU01__EE13__MTL01__36670 | DOCUMENT ID OU100711099 / REVISION 3 |

| | | |
|---|---|---|
| DRAWN | ABS | 26/12/2020 |
| CHECKED | BJB | 02/01/2021 |
| ENGINEER | TEC | 30/12/2020 |
| APPROVED | SJM | 05/01/2021 |
| EMPLOYER | | |
| SCALE | 1:100, 1:50 | A1 |

MANSOURAH - MASSARAH GOLD PROJECT
GENERAL ARRANGEMENT DRAWING
LOW GRADE ACID WASH/ELUTION/CARBON REGEN.
LAYOUT & DETAIL OF GRADE SLAB

DRAWING NUMBER MD-216-3660-EG-CV-GAD-2009 REV D01