


DRAWING NUMBER: MD-216-3660-EG-CV-GAD-2010 | REV: D01

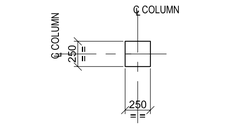


VIEW : 1-1
SCALE 1:30

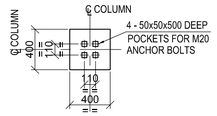


VIEW : 2-2
SCALE 1:30

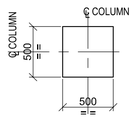


VIEW : 3-3
SCALE 1:30

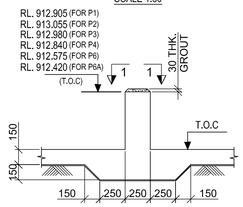


DETAIL OF P1,P2,P3
P4,P6 & P6A
SCALE 1:30

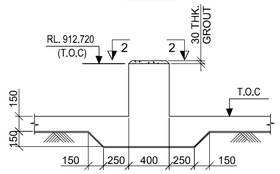


DETAIL OF P5
SCALE 1:30

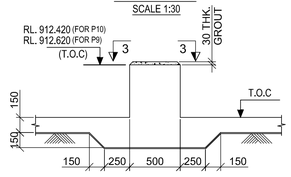


DETAIL OF P9, P10
SCALE 1:30

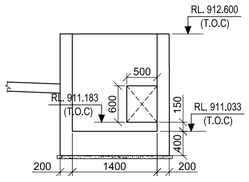


SECTION : E-E
SCALE 1:50

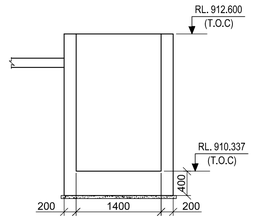


SECTION : F-F
SCALE 1:50

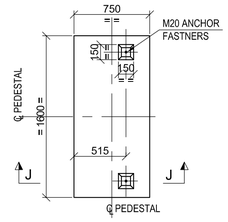


DETAIL OF PEDESTAL
MKD. P7, P8, P8A
(PEDESTAL ORIENTATION TREATED AS PER LAYOUT PLAN)
(SCALE - 1:30)

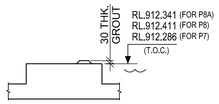


SECTION : J-J
(SCALE - 1:30)

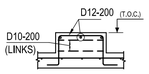


SECTION : J-J
(R.C DETAIL)
(SCALE - 1:30)

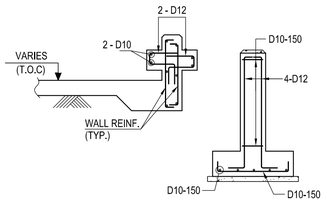


SECTION : M-M
(R.C DETAIL)
SCALE 1:30

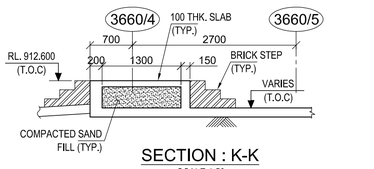


SECTION : K-K
SCALE 1:50

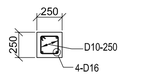


SECTION : G-G
SCALE 1:30

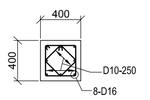


SECTION : H-H
(FOR P5)
SCALE 1:30

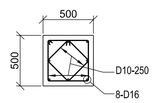


SECTION : H1-H1
(FOR P9)
SCALE 1:30

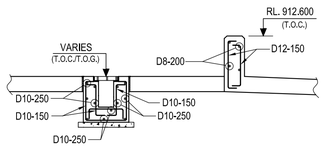


SECTION : D-D
(R.C DETAIL)
SCALE 1:30

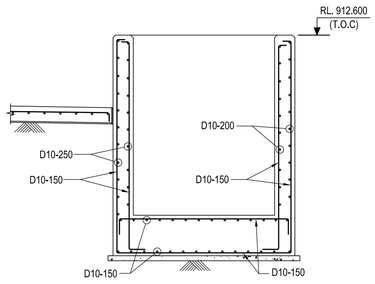


SECTION : E-E
SECTION : F-F
(RC. DETAIL)
SCALE 1:30

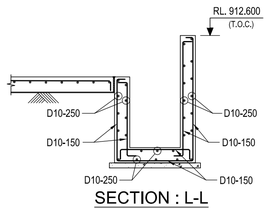


SECTION : L-L
(R.C DETAIL)
SCALE 1:30

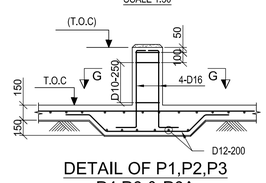

DETAIL OF P1,P2,P3
P4,P6 & P6A
(R.C DETAIL)
SCALE 1:30

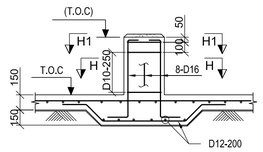

DETAIL OF P5, P9
(R.C DETAIL)
SCALE 1:30

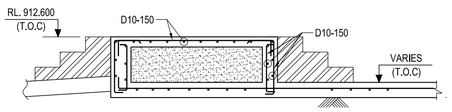

SECTION : K-K
(R.C DETAIL)
SCALE 1:30

LEGEND :-
R.L. - REDUCED LEVEL
℄ - CENTRE LINE
T.O.C. - TOP OF CONCRETE
F.G.L. - FINISHED GROUND LEVEL
TYP. - TYPICAL
R.C. - REINFORCED CONCRETE
P.C.C - PLAIN CEMENT CONCRETE
MKD. - MARKED
THK. - THICK
I.L. - INVERT LEVEL
REGEN. - REGENERATION
T.O.G. - TOP OF GRATING
REINF. - REINFORCEMENT

NOTES:-
1. ALL DIMENSIONS ARE IN MILLIMETRES AND LEVELS AND CO-ORDINATES ARE IN METRES UNLESS OTHERWISE STATED.
2. GRADE OF CONCRETE SHALL BE C30 (30MPa) FOR GRADE SLAB & C15 (15MPa) FOR BLINDING CONCRETE.
3. GRADE OF REINFORCEMENT SHALL BE DEFORMED BAR 420 MPa (GRADE 60) - ASTM A615/A615M.
4. CLEAR COVER TO REINFORCEMENT SHALL BE WALL - 40MM., SLAB - 25 MM., PEDESTAL - 40MM.
5. FOR STANDARD REINFORCEMENT DETAIL & GENERAL NOTES FOR CIVIL WORKS REFER DRAWING NO. MD-216-1000-EG-CV-DED-1005 & 1001.

DOCUMENT NUMBER	REFERENCE DOCUMENTS	REV	DATE	REVISION DESCRIPTION	DRN	CHK	ENG	APP	EMP
MD-216-3660-EG-CV-GAD-2009	LAYOUT & DETAIL OF GRADE SLAB								
MD-216-3640-EG-CV-GAD-1314	LAYOUT & DETAIL OF GRADE SLAB								
MD-216-1000-EG-ST-CRT-1001	CIVIL, STRUCTURAL & ARCHITECTURAL - DESIGN CRITERIA	D01	05/05/2023	AS-BUILT	ABS	BJB	TEC	SJM	
MD-216-3660-EG-ME-GAD-1044	LOW GRADE ACID WASH/ELUTION/CARBON REGEN.	C01	04/02/2021	ISSUED FOR CONSTRUCTION AND REVISED AS MKD. /C01	ABS	BJB	TEC	SJM	
MD-216-3660-EG-ME-GAD-1039	LOW GRADE ACID WASH/ELUTION/CARBON REGEN.	A01	05/01/2021	ISSUED FOR REVIEW	ABS	BJB	TEC	SJM	

RESERVED FOR VENDOR LOGO AND DRAWING NUMBER

LARSEN & TOUBRO

This drawing is the property of LARSEN & TOUBRO and must not be passed on to any person or body not authorized by us to receive it nor be copied or otherwise made use either in full or in part by such person or body without our prior permission in writing.

Outotec

The content of these documents are the sole property of Outotec Oyj. Any rights not expressly granted herein are reserved. Reproduction, transfer or distribution of part or all of the contents in any form without prior written permission of Outotec is prohibited.

MA'ADEN معادن
Saudi Arabian Mining Company شركة التعدين العربية السعودية

This document and the information contained herein is Ma'aden proprietary know-how. This document or any part thereof should not be reproduced, stored in a retrieval system or transmitted by any means, electronic or otherwise, or divulged without prior written permission of Ma'aden.

LARSEN & TOUBRO DRAWING NUMBER: 019045_450_C_G_24585_002 | REVISION: 2
OUTOTEC DRAWING NUMBER: 900707 _GAU01 _EE13 _MTL01 _36671 | DOCUMENT ID: OU100711100 | REVISION: 2

DRAWN	ABS	26/12/2020
CHECKED	BJB	02/01/2021
ENGINEER	TEC	30/12/2020
APPROVED	SJM	05/01/2021
EMPLOYER		
SCALE	1:100, 1:50, 1:30	A1

MANSOURAH - MASSARAH GOLD PROJECT
GENERAL ARRANGEMENT DRAWING
LOW GRADE ACID WASH/ELUTION/CARBON REGEN.
DETAILS OF GRADE SLAB

DRAWING NUMBER: MD - 216 - 3660 - EG - CV - GAD - 2010 | REV: D01