


DRAWING NUMBER MD - 216 - 3660 - EG - CV - GAD - 2011 REV D01

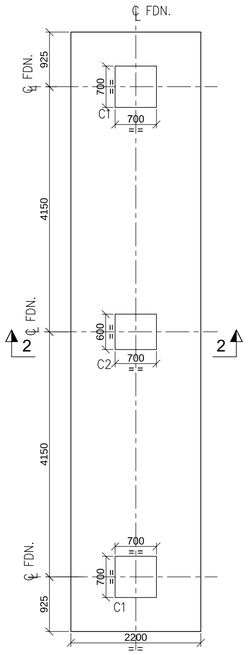


DET. OF FOUNDATION MKD. F2
SCALE 1:50

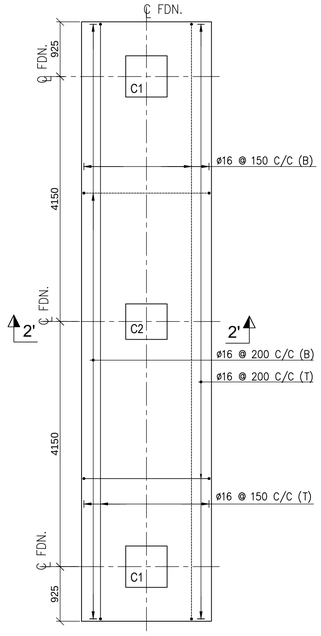


RC. DET. OF FOUNDATION MKD. F2
SCALE 1:50

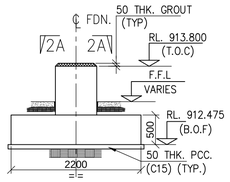


SECTION 2–2
SCALE 1:50

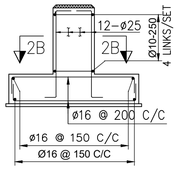


SECTION 2'–2'
SCALE 1:50

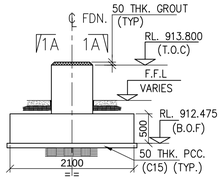


SECTION 1–1
SCALE 1:50

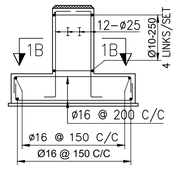


SECTION 1'–1'
SCALE 1:50

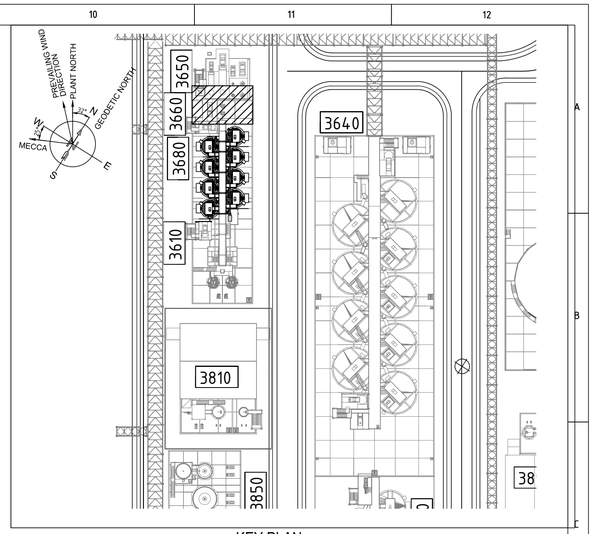


KEY PLAN
(SCALE- 1:750)

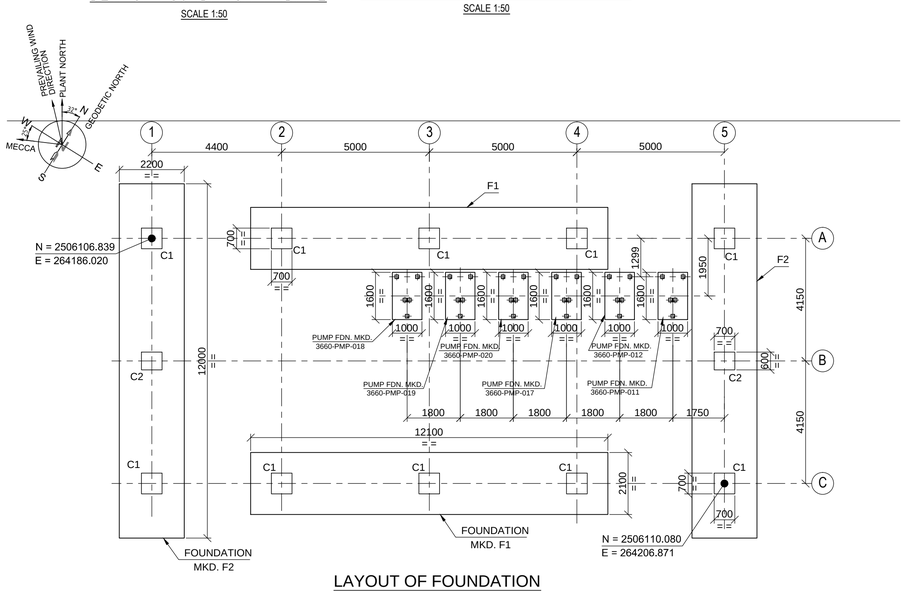


LAYOUT OF FOUNDATION
(SCALE 1:100)

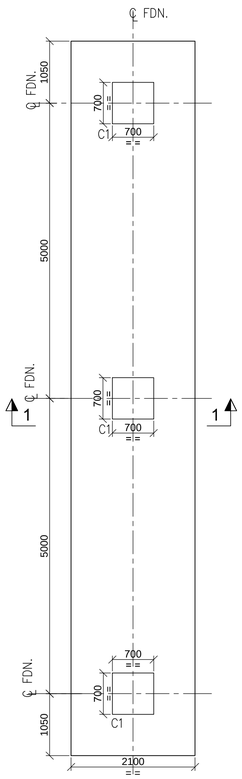


DET. OF FOUNDATION MKD. F1
SCALE 1:50

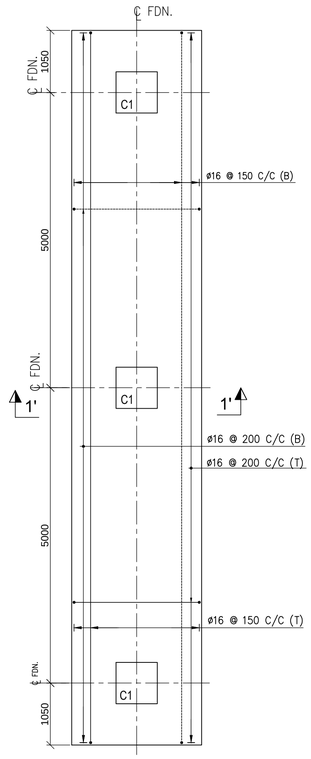


RC. DET. OF FOUNDATION MKD. F1
SCALE 1:30

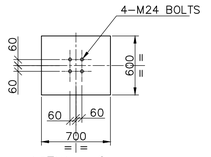


VIEW – 2A
SCALE 1:30

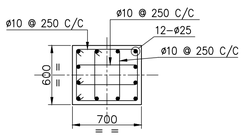

SECTION 2B–2B
SCALE 1:30

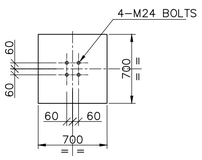

VIEW – 1A
SCALE 1:30

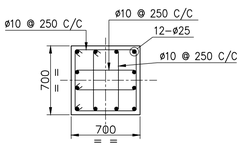

SECTION 1B–1B
SCALE 1:30

LEGEND :-

R.L. - REDUCED LEVEL
T.O.C. - TOP OF CONCRETE.
F.G.L. - FINISHED GROUND LEVEL.
F.F.L. - FINISHED FLOOR LEVEL.
B.O.F. - BOTTOM OF FOUNDATION
TYP. - TYPICAL.
P.C.D. - PITCH CIRCLE DIAMETER.
P.C.C. - PLAIN CEMENT CONCRETE
MKD. - MARKED.
THK. - THICK
EQV. - EQUIVALENT
Ø - DIAMETER
CJ - CONSTRUCTION JOINT
SQ - SQUARE
RCC. - REINFORCED CEMENT CONCRETE
DIA - DIAMETER
DRG. - DRAWING
℄ - CENTRE LINE
FDN. - FOUNDATION
R.C. - REINFORCED CEMENT CONCRETE
DET. - DETAIL
(T) - TOP
(B) - BOTTOM
C/C - CENTER TO CENTER
G.A. - GENERAL ARRANGEMENT
REGEN. - REGENERATION

NOTES :-

1. ALL DIMENSIONS ARE IN MILLIMETRES AND LEVELS AND CO-ORDINATES ARE IN METRES. UNLESS OTHERWISE STATED.
2. GRADE OF CONCRETE SHALL BE C35 FOR FOUNDATION.
3. GRADE OF REINFORCEMENT SHALL BE DEFORMED BAR ASTM A615 - GRADE 60 (fy = 420 MPa).
4. NET SAFE BEARING CAPACITY OF SOIL AT BOTTOM OF FOUNDATION IS CONSIDERED 450KN/ SQ. M.
5. IF ANY PART OF FOUNDATION COMES ON BACKFILL ZONE OF ADJACENT FOUNDATION OR ANY LOOSE SOIL ARE ENCOUNTERED BELOW FOUNDATION LEVEL THE SAME SHALL BE REMOVED AND FILLED WITH PCC.
6. SAND SHALL BE COMPACTED TO A MAXIMUM DEPTH OF 300MM AND SHALL BE COMPACTED TO 80% RELATIVE DENSITY AS DETERMINED BY ASTM D4253 AND ASTM D4254.
7. CHEMICAL RESISTANT COATING SHALL BE APPLIED FOR PROTECTING CONCRETE AGAINST ACID & ALKALI .

DOCUMENT NUMBER	REFERENCE DOCUMENTS			REVISION DESCRIPTION	DRN	CHK	ENG	APP	EMP
		D01	16/03/2023	AS-BUILT	SYA	SJM	SOR	AG	
MD-216-3660-EG-ME-GAD-V043-1009	GENERAL ARRANGEMENT DRAWING FOR PUMP	C03	25/06/2021	ISSUED FOR CONSTRUCTION AND REVISED AS MKD. C03	SYA	SJM	AVG	AG	
	3660-PMP-018, 019 & 020	C02	01/03/2021	ISSUED FOR CONSTRUCTION AND REVISED AS MKD. C02	ABS	BJB	TEC	SJM	
MD-216-3660-EG-ME-GAD-V043-1005	GENERAL ARRANGEMENT DRAWING FOR PUMP	C01	10/02/2021	ISSUED FOR CONSTRUCTION & REVISED AS MARKED C01	TEC	BJB	TEC	SJM	
	3660-PMP-011, 012 & 017	A01	08/01/2021	ISSUED FOR REVIEW	TEC	BJB	TEC	SJM	

LARSEN & TOUBRO

This drawing is the property of LARSEN & TOUBRO and must not be passed on to any person or body not authorized by us to receive it nor be copied or otherwise made use either in full or in part by such person or body without our prior permission in writing.

Outotec

The content of these documents are the sole property of Outotec Oyj. Any rights not expressly granted herein are reserved. Reproduction, transfer or distribution of part or all of the contents in any form without prior written permission of Outotec is prohibited.

MA'ADEN معادن
Saudi Arabian Mining Company شركة المعادن العربية السعودية

This document and the information contained herein is Ma'aden proprietary know-how. This document or any part thereof should not be reproduced, stored in a retrieval system or transmitted by any means, electronic or otherwise, or divulged without prior written permission of Ma'aden.

LARSEN & TOUBRO DRAWING NUMBER		REVISION
O19045_450_C_G_24420_001		4
OUTOTEC DRAWING NUMBER	DOCUMENT ID	REVISION
900707 __GAU01 __EE13 __MTL01 __36672	OU100711548	4

DRAWN	TEC	02/01/2021
CHECKED	BJB	04/01/2021
ENGINEER	TEC	02/01/2021
APPROVED	SJM	08/01/2021
EMPLOYER		
SCALE 1:100, 1:40	A1	

MANSOURAH - MASSARAH GOLD PROJECT
GENERAL ARRANGEMENT DRAWING
LOW GRADE ACID WASH/ELUTION/CARBON REGEN
G.A. & DETAILS OF FOUNDATION-1

DRAWING NUMBER MD - 216 - 3660 - EG - CV - GAD - 2011 REV D01