


DRAWING NUMBER	REV
MD - 216 - 3660 - EG - CV - GAD - 2013	D01

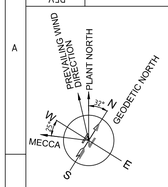


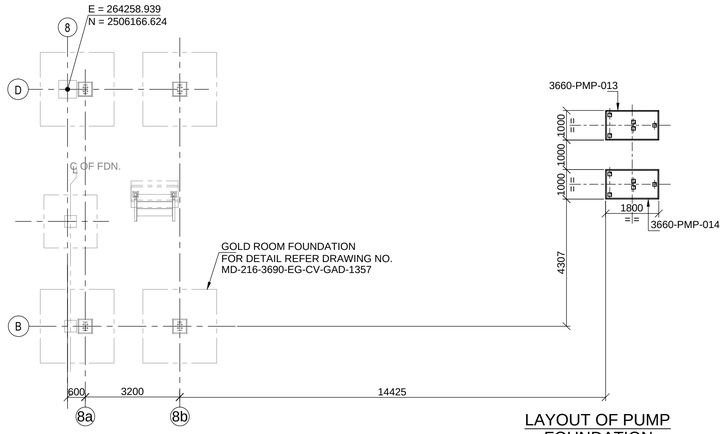


LAYOUT OF PUMP FOUNDATION
SCALE 1:100

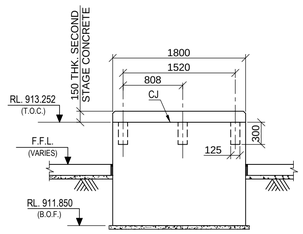


SECTION : A-A
SCALE 1:40

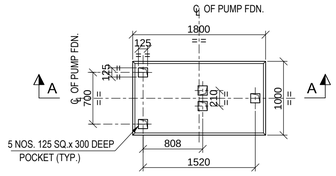


FDN. FOR PUMP MKD. 3660-PMP-013 & 014
SCALE 1:40

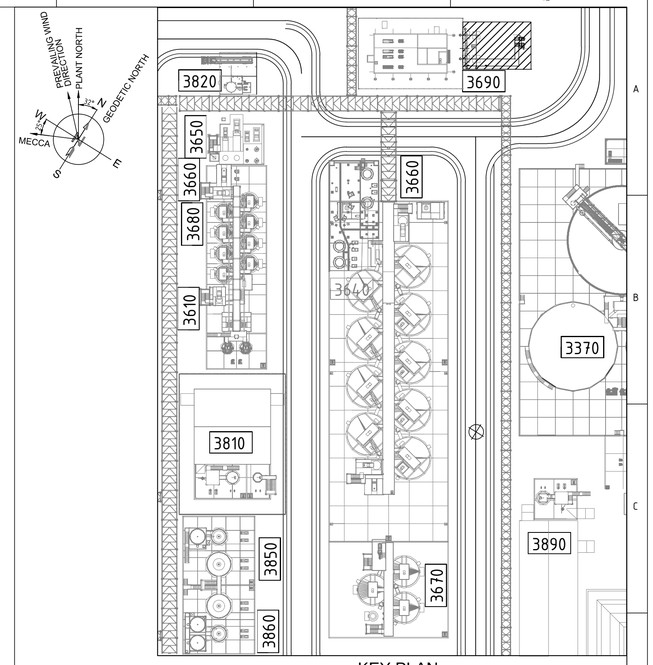


KEY PLAN
SCALE 1:1000

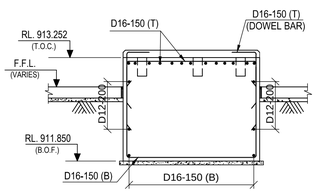


SECTION : B-B
SCALE 1:40

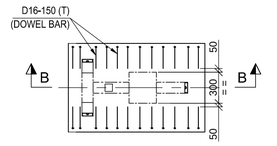

RC. DET. OF FDN. FOR PUMP MKD. 3660-PMP-013 & 014
(TOP VIEW OF SECOND STAGE CONCRETE)

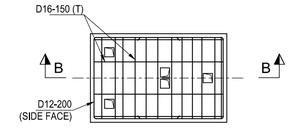

RC. DETAIL OF FDN. FOR PUMP MKD. 3660-PMP-013 & 014
(TOP VIEW OF FIRST STAGE CONCRETE)
SCALE 1:40

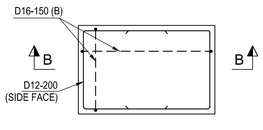

RC. DETAIL OF FDN. FOR PUMP MKD. 3660-PMP-013 & 014
(BOTTOM VIEW)
SCALE 1:40

LEGEND :-

R.L. - REDUCED LEVEL
℄ - CENTRE LINE
I.L - INVERT LEVEL
F.G.L - FINISHED GROUND LEVEL
T.O.C. - TOP OF CONCRETE
P.C.C - PLAIN CEMENT CONCRETE
T.O.G. - TOP OF GRATING
THK. - THICK
TYP. - TYPICAL
REGEN. - REGENERATION
R.C. - REINFORCED CONCRETE
MKD. - MARKED
FDN. - FOUNDATION
G.A. - GENERAL ARRANGEMENT

NOTES:-

1. ALL DIMENSIONS ARE IN MILLIMETRES AND LEVELS AND CO-ORDINATES ARE IN METRES UNLESS OTHERWISE STATED.
2. GRADE OF CONCRETE SHALL BE C30 (30MPa) FOR GRADE SLAB & C15 (15MPa) FOR BLINDING CONCRETE.
3. GRADE OF REINFORCEMENT SHALL BE DEFORMED BAR 420 MPa (GRADE 60) - ASTM A615/A615M.
4. CLEAR COVER TO REINFORCEMENT SHALL BE FOUNDATION - 40MM., SLAB - 25 MM.
5. FOR STANDARD REINFORCEMENT DETAIL & GENERAL NOTES FOR CIVIL WORKS REFER DRAWING NO. MD-216-1000-EG-CV-DED-1005 & 1001.
6. NET SAFE BEARING CAPACITY OF SOIL AT BOTTOM OF FOUNDATION IS CONSIDERED AS 350KN/ SQ. M.
7. FOR DETAIL OF ISOLATION GAP, REFER DRAWING NO. ND-216-1000-EG-CV-DED-1002

DOCUMENT NUMBER	REFERENCE DOCUMENTS	REV	DATE	REVISION DESCRIPTION	DRN	CHK	ENG	APP	EMP
MD-216-3660-EG-CV-GAD-2010	DETAILS OF GRADE SLAB	D01	16/03/2023	AS-BUILT	ABS	BJB	TEC	SJM	
MD-216-3640-EG-CV-GAD-1314	LAYOUT & DETAIL OF GRADE SLAB	C01	06/05/2021	ISSUED FOR CONSTRUCTION AND REVISED AS MKD. C01	ABS	BJB	TEC	SJM	
MD-216-1000-EG-ST-CRT-1001	CIVIL, STRUCTURAL & ARCHITECTURAL - DESIGN CRITERIA	A02	12/03/2021	REVISED AS PER EMPLOYER COMMENTS ON 02/03/2021	ABS	BJB	TEC	SJM	
MD-216-3660-EG-ME-GAD-1044	LOW GRADE ACID WASH/ELUTION/CARBON REGEN.			AND REVISED AS MKD. A02					
MD-216-3660-EG-ME-GAD-1039	LOW GRADE ACID WASH/ELUTION/CARBON REGEN.	A01	04/02/2021	ISSUED FOR REVIEW	ABS	BJB	TEC	SJM	

RESERVED FOR VENDOR LOGO AND DRAWING NUMBER

LARSEN & TOUBRO

This drawing is the property of LARSEN & TOUBRO and must not be passed on to any person or body not authorized by us to receive it nor be copied or otherwise made use either in full or in part by such person or body without our prior permission in writing.

Outotec

The content of these documents are the sole property of Outotec Oyj. Any rights not expressly granted herein are reserved. Reproduction, transfer or distribution of part or all of the contents in any form without prior written permission of Outotec is prohibited.

MA'ADEN معادن
Saudi Arabian Mining Company شركة المعادن العربية السعودية

This document and the information contained herein is Ma'aden proprietary know-how. This document or any part thereof should not be reproduced, stored in a retrieval system or transmitted by any means, electronic or otherwise, or divulged without prior written permission of Ma'aden.

LARSEN & TOUBRO DRAWING NUMBER			REVISION
O19045_450_C_G_24596_001			3
OUTOTEC DRAWING NUMBER		DOCUMENT ID	REVISION
900707 __GAU01 __EE13 __MTL01 __36674		OU100712279	3
DRAWN	ABS	25/01/2021	
CHECKED	BJB	28/01/2021	
ENGINEER	TEC	27/01/2021	
APPROVED	SJM	04/02/2021	
EMPLOYER			
SCALE	1:100, 1:50	A1	

MANSOURAH - MASSARAH GOLD PROJECT
GENERAL ARRANGEMENT DRAWING
LOW GRADE ACID WASH/ELUTION/CARBON REGEN.
G.A. & DETAILS OF PUMP FOUNDATION

DRAWING NUMBER	REV
MD - 216 - 3660 - EG - CV - GAD - 2013	D01