


DRAWING NUMBER	REV
MD-216-3660-EG-CV-GAD-2014	D01

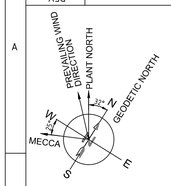


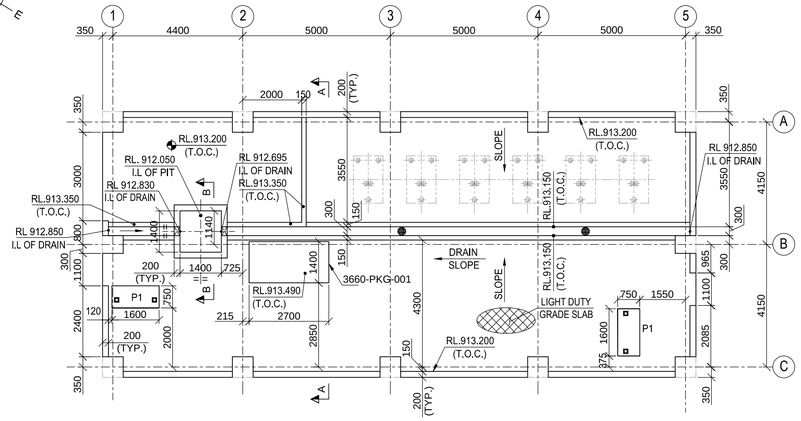


LAYOUT OF GRADE SLAB
SCALE 1:100

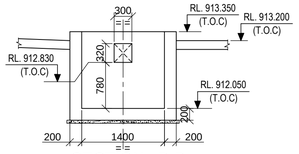


SECTION : B-B
SCALE 1:50

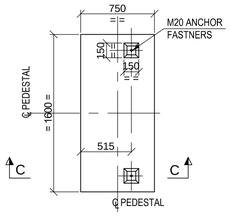


DETAIL OF PEDESTAL MKD. P1
(PEDESTAL ORIENTATION TREATED AS PER LAYOUT PLAN)
(SCALE - 1:30)

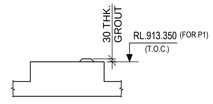

SECTION : C-C
(SCALE - 1:30)

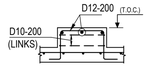


SECTION : C-C
(R.C DETAIL)
(SCALE - 1:30)

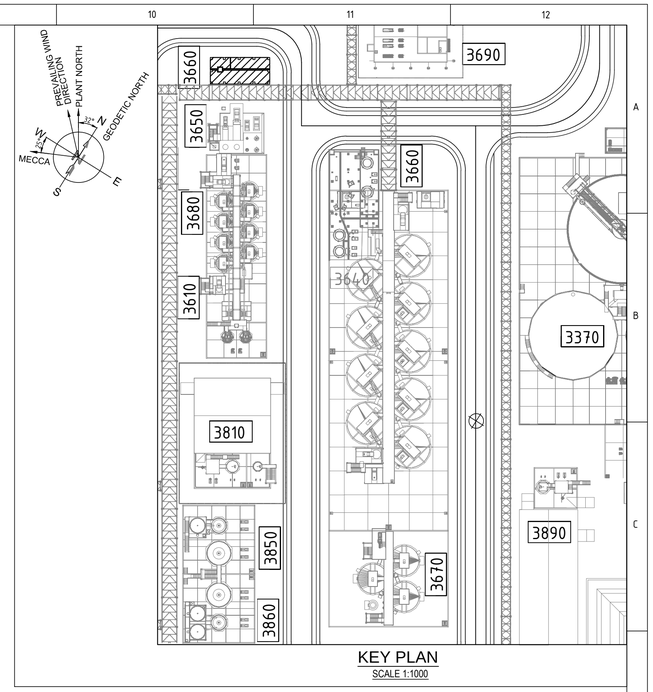


KEY PLAN
SCALE 1:1000

SECTION : A-A
SCALE 1:50

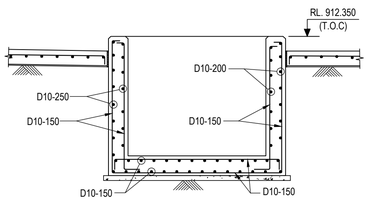

SECTION : B-B
(RC. DETAIL)
SCALE 1:30

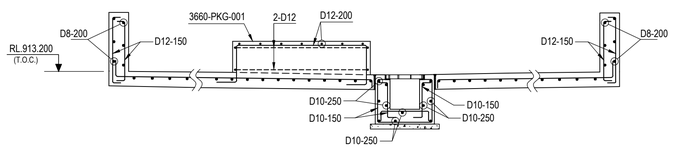

SECTION : A-A
(R.C DETAIL)
SCALE 1:30

LEGEND :-
R.L. - REDUCED LEVEL
℄ - CENTRE LINE
I.L. - INVERT LEVEL
F.G.L - FINISHED GROUND LEVEL
T.O.C. - TOP OF CONCRETE
P.C.C - PLAIN CEMENT CONCRETE
T.O.G. - TOP OF GRATING
THK. - THICK
TYP. - TYPICAL
REGEN. - REGENERATION
DRG. - DRAWING
R.C. - REINFORCED CONCRETE

NOTES:-
1. ALL DIMENSIONS ARE IN MILLIMETRES AND LEVELS AND CO-ORDINATES ARE IN METRES UNLESS OTHERWISE STATED.
2. FOR DETAILS OF GRADE SLAB REFER DRAWING NO. MD-216-1000-EG-CV-DED-1002.
3. CHEMICAL RESISTANT COATING SHALL BE APPLIED FOR PROTECTING CONCRETE AGAINST CYANIDE, ACID & ALKALI.
4. GRADE OF CONCRETE SHALL BE C30 (30MPa) FOR GRADE SLAB & C15 (15MPa) FOR BLINDING CONCRETE.
5. GRADE OF REINFORCEMENT SHALL BE DEFORMED BAR 420 MPa (GRADE 60) - ASTM A615/A615M.
6. CLEAR COVER TO REINFORCEMENT SHALL BE WALL - 40MM., SLAB - 25 MM., PEDESTAL - 40MM.
7. FINISHED GROUND LEVEL (F.G.L.) IS AT RL. 912.700
8. FOR STANDARD REINFORCEMENT DETAIL & GENERAL NOTES FOR CIVIL WORKS REFER DRAWING NO. MD-216-1000-EG-CV-DED-1005 & 1001.

DOCUMENT NUMBER	REFERENCE DOCUMENTS	REV	DATE	REVISION DESCRIPTION	DRN	CHK	ENG	APP	EMP
MD-216-3660-EG-CV-GAD-2011	GA. & DETAILS OF FOUNDATION-1								
MD-216-1000-EG-ST-CRT-1001	CIVIL, STRUCTURAL & ARCHITECTURAL - DESIGN CRITERIA	D01	16/03/2023	AS-BUILT	ABS	BJB	TEC	SJM	
MD-216-3660-EG-ME-GAD-1044	LOW GRADE ACID WASH/ELUTION/CARBON REGEN.	C01	06/05/2021	ISSUED FOR CONSTRUCTION	ABS	BJB	TEC	SJM	
MD-216-3660-EG-ME-GAD-1039	LOW GRADE ACID WASH/ELUTION/CARBON REGEN.	A01	22/02/2021	ISSUED FOR REVIEW	ABS	BJB	TEC	SJM	

RESERVED FOR VENDOR LOGO AND DRAWING NUMBER

LARSEN & TOUBRO

This drawing is the property of LARSEN & TOUBRO and must not be passed on to any person or body not authorized by us to receive it nor be copied or otherwise made use either in full or in part by such person or body without our prior permission in writing.

Outotec

The content of these documents are the sole property of Outotec Oyj. Any rights not expressly granted herein are reserved. Reproduction, transfer or distribution of part or all of the contents in any form without prior written permission of Outotec is prohibited.

MA'ADEN معادن
Saudi Arabian Mining Company شركة المعادن العربية السعودية

This document and the information contained herein is Ma'aden proprietary know-how. This document or any part thereof should not be reproduced, stored in a retrieval system or transmitted by any means, electronic or otherwise, or divulged without prior written permission of Ma'aden.

LARSEN & TOUBRO DRAWING NUMBER			REVISION
O19045_450_C_G_24596_002			2
OUTOTEC DRAWING NUMBER		DOCUMENT ID	REVISION
900707__GAU01__EE13__MTL01__36675		OU100712280	2

DRAWN	ABS	18/02/2021
CHECKED	BJB	21/02/2021
ENGINEER	TEC	18/02/2021
APPROVED	SJM	22/02/2021
EMPLOYER		
SCALE	1:100, 1:50	A1

MANSOURAH - MASSARAH GOLD PROJECT
GENERAL ARRANGEMENT DRAWING
LOW GRADE ACID WASH/ELUTION/CARBON REGEN.
LAYOUT & DETAIL OF GRADE SLAB

DRAWING NUMBER	REV
MD - 216 - 3660 - EG - CV - GAD - 2014	D01