


DRAWING NUMBER: MD - 216 - 3660 - EG - CV - GAD - 2015 | REV: D01

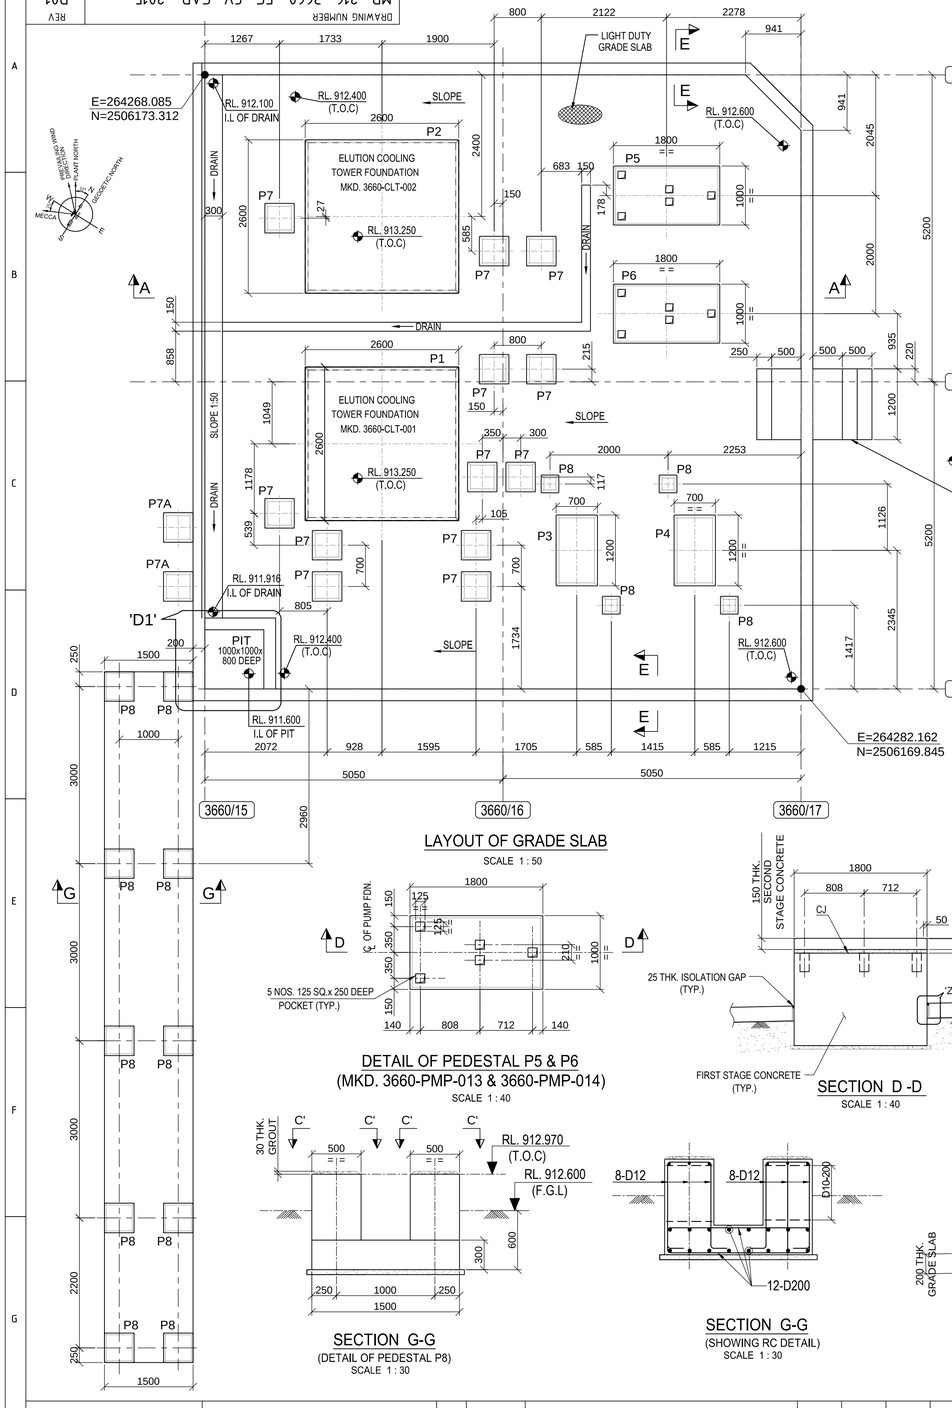


LAYOUT OF GRADE SLAB
SCALE 1 : 50

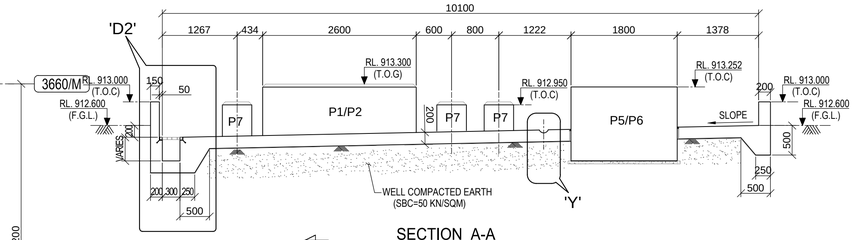


SECTION A-A
SCALE 1 : 50

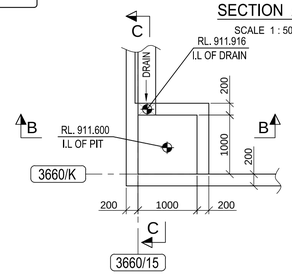


DETAIL - 'D1'
SCALE 1 : 50

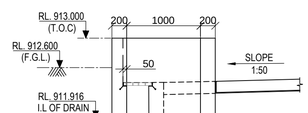


SECTION B - B
SCALE 1 : 40

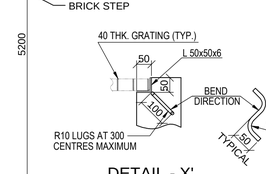


DETAIL - X'
(SCALE 1:10)

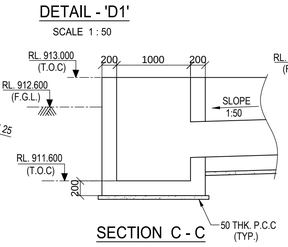


SECTION C - C
SCALE 1 : 40

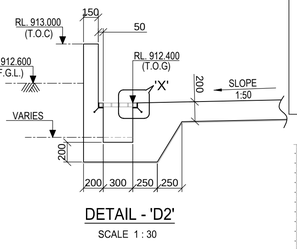


DETAIL - 'D2'
SCALE 1 : 30

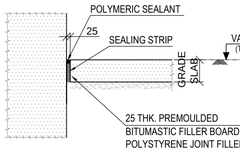

DETAIL - Z
(SCALE 1:20)

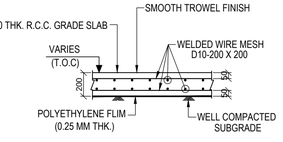


TYP. RC DETAIL OF 200 THK. LIGHT DUTY GRADE SLAB
SCALE 1:25

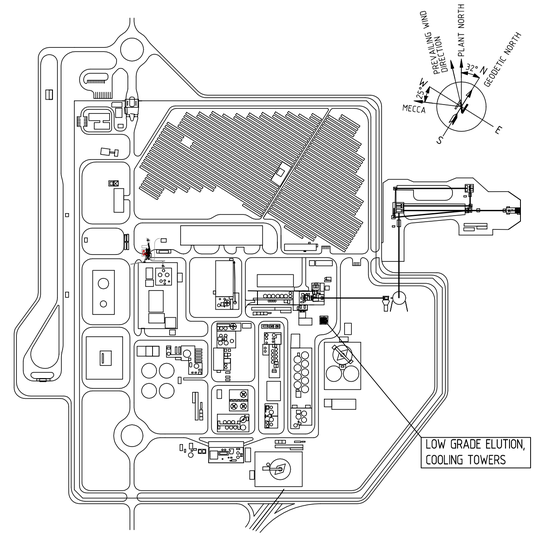


KEY PLAN
SCALE = 1:1000


DETAIL OF PEDESTAL P5 & P6
(MKD. 3660-PMP-013 & 3660-PMP-014)
SCALE 1 : 40

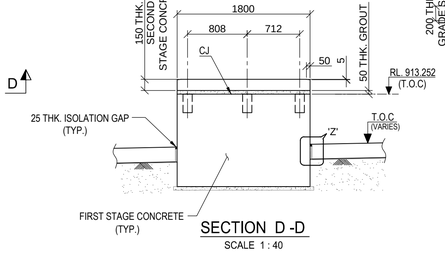


SECTION D -D
SCALE 1 : 40

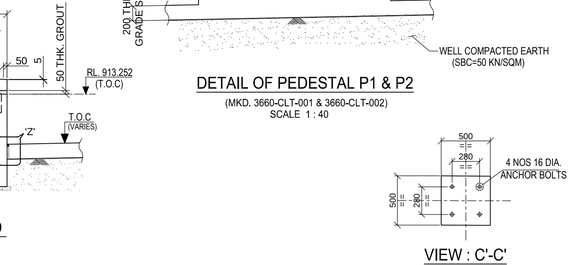


DETAIL OF PEDESTAL P1 & P2
(MKD. 3660-CLT-001 & 3660-CLT-002)
SCALE 1 : 40

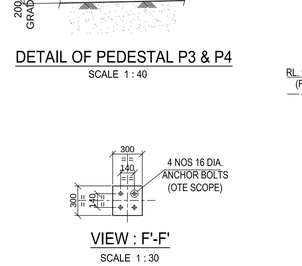

DETAIL OF PEDESTAL P3 & P4
SCALE 1 : 40

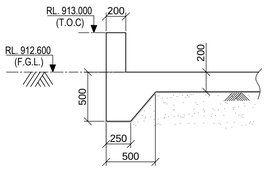

SECTION E-E
SCALE 1 : 30

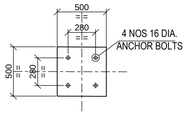


VIEW : C'-C'
SCALE 1 : 30


VIEW : F'-F'
SCALE 1 : 30

SECTION G-G
(DETAIL OF PEDESTAL P8)
SCALE 1 : 30


SECTION G-G
(SHOWING RC DETAIL)
SCALE 1 : 30

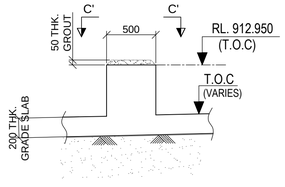


DETAIL OF PEDESTAL P7
SCALE 1 : 30

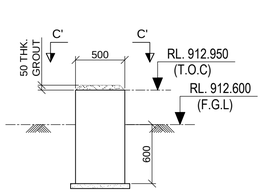

DETAIL OF PEDESTAL P7A
SCALE 1 : 30

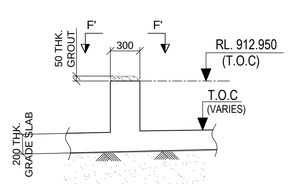

DETAIL OF PEDESTAL P8
SCALE 1 : 30

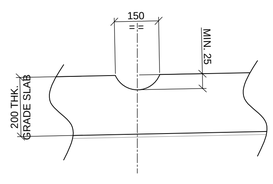

DETAIL - 'Y'
(SCALE 1:10)

LEGEND :-

CJ - CONSTRUCTION JOINT
F.G.L - FINISHED GROUND LEVEL
F.F.L - FINISHED FLOOR LEVEL
R.L. - REDUCED LEVEL
I.L - INVERT LEVEL
THK. - THICK
T.O.C - TOP OF CONCRETE
DIA - DIAMETER
DRG. - DRAWING
OPP - OPPOSITE
RC - REINFORCED CONCRETE
DET. - DETAIL
FDN. - FOUNDATION
MKD. - MARKED
TYP. - TYPICAL
℄ - CENTRE LINE
Ø - DIAMETER
R - RADIUS

NOTES:-

1. ALL DIMENSIONS ARE IN MILLIMETRES AND LEVELS AND CO-ORDINATES ARE IN METRES UNLESS OTHERWISE STATED.
2. NET SAFE BEARING CAPACITY OF SOIL AT BOTTOM OF FOUNDATION IS CONSIDERED AS 50 KN/ SQM.
3. GRADE OF CONCRETE SHALL BE C35 (35Mpa) FOR FOUNDATION, C30 (30Mpa) FOR GRADE SLAB & C15 (15Mpa) FOR BLINDING CONCRETE.
4. GRADE OF REINFORCEMENT SHALL BE DEFORMED BAR 420 MPa (GRADE 60) - ASTM A615/A615M.
5. FOR STANDARD REINFORCEMENT DETAIL & GENERAL NOTES FOR CIVIL WORKS REFER DRAWING NO. MD-216-1000-EG-CV-DED-1005 & 1001.
6. THIS DRG SHALL BE READ IN CONJUNCTION WITH DRG NO. MD-216-3660-EG-CV-DED-2002.
7. FOR DETAILS OF SLAB EDGE THICKENING AND RE-ENTRANT REBARS REFER MD-101-SMEM-EG-ST-DST-002 AND MD-101-SMEM-EG-ST-DST-007. FOR DETAILS OF SLAB JOINTS REFER MD-216-1000-EG-CV-DED-1002.

DOCUMENT NUMBER	REFERENCE DOCUMENTS			REVISION DESCRIPTION	DRN	CHK	ENG	APP	EMP
MD-216-3660-EG-IN-LAD-1014	LOW GRADE ACID WASH/ELUTION/CARBON REGEN. PLAN 14/14 AT EL(+) 912.00								
MD-216-3660-EG-ME-GAD-1016	LOW GRADE ELUTION, COOLING TOWERS	D01	16/03/2023	AS-BUILT	AMJ	SJM	AVG	AG	
	PLAN VIEW	C02	25/02/2022	ISSUED FOR CONSTRUCTION & REVISED AS MKD. C02	AMJ	SJM	AVG	AG	
MD-216-3660-EG-ME-GAD-1015	LOW GRADE ELUTION, COOLING TOWERS	C01	02/06/2021	REVISED AS PER EMPLOYER COMMENTS	AMJ	SJM	AVG	AG	
	PLAN VIEW			DATED 26/05/2021 & REVISED AS MKD. C01					
MD-216-1000-EG-ST-CRT-1001	CIVIL,STRUCTURAL AND ARCHITECTURAL DESIGN CRITERIA	A01	27/04/2021	ISSUED FOR REVIEW	AMJ	SJM	AVG	AG	

RESERVED FOR VENDOR LOGO AND DRAWING NUMBER

LARSEN & TOUBRO DRAWING NUMBER: 019045_450_C_G_24596_003 | REVISION: 3

OUTOTEC DRAWING NUMBER: 900707__GAU01__EE13__MTL01__36683 | DOCUMENT ID: OU100722490 | REVISION: 3

LARSEN & TOUBRO

This drawing is the property of LARSEN & TOUBRO and must not be passed on to any person or body not authorized by us to receive it nor be copied or otherwise made use either in full or in part by such person or body without our prior permission in writing.

Outotec

The content of these documents are the sole property of Outotec Oyj. Any rights not expressly granted herein are reserved. Reproduction, transfer or distribution of part or all of the contents in any form without prior written permission of Outotec is prohibited.

MA'ADEN معادن
Saudi Arabian Mining Company شركة التعدين العربية السعودية

This document and the information contained herein is Ma'aden proprietary know-how. This document or any part thereof should not be reproduced, stored in a retrieval system or transmitted by any means, electronic or otherwise, or divulged without prior written permission of Ma'aden.

DRAWN	AMJ	20/04/2021
CHECKED	SJM	21/04/2021
ENGINEER	AVG	20/04/2021
APPROVED	AG	27/04/2021
EMPLOYER		
SCALE	1:75, 1:25 & 1:15	A1

MANSOURAH - MASSARAH GOLD PROJECT
GENERAL ARRANGEMENT DRAWING
LOW GRADE ELUTION, COOLING TOWER
LAYOUT & DETAILS OF FOUNDATIONS AND GRADE SLAB

DRAWING NUMBER: MD - 216 - 3660 - EG - CV - GAD - 2015 | REV: D01