


DRAWING NUMBER
MD-216-3690-EG-CV-DED-1365
REV D01

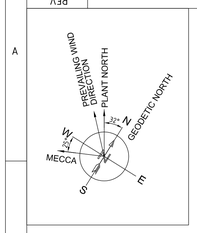


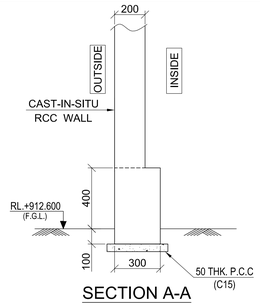


SECTION A-A
SCALE 1:20

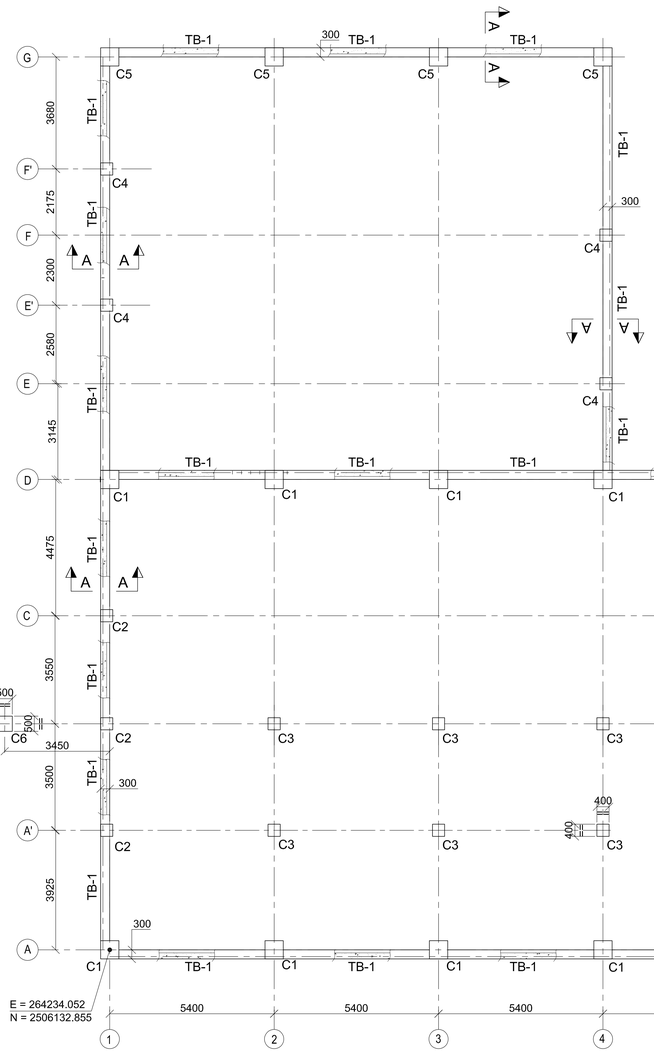


LAYOUT OF TIE BEAM AND COLUMN
SCALE 1:100

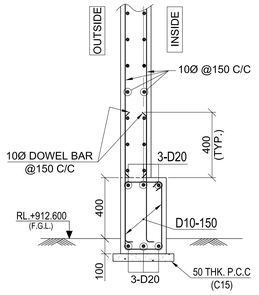

SECTION A-A (RC DETAIL)
SCALE 1:20

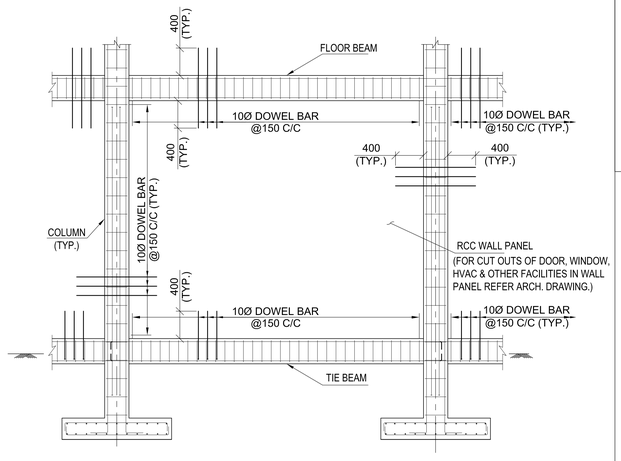

TYP. DETAIL OF RC WALL PANEL SHOWING DOWEL BARS
SCALE 1:50

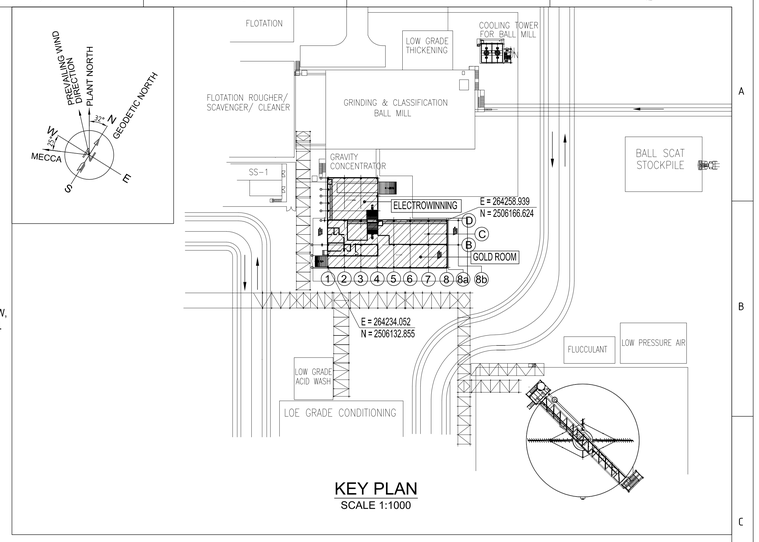

KEY PLAN
SCALE 1:1000

SCHEDULE OF COLUMN

COLUMN MKD.	SIZE	CROSS SECTION	FROM	TO
C1	600 x 600	600 x 600, 12-D20, D10@300	TOP OF FOOTING	RL+ 924.476
C2	400 x 400	400 x 400, 8-D16, D10@300	TOP OF FOOTING	RL+ 924.476
C3, C3A & C3B	400 x 400	400 x 400, 8-D16, D10@300	TOP OF FOOTING	RL+ 918.332 FOR C3 RL +918.232 FOR C3A RL +918.240 FOR C3B
C4	400 x 400	400 x 400, 8-D16, D10@300	TOP OF FOOTING	RL+921.476
C5	600 x 600	600 x 600, 12-D20, D10@300	TOP OF FOOTING	RL +921.476
C6	500 x 500	500 x 500, 8-D20, D10@300	TOP OF FOOTING	RL +913.425

LEGEND :-

R.L. - REDUCED LEVEL
P.C.C - PLAIN CEMENT CONCRETE
R.C - REINFORCED CONCRETE

NOTES:-

1. GRADE OF CONCRETE SHALL BE 35 MPa FOR RCC, 15 MPa FOR BLINDING CONCRETE.
2. GRADE OF REINFORCEMENT SHALL BE DEFORMED BAR 420 MPa (GRADE 60) - ASTM A615/A615M.
3. CLEAR COVER TO MAIN REINFORCEMENT SHALL BE COLUMN - 50MM., BEAM - 25 MM. & WALL - 20 MM
4. THIS DRAWING SHOULD BE READ WITH DRAWING NO. MD-216-3690-EG-CV-GAD-1357,1358,1359,1360,1361 MD-216-3690-EG-CV-DED-1364,1366,1367,1368

DOCUMENT NUMBER	REFERENCE DOCUMENTS	REV	DATE	REVISION DESCRIPTION	DRN	CHK	ENG	APP	EMP
		D01	22/03/2023	AS-BUILT	AUD	SJM	SNM	PRI	
MD-216-3690-EG-ST-GAD-1002	PLAN AT +925.251, SECTION A-A, B-B AND C-C	C03	09/01/2020	ISSUED FOR CONSTRUCTION & REVISED AS MARKED C03	AUD	SJM	SNM	PRI	
MD-216-3690-EG-ST-GAD-1001	PLAN AT +925.251, SECTION A-A - E-E	C02	10/12/2020	ISSUED FOR CONSTRUCTION & REVISED AS MARKED	AUD	SJM	SNM	PRI	
MD-216-3690-EG-CV-GAD-1002	PLAN AT EL. +913.100 GOLD ROOM AND ELECTROWINNING	C01	24/09/2020	ISSUED FOR CONSTRUCTION	AUD	SJM	SNM	PRI	
MD-216-3690-EG-CV-GAD-1001	PLAN AT EL. +913.100 GOLD ROOM AND ELECTROWINNING	A01	30/05/2020	ISSUED FOR REFERENCE	AUD	SJM	SNM	PRI	

RESERVED FOR VENDOR LOGO AND DRAWING NUMBER

LARSEN & TOUBRO DRAWING NUMBER: 019045_450_C_D_24146_002 — REVISION: 4
OUTOTEC DRAWING NUMBER: 900707__GAU01__EE14__CTB17__36902 — DOCUMENT ID: OU100684634 — REVISION: 4

LARSEN & TOUBRO
This drawing is the property of LARSEN & TOUBRO and must not be passed on to any person or body not authorized by us to receive it nor be copied or otherwise made use either in full or in part by such person or body without our prior permission in writing.

Outotec
The content of these documents are the sole property of Outotec Oyj. Any rights not expressly granted herein are reserved. Reproduction, transfer or distribution of part or all of the contents in any form without prior written permission of Outotec is prohibited.

MA'ADEN معادن
Saudi Arabian Mining Company شركة معادن العربية السعودية
This document and the information contained herein is Ma'aden proprietary know-how. This document or any part thereof should not be reproduced, stored in a retrieval system or transmitted by any means, electronic or otherwise, or divulged without prior written permission of Ma'aden.

DRAWN	AUD	20/05/2020	MANSOURAH - MASSARAH GOLD PROJECT
CHECKED	SJM	25/05/2020	DETAILED DRAWING
ENGINEER	SNM	10/05/2020	GOLD ROOM
APPROVED	PRI	27/05/2020	LAYOUT & DETAILS OF TIE BEAM & COLUMN
EMPLOYER			
SCALE	1:100	A1	DRAWING NUMBER: MD-216-3690-EG-CV-DED-1365 — REV: D01