


DRAWING NUMBER: MD-216-3690-EG-CV-DED-1367 | REV: D01

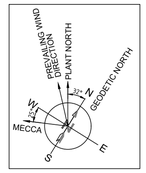


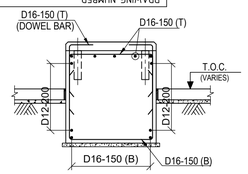


SECTION : B-B
SCALE 1:40

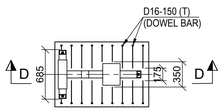


RC. DET. OF FDN. FOR PUMP MKD.
3680-PMP-003,004
(TOP VIEW OF SECOND STAGE CONCRETE)

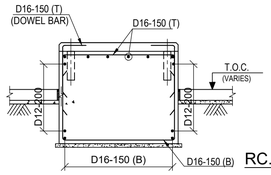


SECTION : C-C
SCALE 1:40

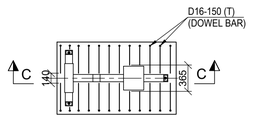


RC. DET. OF FDN. FOR PUMP MKD.
3680-PMP-005,006
(TOP VIEW OF SECOND STAGE CONCRETE)

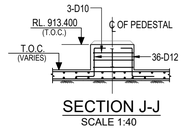


SECTION J-J
SCALE 1:40

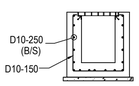


SECTION B1-B1 (RC DET.)
SCALE 1:30

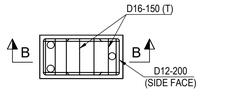


RC. DET. OF FDN. FOR PUMP MKD.
3680-PMP-003,004
(TOP VIEW OF FIRST STAGE CONCRETE)

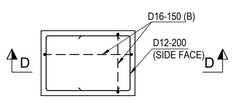


RC. DET. OF FDN. FOR PUMP MKD.
3680-PMP-003,004
(BOTTOM VIEW)
SCALE 1:40

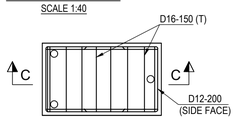


RC. DET. OF FDN. FOR PUMP MKD.
3680-PMP-005,006
(TOP VIEW OF FIRST STAGE CONCRETE)

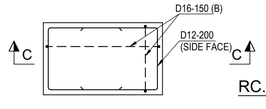


RC. DET. OF FDN. FOR PUMP MKD.
3680-PMP-005,006
(BOTTOM VIEW)
SCALE 1:40

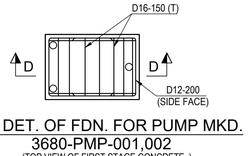


RC. DET. OF FDN. FOR PUMP MKD.
3680-PMP-001,002
(TOP VIEW OF FIRST STAGE CONCRETE)

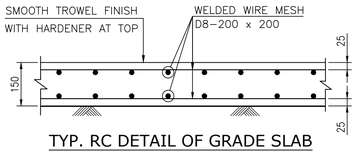


TYP. RC DETAIL OF GRADE SLAB
(FLOOR LOAD 15KN/SQM. TO 50KN/SQM.)
SCALE-1:10

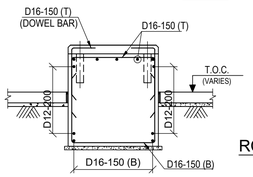


SECTION : D-D
SCALE 1:40

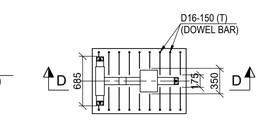

RC. DET. OF FDN. FOR PUMP MKD.
3680-PMP-001,002
(TOP VIEW OF SECOND STAGE CONCRETE)

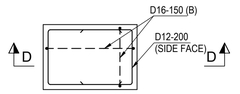


RC. DET. OF FDN. FOR PUMP MKD.
3680-PMP-001,002
(BOTTOM VIEW)
SCALE 1:40

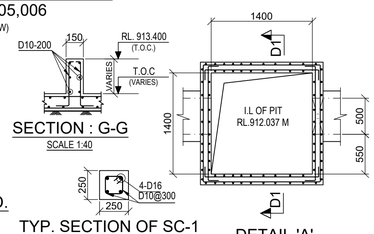


SECTION : G-G
SCALE 1:40

TYP. SECTION OF SC-1
SCALE 1:25
(RC DETAILS)

DETAIL 'A'
SCALE 1:40

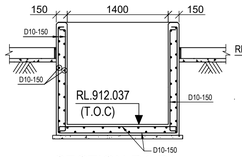

SECTION D1-D1
(RC DETAILS)
SCALE 1:40

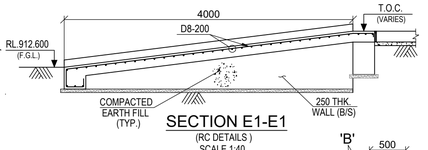


SECTION E1-E1
(RC DETAILS)
SCALE 1:40


SECTION K-K
SCALE 1:40

SECTION : A-A
(RC DETAILS)
SCALE 1:40


SECTION : A1-A1
(RC DETAILS)
SCALE 1:40

DETAIL : 'B'
SCALE 1:10

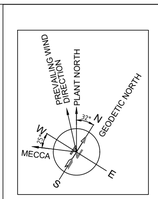

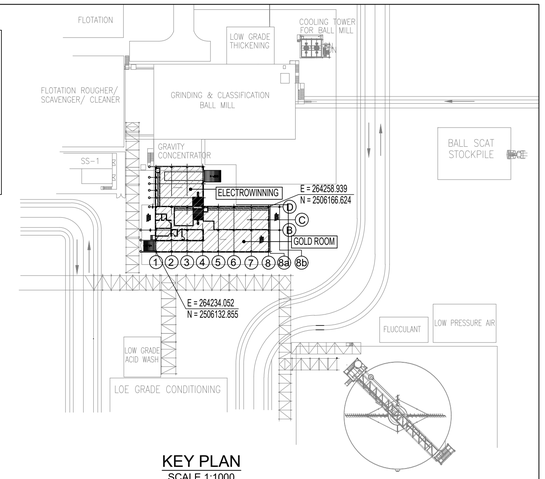

KEY PLAN
SCALE 1:1000

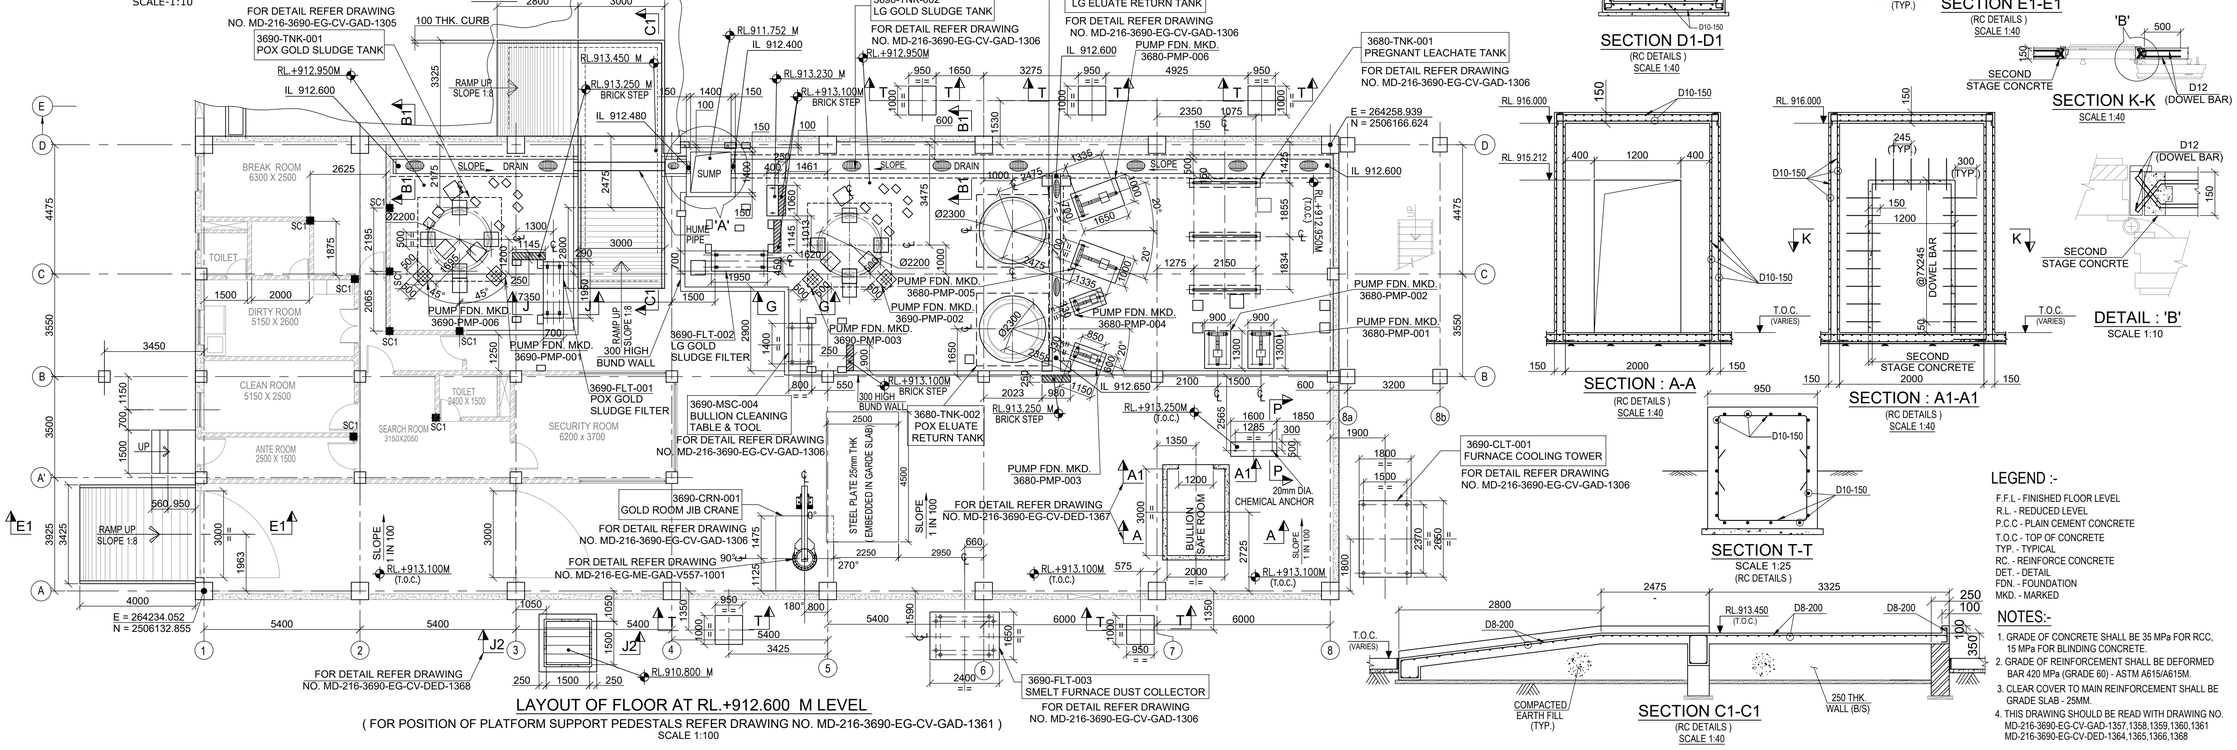

LAYOUT OF FLOOR AT RL.+912.600 M LEVEL
(FOR POSITION OF PLATFORM SUPPORT PEDESTALS REFER DRAWING NO. MD-216-3690-EG-CV-GAD-1361)
SCALE 1:100

SECTION C1-C1
(RC DETAILS)
SCALE 1:40

LEGEND :-

F.F.L - FINISHED FLOOR LEVEL
R.L. - REDUCED LEVEL
P.C.C - PLAIN CEMENT CONCRETE
T.O.C - TOP OF CONCRETE
TYP. - TYPICAL
RC. - REINFORCE CONCRETE
DET. - DETAIL
FDN. - FOUNDATION
MKD. - MARKED

NOTES:-

1. GRADE OF CONCRETE SHALL BE 35 MPa FOR RCC, 15 MPa FOR BLINDING CONCRETE.
2. GRADE OF REINFORCEMENT SHALL BE DEFORMED BAR 420 MPa (GRADE 60) - ASTM A615/A615M.
3. CLEAR COVER TO MAIN REINFORCEMENT SHALL BE GRADE SLAB - 25MM.
4. THIS DRAWING SHOULD BE READ WITH DRAWING NO. MD-216-3690-EG-CV-GAD-1357,1358,1359,1360,1361 MD-216-3690-EG-CV-DED-1364,1365,1366,1368

DOCUMENT NUMBER	REFERENCE DOCUMENTS	REV	DATE	REVISION DESCRIPTION	DRN	CHK	ENG	APP	EMP
MD-216-3960-EG-ME-GAD-1018	GOLD ROOM & ELECTROWINNING & ICL : SECTION C-C								
MD-216-3960-EG-ME-GAD-1008	GOLD ROOM & ELECTROWINNING & ICL : SECTION B-B								
MD-216-3960-EG-ME-GAD-1007	GOLD ROOM & ELECTROWINNING & ICL : SECTION A-A								
MD-216-3960-EG-ME-GAD-1006	GOLD ROOM & ELECTROWINNING & ICL : PLAN AT EL+918.850 & EL+925.450	D01	20/03/2023	AS BUILT	AUD	SJM	SNM	AG	
MD-216-3960-EG-ME-GAD-1005	GOLD ROOM & ELECTROWINNING & ICL : PLAN AT EL+913.100	C03	14/04/2021	ISSUED FOR CONSTRUCTION & REVISED AS MARKED C03	AUD	SJM	SNM	AG	
MD-216-3960-EG-ME-GAD-1004	GOLD ROOM & ELECTROWINNING & ICL : PLAN AT EL+918.950 & EL+925.450	C02	22/02/2021	ISSUED FOR CONSTRUCTION & REVISED AS MARKED C02	AUD	SJM	SNM	AG	
MD-216-3690-EG-ST-GAD-1002	PLAN AT +925.251, SECTION A-A, B-B AND C-C	C01	09/01/2021	ISSUED FOR CONSTRUCTION & REVISED AS MARKED C01	AUD	SJM	SNM	AG	
MD-216-3690-EG-ST-GAD-1001	PLAN AT +925.251, SECTION A-A & E-E	A02	03/12/2020	REVISED AS PER EMPLOYER'S COMMENTS ON 18/09/2020	AUD	SJM	SNM	AG	
MD-216-3690-EG-CV-GAD-1002	PLAN AT EL. +913.100 GOLD ROOM AND ELECTROWINNING			HOLD REMOVED, ISSUED FOR APPROVAL & AS MKD. A02					
MD-216-3690-EG-CV-GAD-1001	PLAN AT EL. +913.100 GOLD ROOM AND ELECTROWINNING	A01	30/05/2020	ISSUED FOR REFERENCE	AUD	SJM	SNM	AG	

RESERVED FOR VENDOR LOGO AND DRAWING NUMBER

LARSEN & TOUBRO
This drawing is the property of LARSEN & TOUBRO and must not be passed on to any person or body not authorized by us to receive it nor be copied or otherwise made use either in full or in part by such person or body without our prior permission in writing.

Outotec
The content of these documents are the sole property of Outotec Oy. Any rights not expressly granted herein are reserved. Reproduction, transfer or distribution of part or all of the contents in any form without prior written permission of Outotec is prohibited.

MA'ADEN معادن
Saudi Arabian Mining Company شركة التعدين العربية السعودية
This document and the information contained herein is Ma'aden proprietary know-how. This document or any part thereof should not be reproduced, stored in a retrieval system or transmitted by any means, electronic or otherwise, or divulged without prior written permission of Ma'aden.

LARSEN & TOUBRO DRAWING NUMBER	019045_450_C_D_24146_004	REVISION 5
OUTOTEC DRAWING NUMBER	900707__GAU01__EE14__CTB17__36904	DOCUMENT ID 0U100684636 / REVISION 5

DRAWN	AUD	20/05/2020
CHECKED	SJM	25/05/2020
ENGINEER	SNM	10/05/2020
APPROVED	AG	27/05/2020
EMPLOYER		
SCALE	1:100	A1

MANSOURAH - MASSARAH GOLD PROJECT
DETAIL DRAWING
GOLD ROOM
RCC DETAILS OF GRADE SLAB

DRAWING NUMBER: MD - 216 - 3690 - EG - CV - DED -1367 | REV: D01