


DRAWING NUMBER MD-216-3690-EG-CV-DED-1368 | REV D01

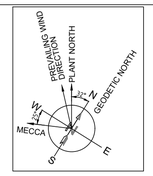


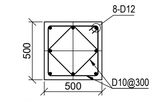


SECTION OF P3
SCALE 1:25
(RC DETAILS)

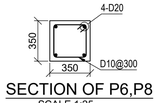


SECTION OF P6,P8
SCALE 1:25
(RC DETAILS)

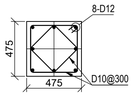


SECTION OF P7
SCALE 1:25
(RC DETAILS)

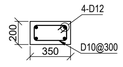


SECTION OF P9
SCALE 1:25
(RC DETAILS)

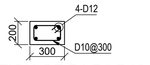


SECTION OF P1,P5,P10
SCALE 1:25
(RC DETAILS)

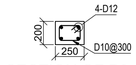


SECTION OF P2
SCALE 1:25
(RC DETAILS)

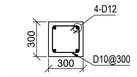


SECTION OF P4
SCALE 1:25
(RC DETAILS)

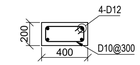


SECTION OF P11
SCALE 1:25
(RC DETAILS)

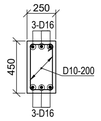


TYP. SECTION OF PB-1&PB-2
SCALE 1:25
(RC DETAILS)

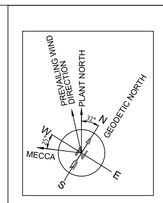


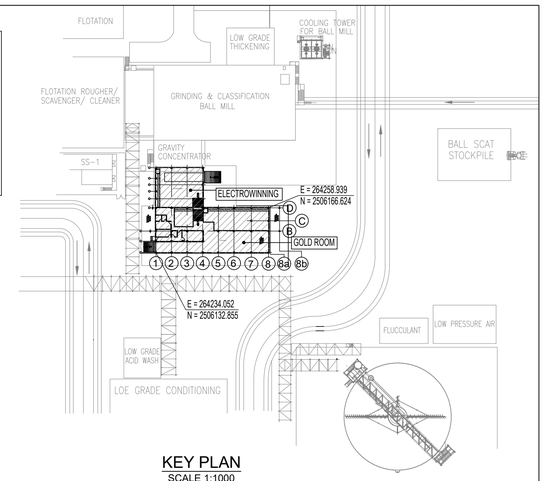

KEY PLAN
SCALE 1:1000

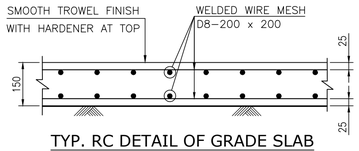


TYP. RC DETAIL OF GRADE SLAB
(FLOOR LOAD 15KN/SQM. TO 50KN/SQM.)
SCALE-1:10

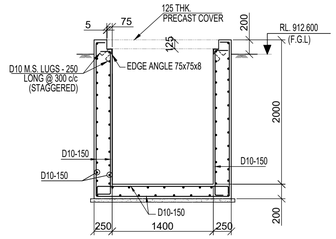


SECTION J2-J2
(RC DETAILS)
SCALE 1:40


LAYOUT OF FLOOR AT RL.+912.600 M LEVEL
SCALE 1:100

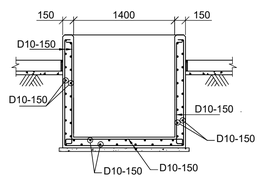


SECTION D1-D1
(RC DETAILS)
SCALE 1:40

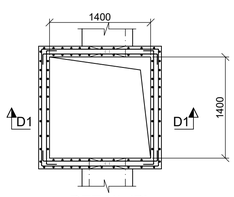

DETAIL 'B'
SCALE 1:40

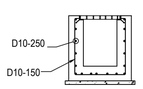

SECTION A-A (RC DET.)
SECTION P1-P1 (RC DET.)
SCALE 1:40

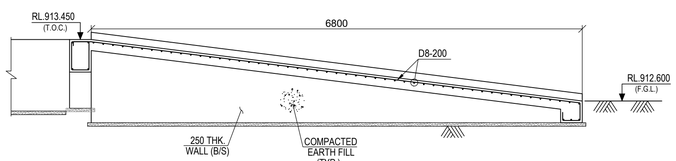

SECTION B-B
SCALE - 1:40

LEGEND :-

F.F.L - FINISHED FLOOR LEVEL
R.L. - REDUCED LEVEL
P.C.C - PLAIN CEMENT CONCRETE
T.O.C - TOP OF CONCRETE
TYP. - TYPICAL
RC. - REINFORCE CONCRETE

NOTES:-

1. GRADE OF CONCRETE SHALL BE 35 MPa FOR RCC, 15 MPa FOR BLINDING CONCRETE.
2. GRADE OF REINFORCEMENT SHALL BE DEFORMED BAR 420 MPa (GRADE 60) - ASTM A615/A615M.
3. CLEAR COVER TO MAIN REINFORCEMENT SHALL BE GRADE SLAB - 25MM.
4. THIS DRAWING SHOULD BE READ WITH DRAWING NO. MD-216-3690-EG-CV-GAD-1357,1358,1359,1360,1361 MD-216-3690-EG-CV-DED-1364,1365,1366,1367

DOCUMENT NUMBER	REFERENCE DOCUMENTS	REV	DATE	REVISION DESCRIPTION	DRN	CHK	ENG	APP	EMP
MD-216-3960-EG-ME-GAD-1018	GOLD ROOM & ELECTROWINNING & ICL : SECTION C-C								
MD-216-3960-EG-ME-GAD-1008	GOLD ROOM & ELECTROWINNING & ICL : SECTION B-B								
MD-216-3960-EG-ME-GAD-1007	GOLD ROOM & ELECTROWINNING & ICL : SECTION A-A								
MD-216-3960-EG-ME-GAD-1006	GOLD ROOM & ELECTROWINNING & ICL : PLAN AT EL+918.850 & EL+925.450								
MD-216-3960-EG-ME-GAD-1005	GOLD ROOM & ELECTROWINNING & ICL : PLAN AT EL+913.100								
MD-216-3960-EG-ME-GAD-1004	GOLD ROOM & ELECTROWINNING & ICL : PLAN AT EL+918.950 & EL+925.450	D01	20/03/2023	AS BUILT	AUD	SJM	SNM	PRI	
MD-216-3690-EG-ST-GAD-1002	PLAN AT +925.251, SECTION A-A, B-B AND C-C	C03	22/02/2021	ISSUED FOR CONSTRUCTION AND REVISED AS MARKED C03	AUD	SJM	SNM	PRI	
MD-216-3690-EG-ST-GAD-1001	PLAN AT +925.251, SECTION A-A - E-E	C02	12/12/2020	ISSUED FOR CONSTRUCTION AND REVISED AS MARKED C02	AUD	SJM	SNM	PRI	
MD-216-3690-EG-CV-GAD-1002	PLAN AT EL. +913.100 GOLD ROOM AND ELECTROWINNING	C01	18/09/2020	ISSUED FOR CONSTRUCTION	AUD	SJM	SNM	PRI	
MD-216-3690-EG-CV-GAD-1001	PLAN AT EL. +913.100 GOLD ROOM AND ELECTROWINNING	A01	30/05/2020	ISSUED FOR REFERENCE	AUD	SJM	SNM	PRI	

RESERVED FOR VENDOR LOGO AND DRAWING NUMBER

LARSEN & TOUBRO

This drawing is the property of LARSEN & TOUBRO and must not be passed on to any person or body not authorized by us to receive it nor be copied or otherwise made use either in full or in part by such person or body without our prior permission in writing.

Outotec

The content of these documents are the sole property of Outotec Oyj. Any rights not expressly granted herein are reserved. Reproduction, transfer or distribution of part or all of the contents in any form without prior written permission of Outotec is prohibited.

MA'ADEN معادن
Saudi Arabian Mining Company شركة التعدين العربية السعودية

This document and the information contained herein is Ma'aden proprietary know-how. This document or any part thereof should not be reproduced, stored in a retrieval system or transmitted by any means, electronic or otherwise, or divulged without prior written permission of Ma'aden.

LARSEN & TOUBRO DRAWING NUMBER: 019045_450_C_D_24146_005 | REVISION: 4
OUTOTEC DRAWING NUMBER: 900707__GAU01__EE14__CTB17__36905 | DOCUMENT ID: OU100684637 | REVISION: 4

DRAWN	AUD	20/05/2020
CHECKED	SJM	25/05/2020
ENGINEER	SNM	10/05/2020
APPROVED	PRI	27/05/2020
EMPLOYER		
SCALE	1:100	A1

MANSOURAH - MASSARAH GOLD PROJECT
DETAIL DRAWING
GOLD ROOM
RCC DETAILS OF GRADE SLAB

DRAWING NUMBER: MD-216-3690-EG-CV-DED-1368 | REV: D01