



DRAWING NUMBER: MD-216-3690-EG-CV-GAD-1305 | REV: D01

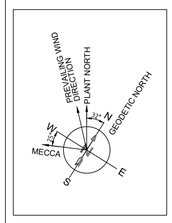

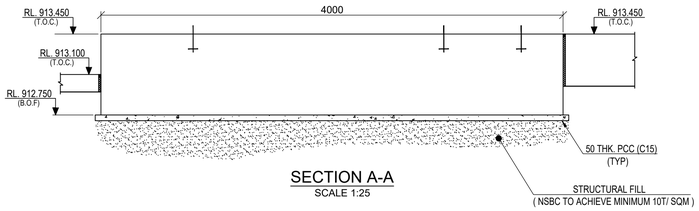


SECTION A-A
SCALE 1:25

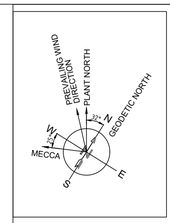


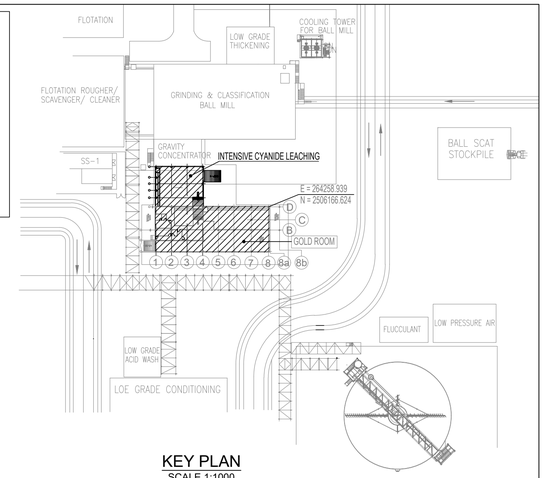


KEY PLAN
SCALE 1:1000

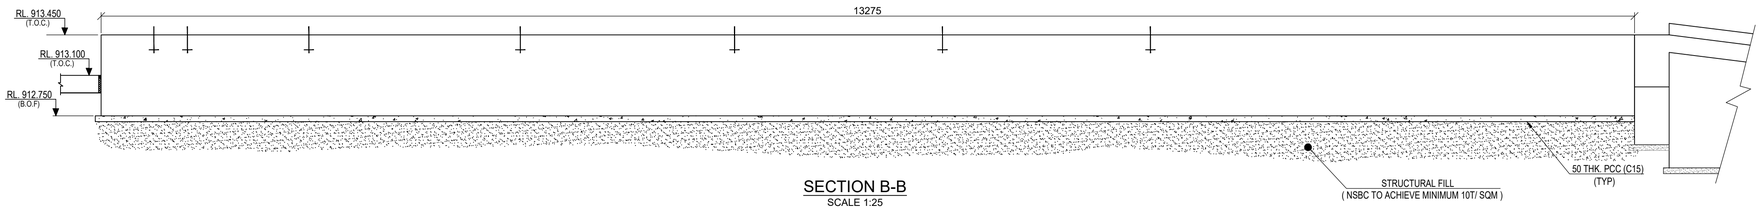


SECTION B-B
SCALE 1:25

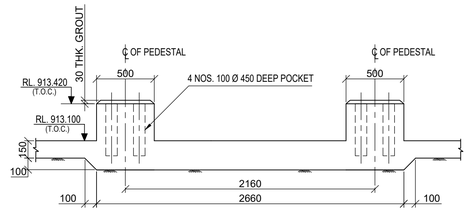

SECTION C-C
SCALE 1:25

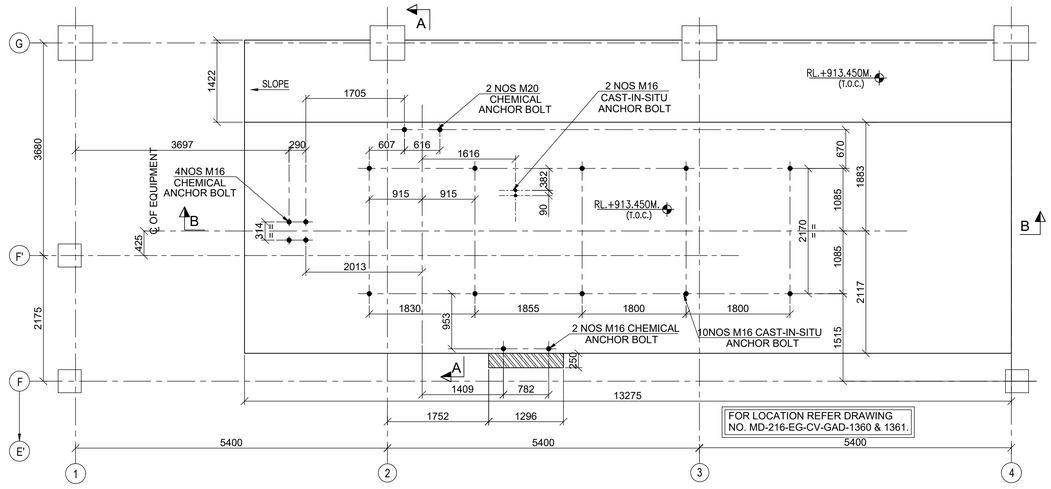

LAYOUT OF GROUND FLOOR EQUIPMENT FOUNDATION FOR GOLD ROOM
INTENSIVE CYANIDE LEACHING FOUNDATION
SCALE 1:50

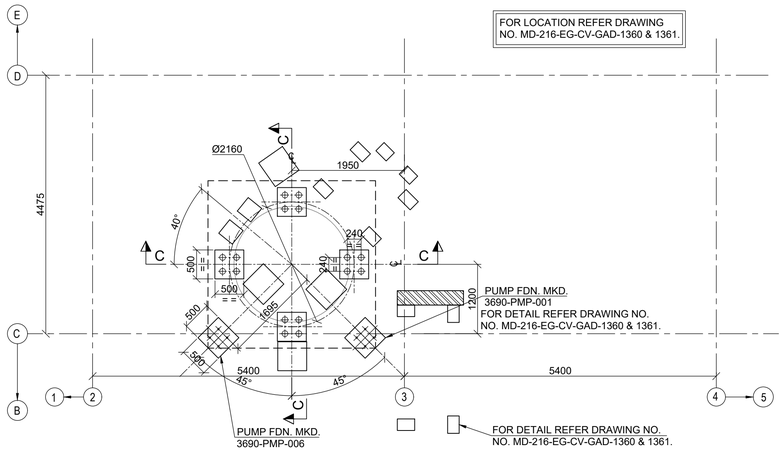

LAYOUT OF GROUND FLOOR EQUIPMENT FOUNDATION FOR GOLD ROOM
POX GOLD SLUDGE TANK FOUNDATION
SCALE 1:50

LEGEND :-

F.F.L - FINISHED FLOOR LEVEL
R.L. - REDUCED LEVEL
P.C.C - PLAIN CEMENT CONCRETE
T.O.C - TOP OF CONCRETE
℄ - CENTERLINE
NSBC - NET SAFE BEARING CAPACITY

NOTES:-

1. ALL DIMENSIONS ARE IN MILLIMETRES, LEVELS & COORDINATES ARE IN METRES UNLESS OTHERWISE STATED.
2. GRADE OF CONCRETE SHALL BE 35 MPa FOR WALL & 15 MPa FOR BLINDING CONCRETE.
3. NET SAFE BEARING CAPACITY AT THE FOUNDING LEVEL CONSIDERED 100KN /SQ. M
4. IF ANY PART OF FOUNDATION COMES ON BACKFILLED ZONE OF ADJACENT FOUNDATION OR ANY LOOSE POCKETS ARE ENCOUNTERED BELOW FOUNDATION LEVEL THE SAME SHALL BE REMOVED AND FILLED WITH PCC (15 MPa).
5. THE CONTENT OF THIS DRAWING SHALL CONFORM TO THE PROVISIONS OF CIVIL, STRUCTURAL AND ARCHITECTURAL DESIGN CRITERIA DOC. NO. MD-216-1000-EG-ST-CRT-1001.
6. TOP OF SCREED / GRADE SLAB TOLERANCE SHALL BE WITHIN +/- 10MM OF DESIGN LEVEL.
7. FOR BOLT EMBEDEMENT AND PROJECTION LENGTH THIS DETAIL TO BE FOLLOWED. FOR OTHER INFORMATION REFER BOLT DRAWING NO MD-216-1000-EG-CV-DED-1003
8. THIS DRAWING IS TO BE READ IN CONJUNCTION WITH DRAWING NO. MD-216-EG-CV-GAD-1360 & 1361.

DOCUMENT NUMBER	REFERENCE DOCUMENTS	REV	DATE	REVISION DESCRIPTION	DRN	CHK	ENG	APP	EMP
		D01	17/03/2023	AS-BUILT	AUD	SJM	SNM	PRI	
		C02	31/03/2021	ISSUED FOR CONSTRUCTION & REVISED AS MARKED	AUD	SJM	SNM	PRI	
		C01	24/11/2020	ISSUED FOR CONSTRUCTION & REVISED AS MARKED	AUD	SJM	SNM	PRI	
		A01	10/08/2020	ISSUED FOR REFERENCE	AUD	SJM	SNM	PRI	

RESERVED FOR VENDOR LOGO AND DRAWING NUMBER

LARSEN & TOUBRO

This drawing is the property of LARSEN & TOUBRO and must not be passed on to any person or body not authorized by us to receive it nor be copied or otherwise made use either in full or in part by such person or body without our prior permission in writing.

Outotec

The content of these documents are the sole property of Outotec Oyj. Any rights not expressly granted herein are reserved. Reproduction, transfer or distribution of part or all of the contents in any form without prior written permission of Outotec is prohibited.

MA'ADEN معادن Saudi Arabian Mining Company شركة التعدين العربية السعودية

This document and the information contained herein is Ma'aden proprietary know-how. This document or any part thereof should not be reproduced, stored in a retrieval system or transmitted by any means, electronic or otherwise, or divulged without prior written permission of Ma'aden.

DRAWN	AUD	05/08/2020	MANSOURAH - MASSARAH GOLD PROJECT
CHECKED	SJM	06/08/2020	GENERAL ARRANGEMENT DRAWING
ENGINEER	SNM	05/08/2020	GOLD ROOM
APPROVED	PRI	10/08/2020	LAYOUT OF GROUND FLOOR EQUIPMENT FOUNDATION
EMPLOYER			
SCALE 1:100		A1	DRAWING NUMBER: MD-216-3690-EG-CV-GAD-1305 REV: D01

LARSEN & TOUBRO DRAWING NUMBER: 019045_450_C_G_24132_001 REVISION: 3
OUTOTEC DRAWING NUMBER: 900707__GAU01__EE14__MTL01__36923 DOCUMENT ID: OU100687046 REVISION: 3