


DRAWING NUMBER MD-216-3690-EG-CV-GAD-1306 REV D01

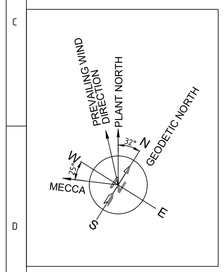


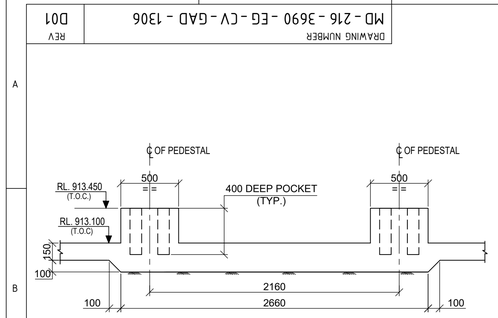


SECTION A-A
SCALE 1:25

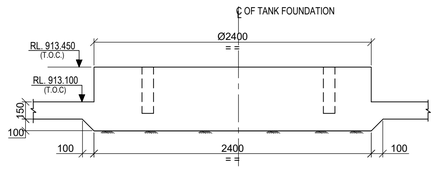


SECTION B-B
SCALE 1:25

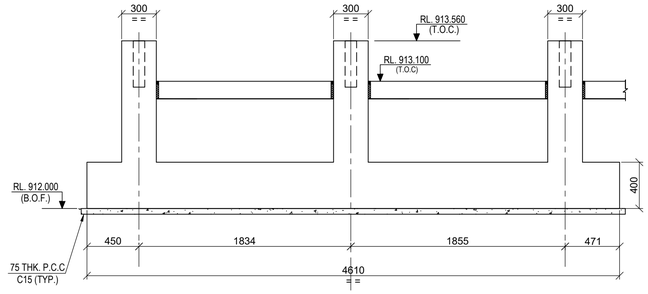


SECTION C-C
SCALE 1:25

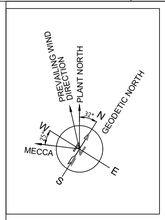


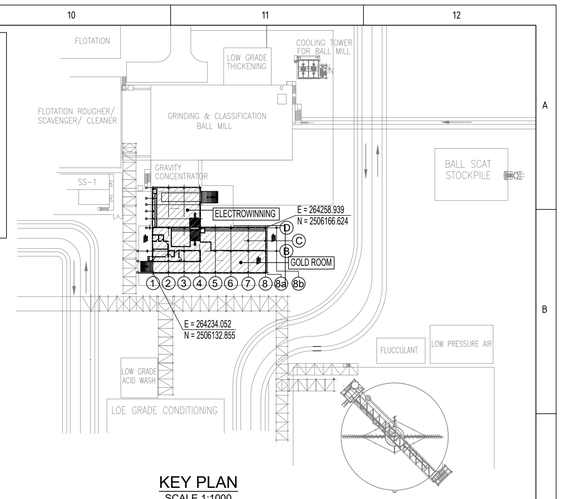


KEY PLAN
SCALE 1:1000

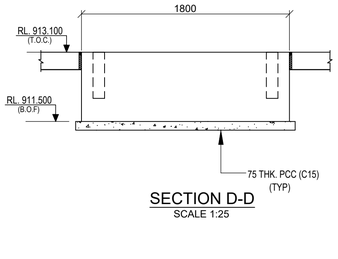


SECTION D-D
SCALE 1:25

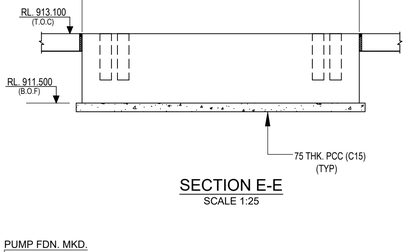


SECTION E-E
SCALE 1:25

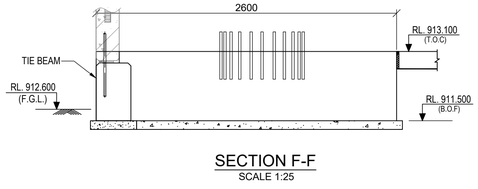


SECTION F-F
SCALE 1:25

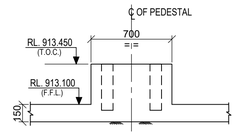


SECTION G-G
SCALE 1:25

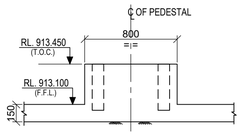

SECTION H-H
SCALE 1:25

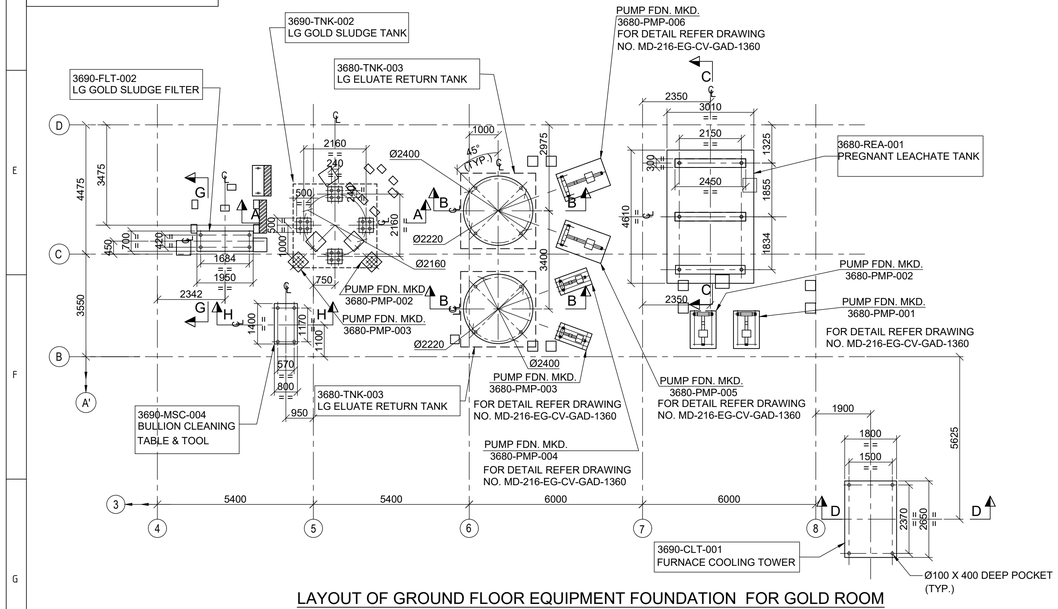

LAYOUT OF GROUND FLOOR EQUIPMENT FOUNDATION FOR GOLD ROOM
GRAVITY ELECTROWINNING LEACHATE TANK, LG ELUATE RETURN TANK, POX ELUATE RETURN TANK, LG GOLD SLUDGE TANK, FURNACE COOLING TOWER & LG GOLD SLUDGE FILTER
SCALE 1:100

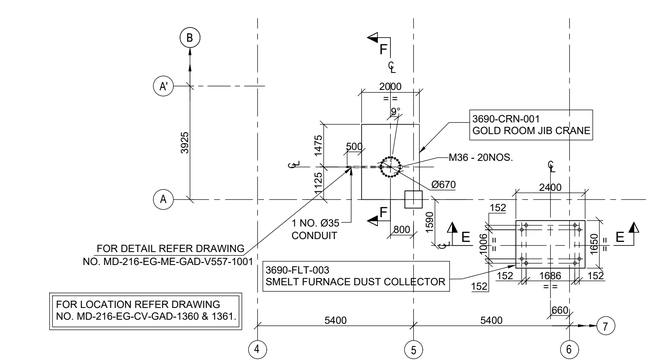

LAYOUT OF GROUND FLOOR EQUIPMENT FOUNDATION FOR GOLD ROOM
SMELT FURNACE DUST COLLECTOR & GOLD ROOM JIB CRANE
SCALE 1:100

LEGEND.:-

T.O.C - TOP OF CONCRETE
℄ - CENTERLINE
FDN. - FOUNDATION
TYP. - TYPICAL
RL - REDUCED LEVEL

NOTES:-

1. ALL DIMENSIONS ARE IN MILLIMETRES, LEVELS & COORDINATES ARE IN METRES UNLESS OTHERWISE STATED.
2. GRADE OF CONCRETE SHALL BE 35 MPa FOR WALL & 15 MPa FOR BLINDING CONCRETE.
3. NET SAFE BEARING CAPACITY AT THE FOUNDING LEVEL CONSIDERED 375KN /SQ. M
4. IF ANY PART OF FOUNDATION COMES ON BACKFILLED ZONE OF ADJACENT FOUNDATION OR ANY LOOSE POCKETS ARE ENCOUNTERED BELOW FOUNDATION LEVEL THE SAME SHALL BE REMOVED AND FILLED WITH PCC (15 MPa).
5. THE CONTENT OF THIS DRAWING SHALL CONFORM TO THE PROVISIONS OF CIVIL, STRUCTURAL AND ARCHITECTURAL DESIGN CRITERIA DOC. NO. MD-216-1000-EG-ST-CRT-1001.
6. TOP OF SCREED / GRADE SLAB TOLERANCE SHALL BE WITHIN +/- 10MM OF DESIGN LEVEL.
7. FOR BOLT EMBEDMENT AND PROJECTION LENGTH THIS DETAIL TO BE FOLLOWED. FOR OTHER INFORMATION REFER BOLT DRAWING NO MD-216-1000-EG-CV-DED-1003
8. THIS DRAWING IS TO BE READ IN CONJUNCTION WITH DRAWING NO. MD-216-EG-CV-GAD-1360 & 1361.

DOCUMENT NUMBER	REFERENCE DOCUMENTS	REV	DATE	REVISION DESCRIPTION	DRN	CHK	ENG	APP	EMP
		D01	17/03/2023	AS-BUILT	AUD	SJM	SNM	PRI	
		C02	31/03/2021	ISSUED FOR CONSTRUCTION & REVISED AS MARKED C02	AUD	SJM	SNM	PRI	
		C01	10/11/2020	ISSUED FOR CONSTRUCTION & REVISED AS MARKED C01	SYA	SJM	SNM	AG	
		A01	10/08/2020	ISSUED FOR REFERENCE	SYA	SJM	SNM	AG	

RESERVED FOR VENDOR LOGO AND DRAWING NUMBER

LARSEN & TOUBRO DRAWING NUMBER: 019045_450_C_G_24132_002 — REVISION: 3
OUTOTEC DRAWING NUMBER: 900707__GAU01__EE14__MTL01__36924 — DOCUMENT ID: OU100687047 — REVISION: 3

LARSEN & TOUBRO
This drawing is the property of LARSEN & TOUBRO and must not be passed on to any person or body not authorized by us to receive it nor be copied or otherwise made use either in full or in part by such person or body without our prior permission in writing.

Outotec
The content of these documents are the sole property of Outotec Oyj. Any rights not expressly granted herein are reserved. Reproduction, transfer or distribution of part or all of the contents in any form without prior written permission of Outotec is prohibited.

MA'ADEN معادن
Saudi Arabian Mining Company شركة التعدين العربية السعودية
This document and the information contained herein is Ma'aden proprietary know-how. This document or any part thereof should not be reproduced, stored in a retrieval system or transmitted by any means, electronic or otherwise, or divulged without prior written permission of Ma'aden.

DRAWN	SYA	05/08/2020
CHECKED	SJM	06/08/2020
ENGINEER	SNM	05/08/2020
APPROVED	AG	10/08/2020
EMPLOYER		
SCALE 1:100, 25		A1

MANSOURAH - MASSARAH GOLD PROJECT
GENERAL ARRANGEMENT DRAWING
GOLD ROOM
LAYOUT OF GROUND FLOOR EQUIPMENT FOUNDATION

DRAWING NUMBER: MD-216-3690-EG-CV-GAD-1306 — REV: D01