


DRAWING NUMBER MD-216-3690-EG-CV-GAD-1357 REV D01

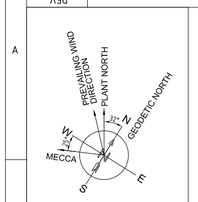


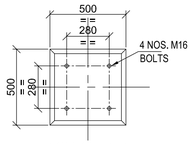


VIEW : 1-1
(DETAIL OF P1)
SCALE 1:20

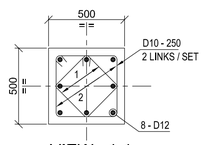

VIEW : 1-1
(R.C. DET. OF P1)
SCALE 1:20

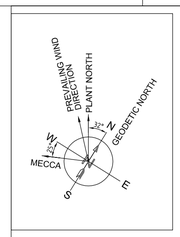


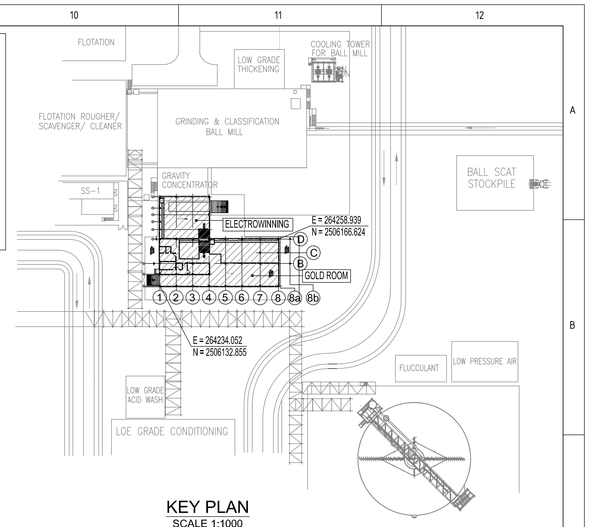

KEY PLAN
SCALE 1:1000

SECTION : A-A

DET. OF FOUNDATION
MKD. F1A
SCALE 1:50

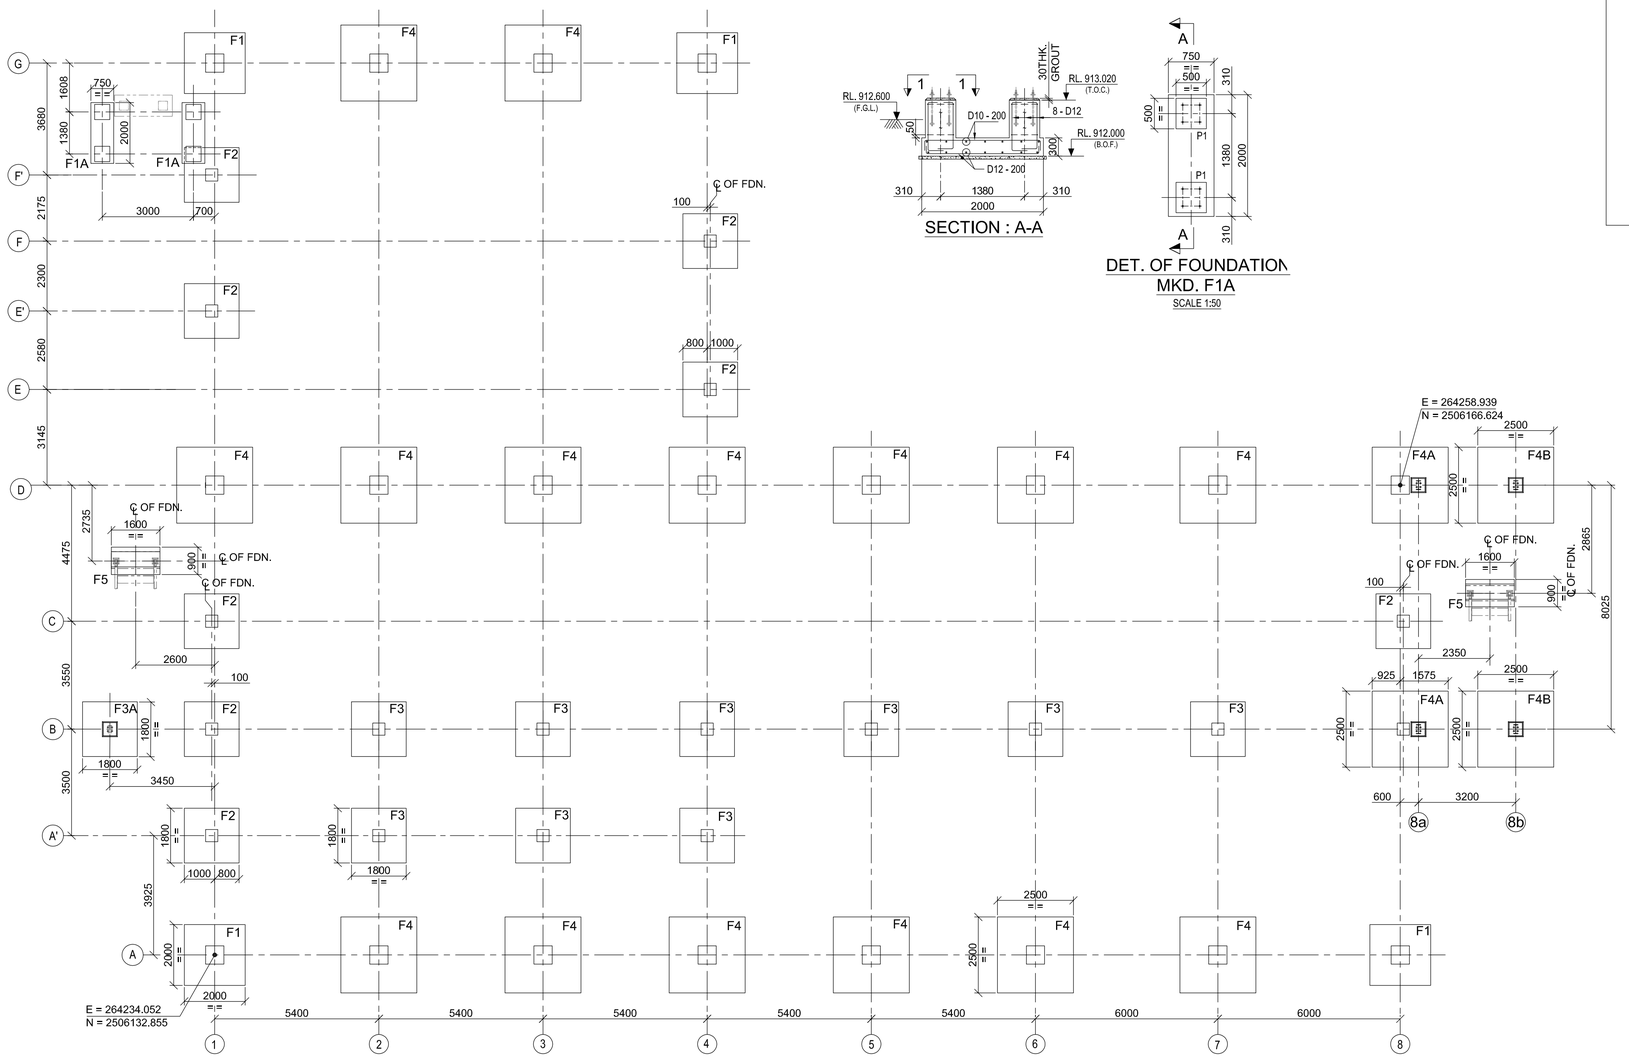

LAYOUT OF FOUNDATION
SCALE 1:100

LEGEND :-

FND. - FOUDATIUON
C.L. - CENTRE LINE

NOTES:-

1. ALL DIMENSIONS ARE IN MILLIMETRES AND LEVELS AND CO-ORDINATES ARE IN METRES UNLESS OTHERWISE STATED.
2. GRADE OF CONCRETE SHALL BE 35 MPa FOR FOUNDATION, 30 MPa FOR GRADE SLAB & 15 MPa FOR BLINDING CONCRETE.
3. GRADE OF REINFORCEMENT SHALL BE DEFORMED BAR 420 MPa (GRADE 60) - ASTM A615/A615M.
4. GRADE OF WELDED WIRE FABRIC - ASTM A185(PLAIN) / A497 (DEFORMED).
5. NET SAFE BEARING CAPACITY OF SOIL AT BOTTOM OF FOUNDATION CONSIDERED 400KN/ SQ. M
6. IF ANY PART OF FOUNDATION COMES ON BACKFILL ZONE OF ADJACENT FOUNDATION OR ANY LOOSE SOIL ARE ENCOUNTERED BELOW FOUNDATION LEVEL THE SAME SHALL BE REMOVED AND FILLED WITH PCC.
7. THE CONTENTS OF THIS DRAWING SHALL CONFORM TO THE PROVISIONS OF CIVIL, STRUCTURAL AND ARCHITECTURAL DESIGN CRITERIA DOC # MD-216-1000-EG-ST-CRT-1001
8. THIS DRAWING SHOULD BE READ WITH DRAWING NO. MD-216-3690-EG-CV-GAD-1358,1359,1360,1361 MD-216-3690-EG-CV-DED-1364,1365,1366,1367,1368

DOCUMENT NUMBER	REFERENCE DOCUMENTS	REV	DATE	REVISION DESCRIPTION	DRN	CHK	ENG	APP	EMP
MD-216-3690-EG-ST-GAD-1002	PLAN AT +925.251, SECTION A-A, B-B AND C-C	D01	22/03/2023	AS-BUILT	ABS	SJM	AVG	AG	
MD-216-3690-EG-ST-GAD-1001	PLAN AT +925.251, SECTION A-A - E-E	C02	03/12/2021	ISSUED FOR CONSTRUCTION & REVISED AS MKD. (02)	ABS	SJM	AVG	AG	
MD-216-3690-EG-CV-GAD-1002	PLAN AT EL. +913.100 GOLD ROOM AND ELECTROWINNING	C01	26/06/2020	ISSUED FOR CONSTRUCTION	AUD	SJM	SNM	PRI	
MD-216-3690-EG-CV-GAD-1001	PLAN AT EL. +913.100 GOLD ROOM AND ELECTROWINNING	A01	30/05/2020	ISSUED FOR REFERENCE	AUD	SJM	SNM	PRI	

RESERVED FOR VENDOR LOGO AND DRAWING NUMBER

LARSEN & TOUBRO

This drawing is the property of LARSEN & TOUBRO and must not be passed on to any person or body not authorized by us to receive it nor be copied or otherwise made use either in full or in part by such person or body without our prior permission in writing.

Outotec

The content of these documents are the sole property of Outotec Oyj. Any rights not expressly granted herein are reserved. Reproduction, transfer or distribution of part or all of the contents in any form without prior written permission of Outotec is prohibited.

MA'ADEN معادن
Saudi Arabian Mining Company شركة معادن العربية السعودية

This document and the information contained herein is Ma'aden proprietary know-how. This document or any part thereof should not be reproduced, stored in a retrieval system or transmitted by any means, electronic or otherwise, or divulged without prior written permission of Ma'aden.

LARSEN & TOUBRO DRAWING NUMBER: 019045_450_C_G_24145_001 — REVISION: 3
OUTOTEC DRAWING NUMBER: 900707 __GAU01 __EE14 __MTL01 __36914 — DOCUMENT ID: OU100684642 — REVISION: 3

DRAWN	AUD	20/05/2020
CHECKED	SJM	25/05/2020
ENGINEER	SNM	10/05/2020
APPROVED	PRI	27/05/2020
EMPLOYER		
SCALE	1:100	A1

MANSOURAH - MASSARAH GOLD PROJECT
GENERAL ARRANGEMENT DRAWING
GOLD ROOM
LAYOUT OF FOUNDATION

DRAWING NUMBER: MD-216-3690-EG-CV-GAD-1357 — REV: D01