
DRAWING NUMBER MD-216-3690-EG-CV-GAD-1361 REV D01

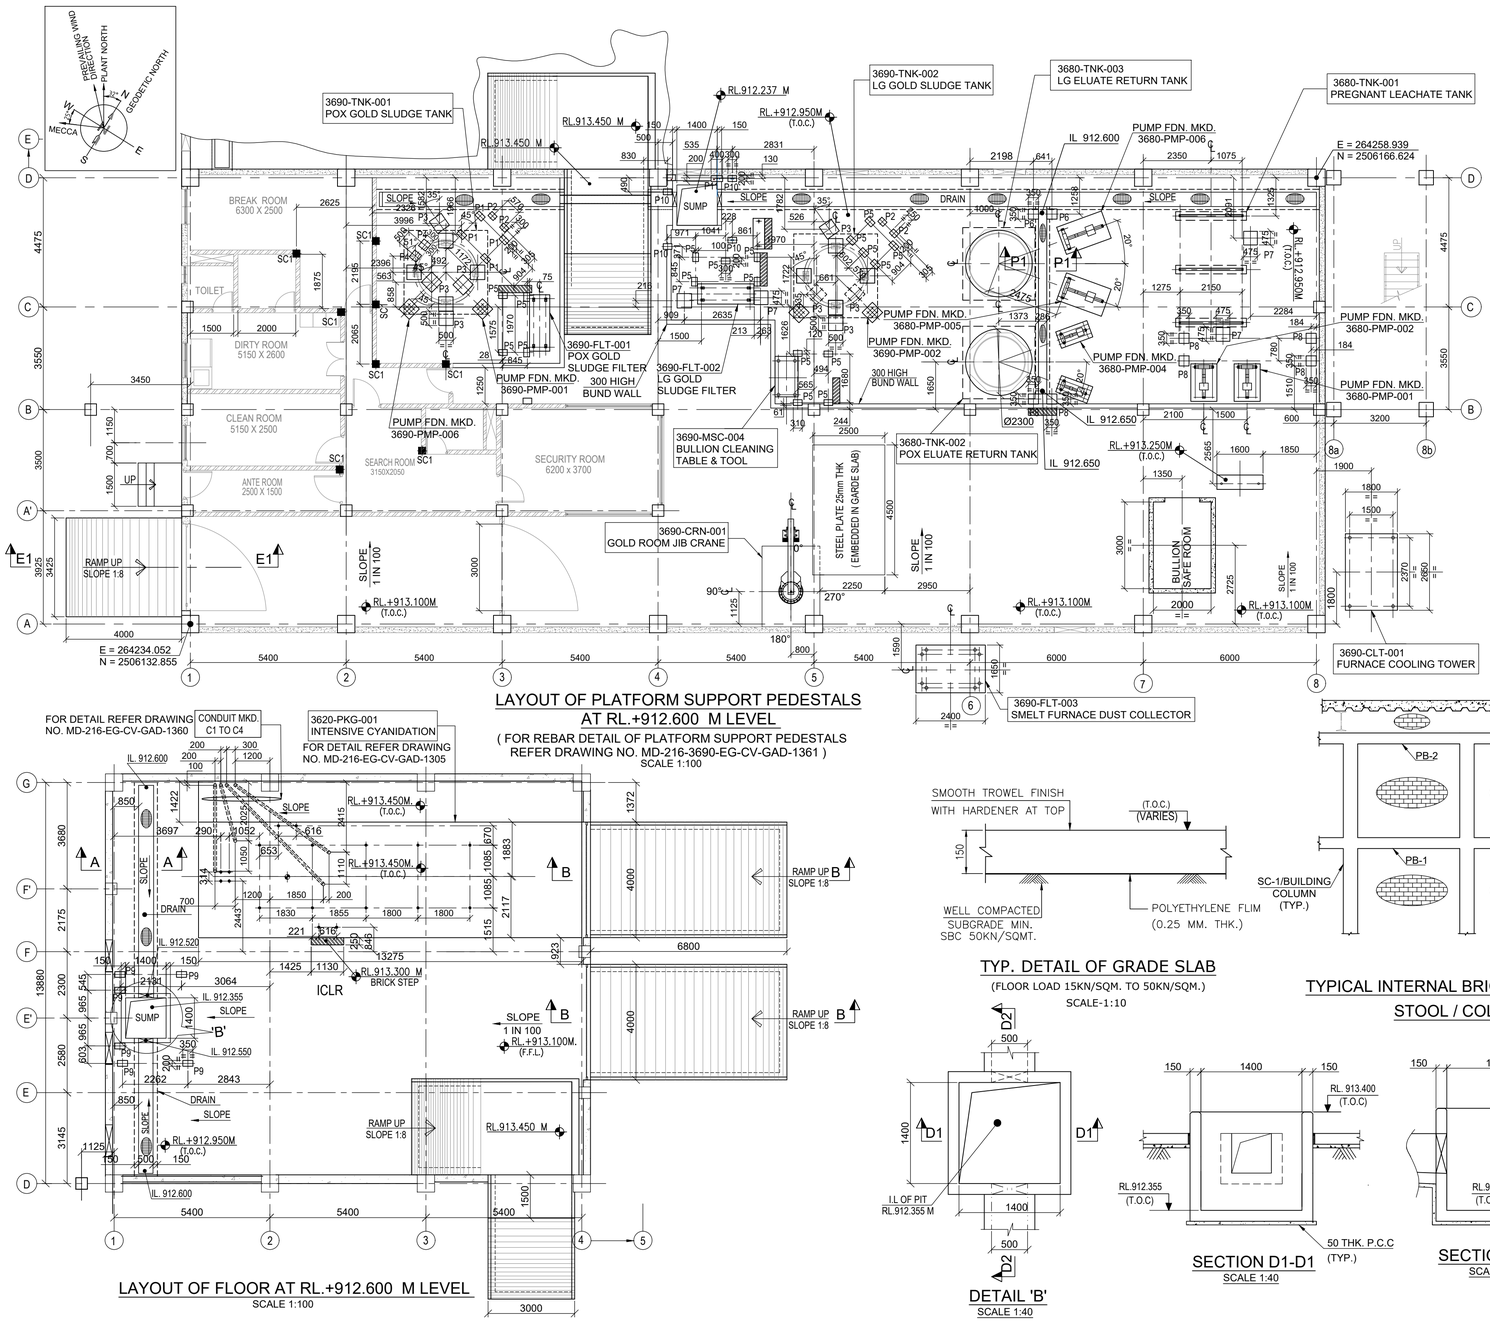


LAYOUT OF PLATFORM SUPPORT PEDESTALS AT RL.+912.600 M LEVEL

(FOR REBAR DETAIL OF PLATFORM SUPPORT PEDESTALS REFER DRAWING NO. MD-216-3690-EG-CV-GAD-1361)

SCALE 1:100


LAYOUT OF FLOOR AT RL.+912.600 M LEVEL

SCALE 1:100

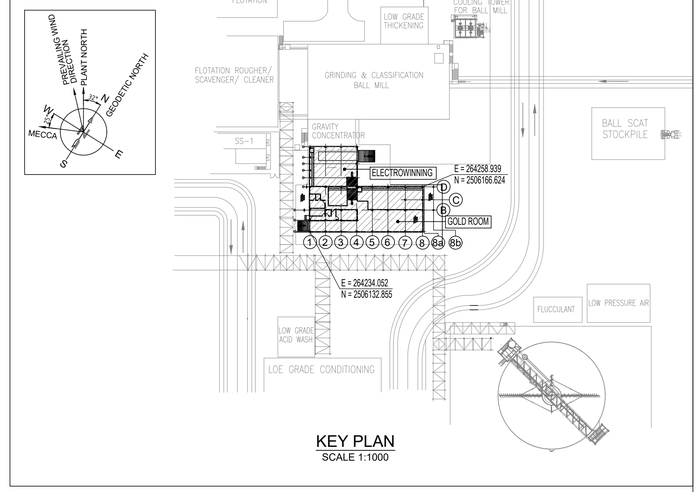


KEY PLAN

SCALE 1:1000

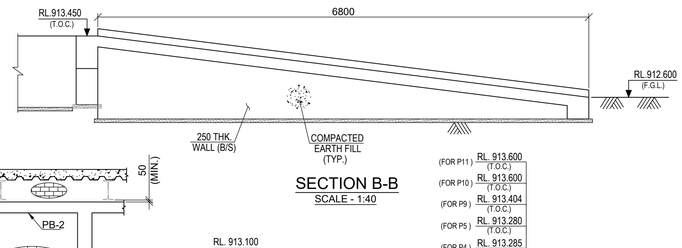

SECTION B-B

SCALE - 1:40

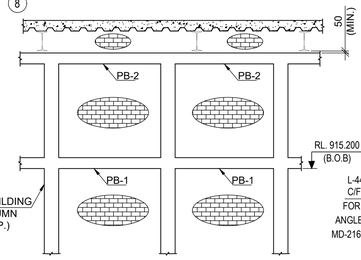


TYP. DETAIL OF GRADE SLAB

(FLOOR LOAD 15KN/SQM. TO 50KN/SQM.)

SCALE-1:10

SECTION A-A

SCALE 1:40

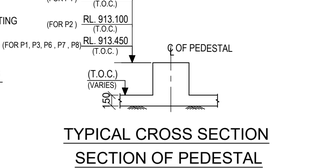

TYPICAL CROSS SECTION SECTION OF PEDESTAL

SCALE 1:40


DETAIL 'B'

SCALE 1:40

TYPICAL INTERNAL BRICK WALL PANEL WITH STOOL / COLUMN


SECTION D1-D1

SCALE 1:40

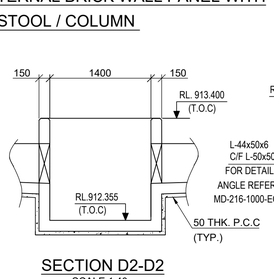

SECTION D2-D2

SCALE 1:40

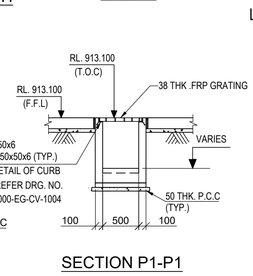

SECTION P1-P1

LEGEND :-

F.F.L - FINISHED FLOOR LEVEL
R.L. - REDUCED LEVEL
P.C.C - PLAIN CEMENT CONCRETE
TYP. - TYPICAL
T.O.C - TOP OF CONCRETE
B.O.B - BOTTOM OF BEAM
C/F - CUT FROM
FRP - FIBER REINFORCED GRATING
DWG. - DRAWING

NOTES:-

1. ALL DIMENSIONS ARE IN MILLIMETRES AND LEVELS AND CO-ORDINATES ARE IN METRES UNLESS OTHERWISE STATED.
2. NET SAFE BEARING CAPACITY OF SOIL AT BOTTOM OF FOUNDATION CONSIDERED 400KN/ SQ. M
3. IF ANY PART OF FOUNDATION COMES ON BACKFILL ZONE OF ADJACENT FOUNDATION OR ANY LOOSE SOIL ARE ENCOUNTERED BELOW FOUNDATION LEVEL THE SAME SHALL BE REMOVED AND FILLED WITH PCC.
4. THE CONTENTS OF THIS DRAWING SHALL CONFORM TO THE PROVISIONS OF CIVIL, STRUCTURAL AND ARCHITECTURAL DESIGN CRITERIA DOC # MD-216-1000-EG-ST-CRT-1001
5. THIS DRAWING SHOULD BE READ WITH DRAWING NO. MD-216-3690-EG-CV-GAD-1357,1358,1359,1360 MD-216-3690-EG-CV-DED-1364,1365,1366,1367,1368

DOCUMENT NUMBER	REFERENCE DOCUMENTS	REV	DATE	REVISION DESCRIPTION	DRN	CHK	ENG	APP	EMP
		D01	20/03/2023	AS BUILT	AUD	SJM	SNM	PRI	
		C04	14/04/2021	ISSUED FOR CONSTRUCTION AND REVISED AS MARKED C04	AUD	SJM	SNM	PRI	
MD-216-3690-EG-ST-GAD-1002	PLAN AT +925.251, SECTION A-A, B-B AND C-C	C03	22/02/2021	ISSUED FOR CONSTRUCTION AND REVISED AS MARKED C03	AUD	SJM	SNM	PRI	
MD-216-3690-EG-ST-GAD-1001	PLAN AT +925.251, SECTION A-A - E-E	C02	12/12/2020	ISSUED FOR CONSTRUCTION AND REVISED AS MARKED C02	AUD	SJM	SNM	PRI	
MD-216-3690-EG-CV-GAD-1002	PLAN AT EL. +913.100 GOLD ROOM AND ELECTROWINNING	C01	18/09/2020	ISSUED FOR CONSTRUCTION	AUD	SJM	SNM	PRI	
MD-216-3690-EG-CV-GAD-1001	PLAN AT EL. +913.100 GOLD ROOM AND ELECTROWINNING	A01	30/05/2020	ISSUED FOR REFERENCE	AUD	SJM	SNM	PRI	

RESERVED FOR VENDOR LOGO AND DRAWING NUMBER

LARSEN & TOUBRO DRAWING NUMBER: 019045_450_C_G_24145_005 — REVISION: 5

OUTOTEC DRAWING NUMBER: 900707 __GAU01 __EE14 __MTL01 __36918 — DOCUMENT ID: OU100684646 — REVISION: 5

LARSEN & TOUBRO

This drawing is the property of LARSEN & TOUBRO and must not be passed on to any person or body not authorized by us to receive it nor be copied or otherwise made use either in full or in part by such person or body without our prior permission in writing.

Outotec

The content of these documents are the sole property of Outotec Oyj. Any rights not expressly granted herein are reserved. Reproduction, transfer or distribution of part or all of the contents in any form without prior written permission of Outotec is prohibited.

MA'ADEN معادن
Saudi Arabian Mining Company شركة التعدين العربية السعودية

This document and the information contained herein is Ma'aden proprietary know-how. This document or any part thereof should not be reproduced, stored in a retrieval system or transmitted by any means, electronic or otherwise, or divulged without prior written permission of Ma'aden.

DRAWN	AUD	20/05/2020
CHECKED	SJM	25/05/2020
ENGINEER	SNM	10/05/2020
APPROVED	PRI	27/05/2020
EMPLOYER		
SCALE	1:100	A1

MANSOURAH - MASSARAH GOLD PROJECT
GENERAL ARRANGEMENT DRAWING
GOLD ROOM
LAYOUT & DETAILS OF GRADE SLAB

DRAWING NUMBER: MD - 216 - 3690 - EG - CV - GAD-1361 — REV: D01