


DRAWING NUMBER MD-216-3850-EG-CV-GAD-1432 REV D01

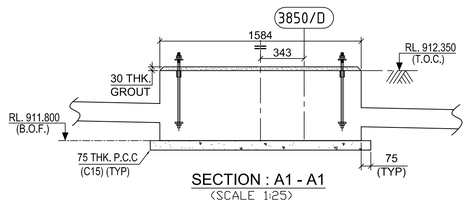


SECTION : A1 - A1
(SCALE 1:25)

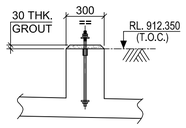


SECTION : A2 - A2
(SCALE 1:25)

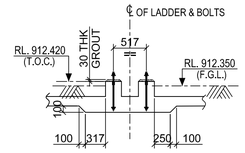


DETAIL OF PEDESTAL MKD. P7A
(SCALE 1:50)

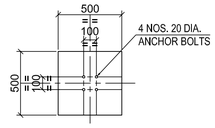


DETAIL OF PEDESTAL MKD. P7B
(SCALE-1:25)

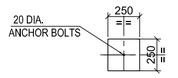


DETAIL OF PEDESTAL MKD. P7A
(SCALE-1:25)

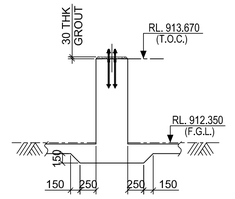


DETAIL OF PEDESTAL MKD. P7B
(SCALE 1:50)

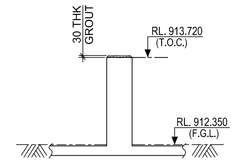


DETAIL OF PEDESTAL MKD. P7C
(SCALE 1:50)

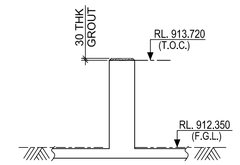


DETAIL OF PEDESTAL MKD. P7D
(SCALE 1:50)

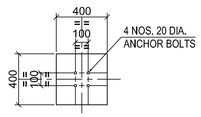


DETAIL OF PEDESTAL MKD. P11
(SCALE-1:25)

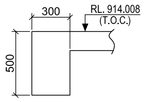


TYP DETAIL OF BEAM MKD. B1
(SCALE-1:25)

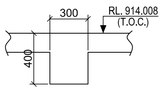


TYP DETAIL OF BEAM MKD. B2
(SCALE-1:25)

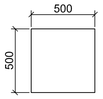


DETAIL OF COLUMN MKD. C1
(SCALE-1:25)

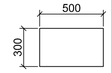


DETAIL OF COLUMN MKD. C2
(SCALE-1:25)

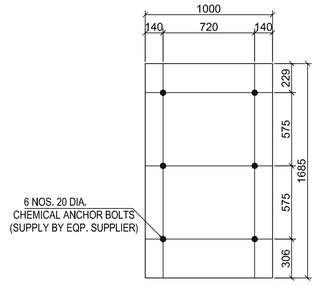


TOP VIEW OF PEDESTAL MKD. P6
(SCALE-1:25)

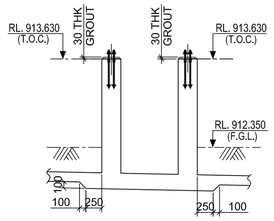


SECTION: E5 - E5
(SCALE 1:50)

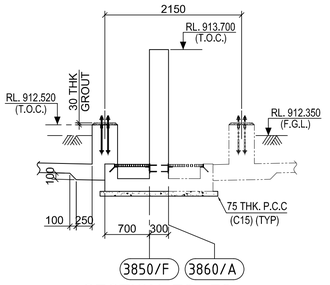


SECTION: E6 - E6
(SCALE 1:50)

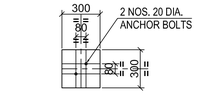


DETAIL OF PEDESTAL MKD. P7
(SCALE-1:25)

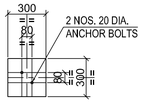


DETAIL OF PEDESTAL MKD. P8
(SCALE-1:25)

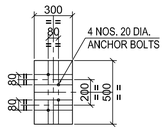


DETAIL OF PEDESTAL MKD. P9
(SCALE-1:25)

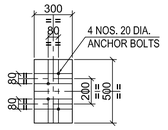


DETAIL OF PEDESTAL MKD. P10
(SCALE-1:25)

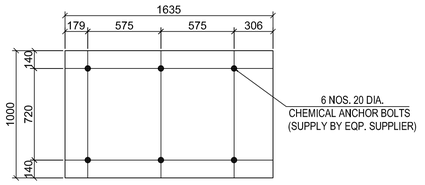


TOP VIEW OF PEDESTAL MKD. P4 & P5
(SCALE-1:25)

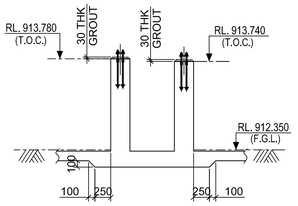


SECTION: E1 - E1
(SCALE 1:50)

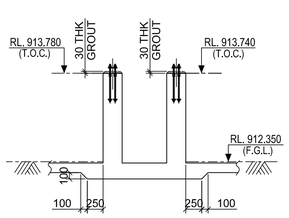


SECTION: E2 - E2
(SCALE 1:50)

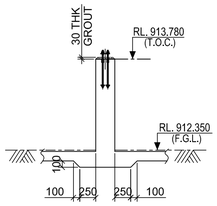


SECTION: E3 - E3
(SCALE 1:50)

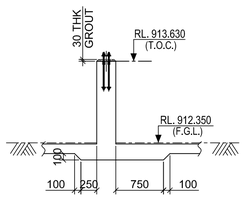


SECTION: E4 - E4
(SCALE 1:50)

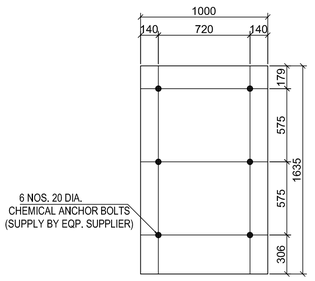


TOP VIEW OF PEDESTAL MKD. P3
(SCALE-1:25)

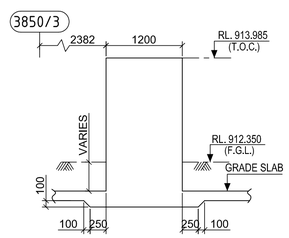


DETAIL OF PEDESTAL MKD. P1 & P2
(SCALE 1:50)

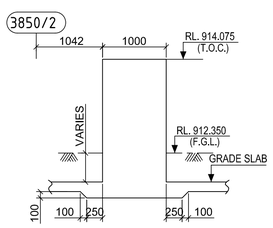


DETAIL OF PEDESTAL MKD. P3
(SCALE 150)

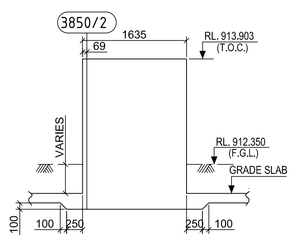

DETAIL OF PEDESTAL MKD. P4 & P5
(SCALE 1:50)

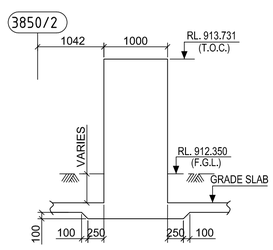

DETAIL OF PEDESTAL MKD. P6
(SCALE 150)

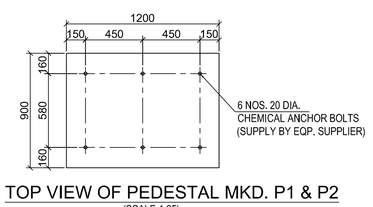

TOP VIEW OF PEDESTAL MKD. P1 & P2
(SCALE-1:25)

LEGEND :-

R.L. - REDUCED LEVEL
T.O.C. - TOP OF CONCRETE.
F.G.L. - FINISHED GROUND LEVEL.
B.O.F. - BOTTOM OF FOUNDATION.
TYP. - TYPICAL.
P.C.C - PLAIN CEMENT CONCRETE
MKD. - MARKED.
THK. - THICK

NOTES :-

1. ALL DIMENSIONS ARE IN MILLIMETRES AND LEVELS AND CO-ORDINATES ARE IN METRES. UNLESS OTHERWISE STATED.
2. GRADE OF CONCRETE SHALL BE C35.
3. GRADE OF REINFORCEMENT SHALL BE DEFORMED BAR ASTM A615 - GRADE 60 (fy = 420 MPa).
4. IF ANY PART OF FOUNDATION COMES ON BACKFILL ZONE OF ADJACENT FOUNDATION OR ANY LOOSE POCKETS ARE ENCOUNTERED BELOW FOUNDATION LEVEL THE SAME SHALL BE REMOVED AND FILLED WITH PCC.
5. THIS DRAWING IS READ IN CONJUNCTION WITH DRG. NO : MD-216-3850-EG-CV-GAD-1430.
6. FOR REINFORCEMENT DETAIL REFER DRG. NO : MD-216-3850-EG-CV-DED-1432.
7. FOR STANDER DETAILS OF PAVING REFER DRG. NO : MD-216-1000-EG-CV-DED-1002.
8. FOR GENERAL NOTE FOR CIVIL WORK REFER DRG. NO : MD-216-1000-EG-CV-DED-1001.
9. FOR FOUNDATION BOLT DETAILS REFER DRG. NO : MD-216-1000-EG-CV-DED-1003.

DOCUMENT NUMBER	REFERENCE DOCUMENTS	REV	DATE	REVISION DESCRIPTION	DRN	CHK	ENG	APP	EMP
MD-216-3850-EG-ST-GAD-2355	PLAN, ELEVATIONS & DETAILS								
MD-216-3850-EG-ST-GAD-2005	MONORAIL BEAM SUPRTS & WLKWAY DET								
MD-216-3850-EG-ST-GAD-2004	MONORAIL BEAM SUPRTS & WLKWAY DET								
MD-216-3850-EG-ST-GAD-2003	MONORAIL BEAM SUPRTS & WLKWAY DET								
MD-216-3850-EG-ME-GAD-1014	PLAN AT EL. +912.350								
MD-216-3850-EG-ME-GAD-1009	SECTION C-C								
MD-216-3850-EG-ME-GAD-1008	SECTION B-B	D01	22/02/2023	AS-BUILT	SBH	BDA	SUE	AG	
MD-216-3850-EG-ME-GAD-1007	SECTION A-A	C03	22/01/2021	ISSUED FOR CONSTRUCTION & REVISED AS MKD. C03	SBH	BDA	SUE	AG	
MD-216-3850-EG-ME-GAD-1006	PLAN VIEW	C02	28/12/2020	ISSUED FOR CONSTRUCTION & REVISED AS MKD. C02	SBH	BDA	SUE	AG	
MD-216-3850-EG-ME-GAD-1004	PLAN AT EL. +912.350	C01	03/11/2020	ISSUED FOR CONSTRUCTION & REVISED AS MKD. C01	SBH	BDA	SUE	AG	
MD-216-3850-EG-CV-GAD-1001	PLAN AT EL. +912.350 AND SECTIONS	A01	14/09/2020	ISSUED FOR REFERENCE	SBH	BDA	SUE	AG	

RESERVED FOR VENDOR LOGO AND DRAWING NUMBER

LARSEN & TOUBRO
This drawing is the property of LARSEN & TOUBRO and must not be passed on to any person or body not authorized by us to receive it nor be copied or otherwise made use either in full or in part by such person or body without our prior permission in writing.

Outotec
The content of these documents are the sole property of Outotec Oyj. Any rights not expressly granted herein are reserved. Reproduction, transfer or distribution of part or all of the contents in any form without prior written permission of Outotec is prohibited.

MA'ADEN معادن
Saudi Arabian Mining Company شركة المعادن العربية السعودية
This document and the information contained herein is Ma'aden proprietary know-how. This document or any part thereof should not be reproduced, stored in a retrieval system or transmitted by any means, electronic or otherwise, or divulged without prior written permission of Ma'aden.

LARSEN & TOUBRO DRAWING NUMBER: 019045_450_C_G_24164_005 — REVISION: 4
OUTOTEC DRAWING NUMBER: 900707__GAU01__AA03__MTL01__38520 — DOCUMENT ID: OU100695875 — REVISION: 4

DRAWN	SBH	10/09/2020
CHECKED	BDA	11/09/2020
ENGINEER	SUE	10/09/2020
APPROVED	AG	14/09/2020
EMPLOYER		
SCALE	1:30	A1

MANSOURAH - MASSARAH GOLD PROJECT
GENERAL ARRANGEMENT DRAWING
REAGENTS - LIME SLAKING EQUIPMENT
GRADE SLAB DETAILS

DRAWING NUMBER: MD-216-3850-EG-CV-GAD-1432 — REV: D01