


DRAWING NUMBER: MD-216-3860-EG-CV-DED-1432
REV: D01

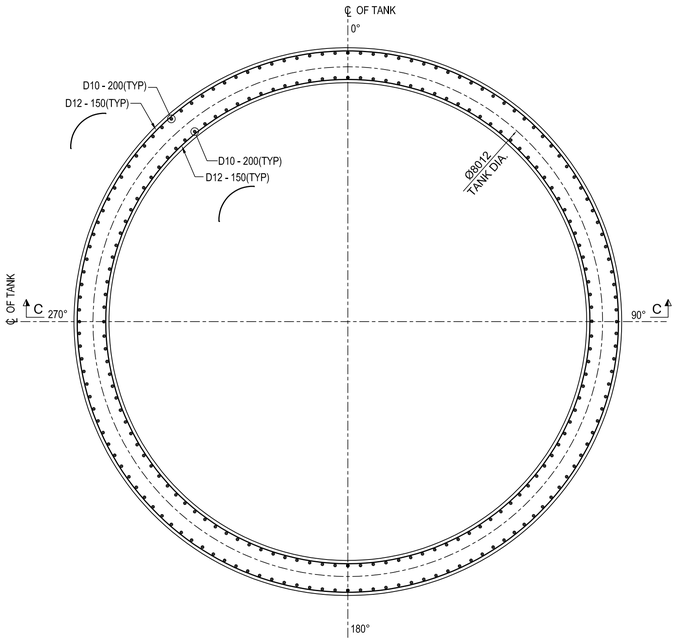


PLAN AT BOTTOM OF FOUNDATION
(3860-REA-002 LIMESTONE DOSING TANK)
(SCALE - 1:50)

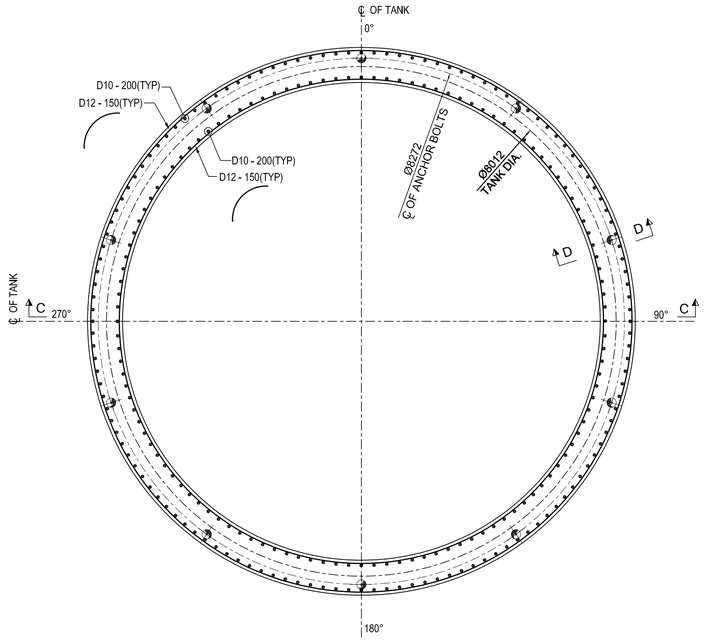


PLAN AT TOP OF FOUNDATION
(3860-REA-002 LIMESTONE DOSING TANK)
(SCALE - 1:50)

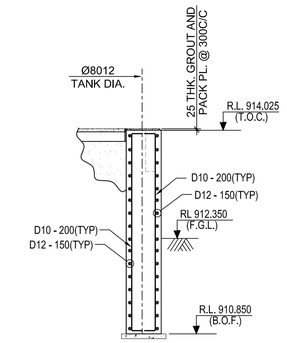


R.C DETAIL OF SECTION D-D
(SCALE - 1:50)

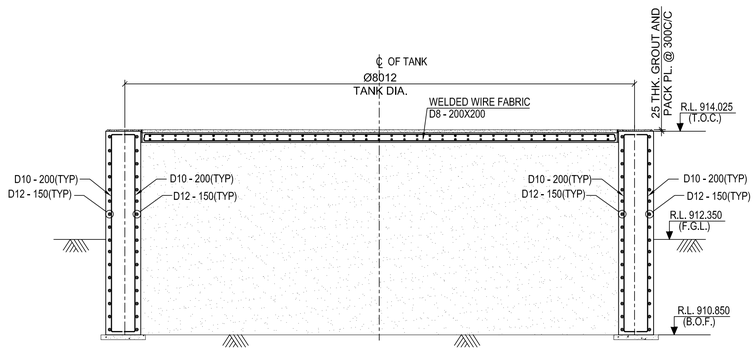


R.C DETAIL OF SECTION C-C
(SCALE - 1:50)

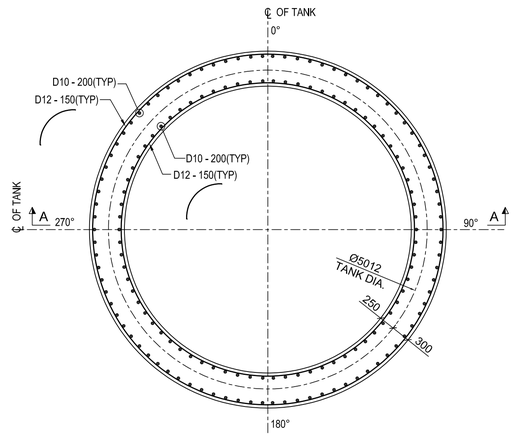


PLAN AT BOTTOM OF FOUNDATION
(3860-REA-001 LIMESTONE MIXING TANK)
(SCALE - 1:50)

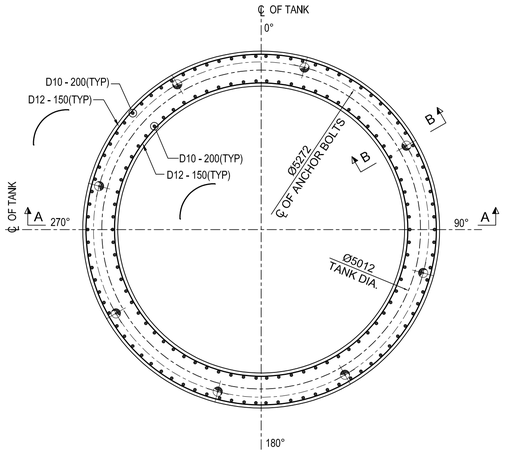

PLAN AT TOP OF FOUNDATION
(3860-REA-001 LIMESTONE MIXING TANK)
(SCALE - 1:50)

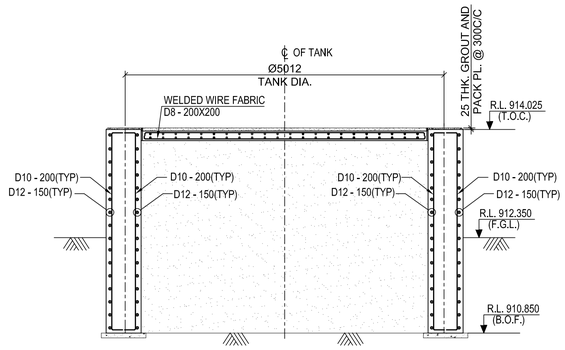

R.C DETAIL OF SECTION A-A
(SCALE - 1:50)

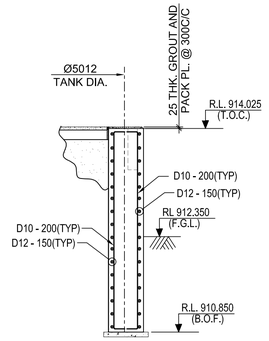

R.C DETAIL OF SECTION B-B
(SCALE - 1:50)

LEGEND.:-
R.L. - REDUCED LEVEL
T.O.C - TOP OF CONCRETE
B.O.F - BOTTOM OF FOUNDATION
F.G.L - FINISHED GROUND LEVEL
P.C.C - PLAIN CEMENT CONCRETE
TYP - TYPICAL
MKD - MARKED
℄ - CENTRE LINE
R.C.C. - REINFORCED CONCRETE
REINF. - REINFORCEMENT
THK. - THICK
PL. - PLATE

NOTES:-
1. ALL DIMENSIONS ARE IN MILLIMETRES AND LEVELS ARE IN METRES UNLESS OTHERWISE STATED.
2. GRADE OF CONCRETE SHALL BE C35 UNLESS OTHERWISE NOTED.
3. GRADE OF REINFORCEMENT SHALL BE DEFORMED BAR ASTM A615 - GRADE 60 (fy=420 MPa)
4. CLEAR COVER TO MAIN REINFORCEMENT SHALL BE AS FOLLOWS:
   a) RING WALL : 50 mm.
   b) SLAB : 25 mm.
5. FOR GA DRAWING REFER DRG. NO. : MD-216-3860-EG-CV-GAD-1431.
6. FOR SPLICE LENGTHS OF REINF. REFER. DWG. NO. MD-261-1000-EG-CV-DED-1001. - CL. NO. 5.3 & 5.4
7. GENERAL NOTE FOR CIVIL WORK REFER DRG. NO : MD-216-1000-EG-CV-DED-1001.
8. FOR STANDARD REINF. DETAIL REFER DRG. NO : MD-216-1000-EG-CV-DED-1005.
9. REINFORCEMENT MAY BE SLIGHTLY ADJUSTED AT SITE TO ACCOMMODATE EMBEDDED PART.

DOCUMENT NUMBER	REFERENCE DOCUMENTS	REV	DATE	REVISION DESCRIPTION	DRN	CHK	ENG	APP	EMP
MD-216-3860-EG-ME-PLN-1002	3860-REA-002 LIMESTONE DOSING TANK	D01	22/02/2023	AS-BUILT	SBH	BDA	SUE	AG	
MD-216-3860-EG-ME-PLN-1001	3860-REA-001 LIMESTONE MIXING TANK	C01	07/08/2020	ISSUED FOR CONSTRUCTION	SBH	BDA	SUE	AG	
MD-216-3860-EG-CV-GAD-1001	PLAN AT EL. +912.350 AND SECTION	A01	13/07/2020	ISSUED FOR REFERENCE	SBH	BDA	SUE	AG	

RESERVED FOR VENDOR LOGO AND DRAWING NUMBER

LARSEN & TOUBRO

This drawing is the property of LARSEN & TOUBRO and must not be passed on to any person or body not authorized by us to receive it nor be copied or otherwise made use either in full or in part by such person or body without our prior permission in writing.

Outotec

The content of these documents are the sole property of Outotec Oyj. Any rights not expressly granted herein are reserved. Reproduction, transfer or distribution of part or all of the contents in any form without prior written permission of Outotec is prohibited.

MA'ADEN معادن
Saudi Arabian Mining Company شركة معادن العربية السعودية

This document and the information contained herein is Ma'aden proprietary know-how. This document or any part thereof should not be reproduced, stored in a retrieval system or transmitted by any means, electronic or otherwise, or divulged without prior written permission of Ma'aden.

LARSEN & TOUBRO DRAWING NUMBER: 019045_450_C_D_24168_001 — REVISION: 2
OUTOTEC DRAWING NUMBER: 900707__GAU01__AA23__CTB17__38601 — DOCUMENT ID: OU100690358 — REVISION: 2

DRAWN	SBH	09/07/2020
CHECKED	BDA	10/07/2020
ENGINEER	SUE	09/07/2020
APPROVED	AG	13/07/2020
EMPLOYER		
SCALE	1:100, 1:50	A1

MANSOURAH - MASSARAH GOLD PROJECT
DETAIL DRAWING
REAGENTS - LIMESTONE EQUIPMENT
TANK FOUNDATION RC DETAILS

DRAWING NUMBER: MD-216-3860-EG-CV-DED-1432 — REV: D01