


DRAWING NUMBER MD-216-3860-EG-CV-DED-1435 REV D01

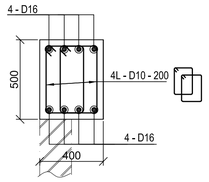


R.C DETAIL OF BEAM MKD. - RB1
(SCALE 1:20)

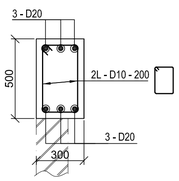


R.C DETAIL OF BEAM MKD. - RB2
(SCALE 1:20)

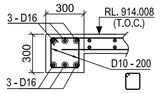


R.C.C DETAIL OF BEAM MKD. B3
(SCALE-1:25)

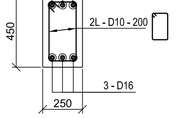


R.C DETAIL OF BEAM MKD. - LB1
(SCALE 1:20)

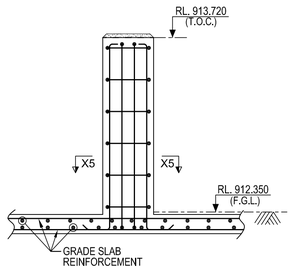


DETAIL OF PEDESTAL MKD. P7G
(REF. DWG. NO : MD-216-3860-EG-CV-GAD-1434)
(SCALE 1:25)

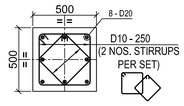


R.C.C DETAIL OF COLUMN MKD. C1
(SCALE 1:25)

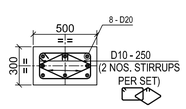


R.C.C DETAIL OF COLUMN MKD. C2
(SCALE 1:25)

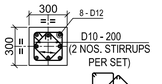


R.C.C DETAIL OF COLUMN MKD. C3
(SCALE 1:25)

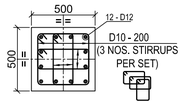


SECTION X5-X5
(SCALE 1:25)

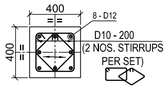


SECTION X4-X4
(SCALE 1:25)

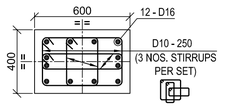


SECTION X3 - X3
(SCALE 1:20)

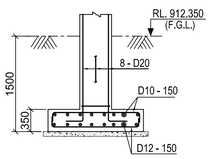


SECTION 1-1
(SCALE-1:50)

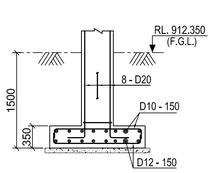


SECTION 2-2
(SCALE-1:50)

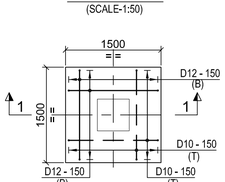


R.C DETAIL OF FOUNDATION - F1A
(SCALE 1:50)

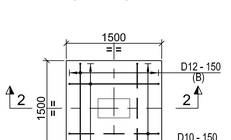


R.C DETAIL OF FOUNDATION - F1B
(SCALE 1:50)

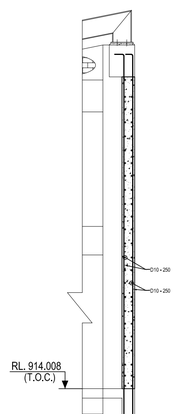


TYPICAL DETAIL OF RCC WALL
(200 THK.)
(SCALE 1:50)

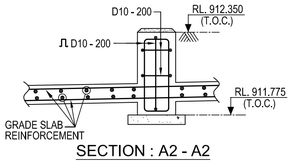


SECTION : A2 - A2
(REF. DWG. NO : MD-216-3860-EG-CV-GAD-1433)
(SCALE 1:25)

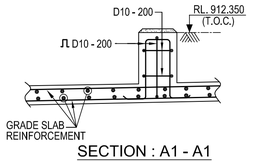


SECTION : A1 - A1
(REF. DWG. NO : MD-216-3860-EG-CV-GAD-1433)
(SCALE 1:25)

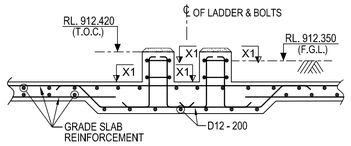


DETAIL OF PEDESTAL MKD. P7A
(REF. DWG. NO : MD-216-3860-EG-CV-GAD-1434)
(SCALE 1:25)

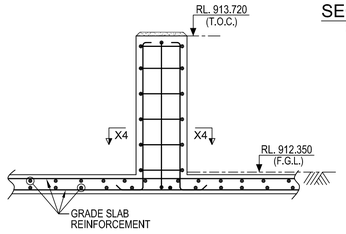


DETAIL OF PEDESTAL MKD. P7F
(REF. DWG. NO : MD-216-3860-EG-CV-GAD-1434)
(SCALE 1:25)

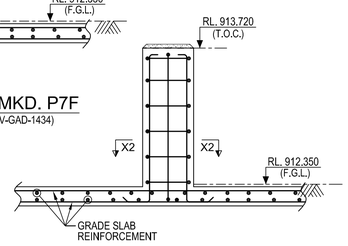


DETAIL OF PEDESTAL MKD. P7B, P7C & P7D
(REF. DWG. NO : MD-216-3860-EG-CV-GAD-1434)
(SCALE 1:25)

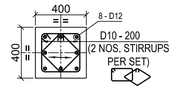


SECTION X2-X2
(SCALE 1:25)

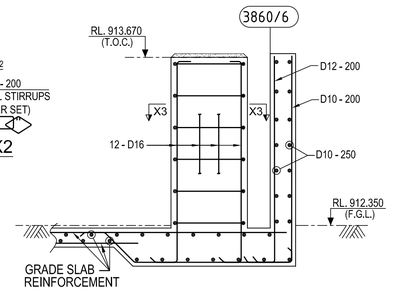


DETAIL OF PEDESTAL MKD. P7E
(REF. DWG. NO : MD-216-3860-EG-CV-GAD-1434)
(SCALE 1:25)

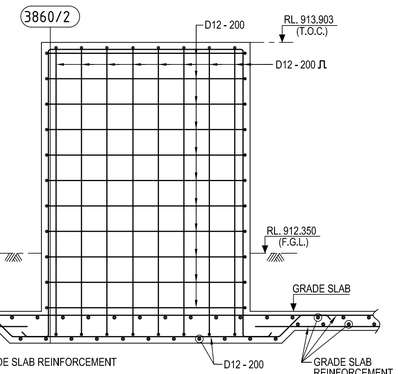


DETAIL OF PEDESTAL MKD. P3 & P4
(REF. DWG. NO : MD-216-3860-EG-CV-GAD-1434)
(SCALE 1:25)

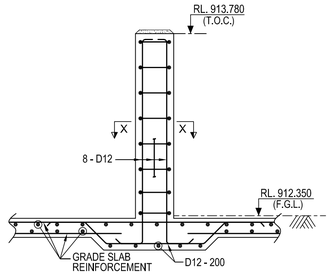


DETAIL OF PEDESTAL MKD. E4 - E4
(REF. DWG. NO : MD-216-3860-EG-CV-GAD-1434)
(SCALE 1:25)

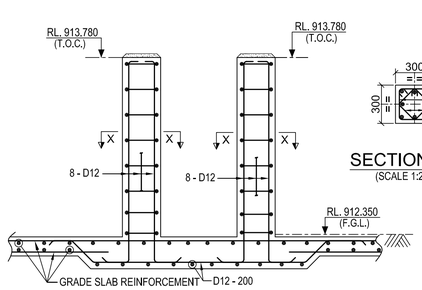


DETAIL OF PEDESTAL MKD. E5 - E5
(REF. DWG. NO : MD-216-3860-EG-CV-GAD-1434)
(SCALE 1:25)

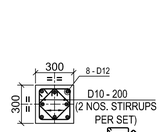


SECTION X-X
(SCALE 1:25)

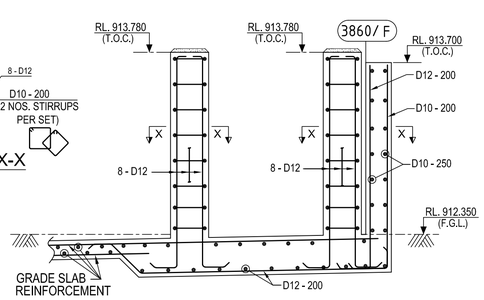


DETAIL OF PEDESTAL MKD. E6 - E6
(REF. DWG. NO : MD-216-3860-EG-CV-GAD-1434)
(SCALE 1:25)

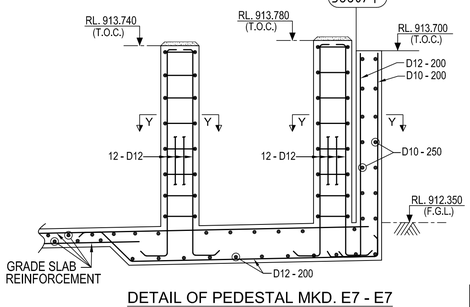


DETAIL OF PEDESTAL MKD. E7 - E7
(REF. DWG. NO : MD-216-3860-EG-CV-GAD-1434)
(SCALE 1:25)

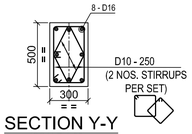


SECTION Y-Y
(SCALE 1:25)

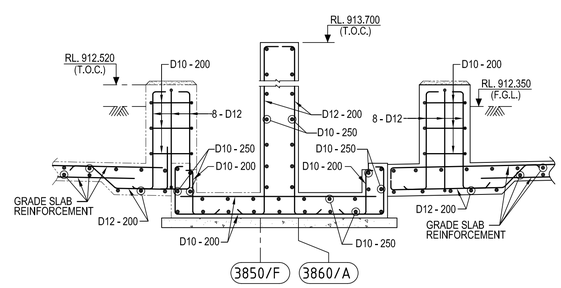


DETAIL OF PEDESTAL MKD. E1 - E1
(REF. DWG. NO : MD-216-3860-EG-CV-GAD-1434)
(SCALE 1:25)

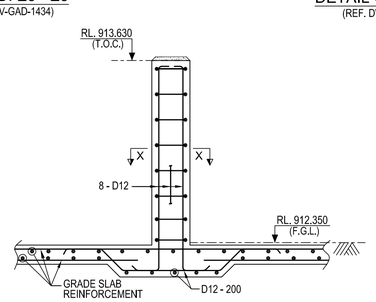

DETAIL OF PEDESTAL MKD. E2 - E2
(REF. DWG. NO : MD-216-3860-EG-CV-GAD-1434)
(SCALE 1:25)

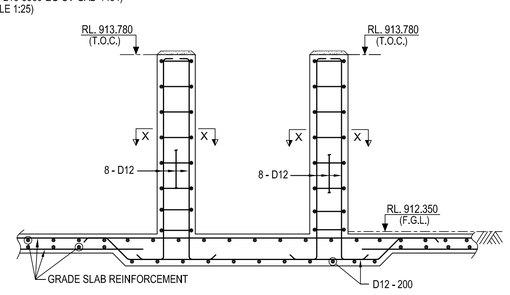

DETAIL OF PEDESTAL MKD. E3 - E3
(REF. DWG. NO : MD-216-3860-EG-CV-GAD-1434)
(SCALE 1:25)

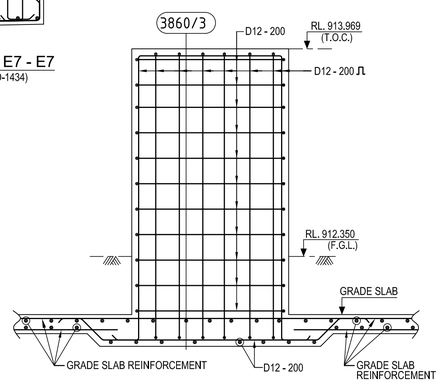

DETAIL OF PEDESTAL MKD. P1 & P2
(REF. DWG. NO : MD-216-3860-EG-CV-GAD-1434)
(SCALE 1:25)

LEGEND:-

R.L. - REDUCED LEVEL
T.O.C - TOP OF CONCRETE
B.O.F - BOTTOM OF FOUNDATION
F.G.L - FINISHED GROUND LEVEL
P.C.C - PLAIN CEMENT CONCRETE
TYP - TYPICAL
MKD - MARKED
℄ - CENTRE LINE
R.C. - REINFORCED CONCRETE
REINF. - REINFORCEMENT

NOTES:-

1. ALL DIMENSIONS ARE IN MILLIMETRES AND LEVELS ARE IN METRES UNLESS OTHERWISE STATED.
2. GRADE OF CONCRETE SHALL BE C35 UNLESS OTHERWISE NOTED.
3. GRADE OF REINFORCEMENT SHALL BE DEFORMED BAR ASTM A615 - GRADE 60 (fy=420 MPa)
4. CLEAR COVER TO MAIN REINFORCEMENT SHALL BE AS FOLLOWS:
   a) FOUNDATION : 50 mm.
   b) COLUMN : 50 mm.
   c) WALL : 50 mm. (FOR DOUBLE LAYER REINF.) VERTICAL REINF. PLACED AT CENTRE (FOR SINGLE LAYER REINF.)
   d) SLAB : 20 mm.
5. FOR GA DRAWING REFER DRG. NO. : MD-216-3860-EG-CV-GAD-1433 & 1434.
6. GENERAL NOTE FOR CIVIL WORK REFER DRG. NO : MD-216-1000-EG-CV-DED-1001.
7. FOR STANDARD REINFORCEMENT DETAIL REFER DRG. NO : MD-216-1000-EG-CV-DED-1005.
8. REINFORCEMENT MAY BE SLIGHTLY ADJUSTED AT SITE TO ACCOMMODATE THE EMBEDDED PART.

DOCUMENT NUMBER	REFERENCE DOCUMENTS	REV	DATE	REVISION DESCRIPTION	DRN	CHK	ENG	APP	EMP
		D01	22/02/2023	AS-BUILT	SBH	BDA	SUE	AG	
		C03	22/01/2021	ISSUED FOR CONSTRUCTION & REVISED AS MKD. C03	SBH	BDA	SUE	AG	
		C02	28/12/2020	ISSUED FOR CONSTRUCTION & REVISED AS MKD. C02	SBH	BDA	SUE	AG	
		C01	03/11/2020	ISSUED FOR CONSTRUCTION & REVISED AS MKD. C01	SBH	BDA	SUE	AG	
		A01	23/09/2020	ISSUED FOR REFERENCE	SBH	BDA	SUE	AG	

RESERVED FOR VENDOR LOGO AND DRAWING NUMBER

LARSEN & TOUBRO

This drawing is the property of LARSEN & TOUBRO and must not be passed on to any person or body not authorized by us to receive it nor be copied or otherwise made use either in full or in part by such person or body without our prior permission in writing.

Outotec

The content of these documents are the sole property of Outotec Oyj. Any rights not expressly granted herein are reserved. Reproduction, transfer or distribution of part or all of the contents in any form without prior written permission of Outotec is prohibited.

MA'ADEN معادن
Saudi Arabian Mining Company شركة المعادن العربية السعودية

This document and the information contained herein is Ma'aden proprietary know-how. This document or any part thereof should not be reproduced, stored in a retrieval system or transmitted by any means, electronic or otherwise, or divulged without prior written permission of Ma'aden.

LARSEN & TOUBRO DRAWING NUMBER: 019045_450_C_D_24168_004 — REVISION: 4
OUTOTEC DRAWING NUMBER: 900707__GAU01__AA23__CTB17__38604 — DOCUMENT ID: OU100698208 — REVISION: 4

DRAWN	SBH	23/09/2020
CHECKED	BDA	24/09/2020
ENGINEER	SUE	23/09/2020
APPROVED	AG	25/09/2020
EMPLOYER		
SCALE	1:100, 1:50	A1

MANSOURAH - MASSARAH GOLD PROJECT
DETAIL DRAWING
REAGENTS - LIMESTONE EQUIPMENT
GRADE SLAB RC DETAILS

DRAWING NUMBER: MD-216-3860-EG-CV-DED-1435 — REV: D01