


DRAWING NUMBER: MD-216-3860-EG-CV-GAD-1432 | REV: D01

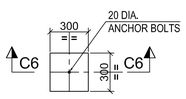


DETAIL OF COLUMN MKD. - C6
(SCALE-1:25)

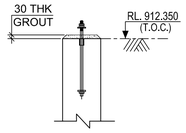


SECTION : C6 - C6
(SCALE-1:25)

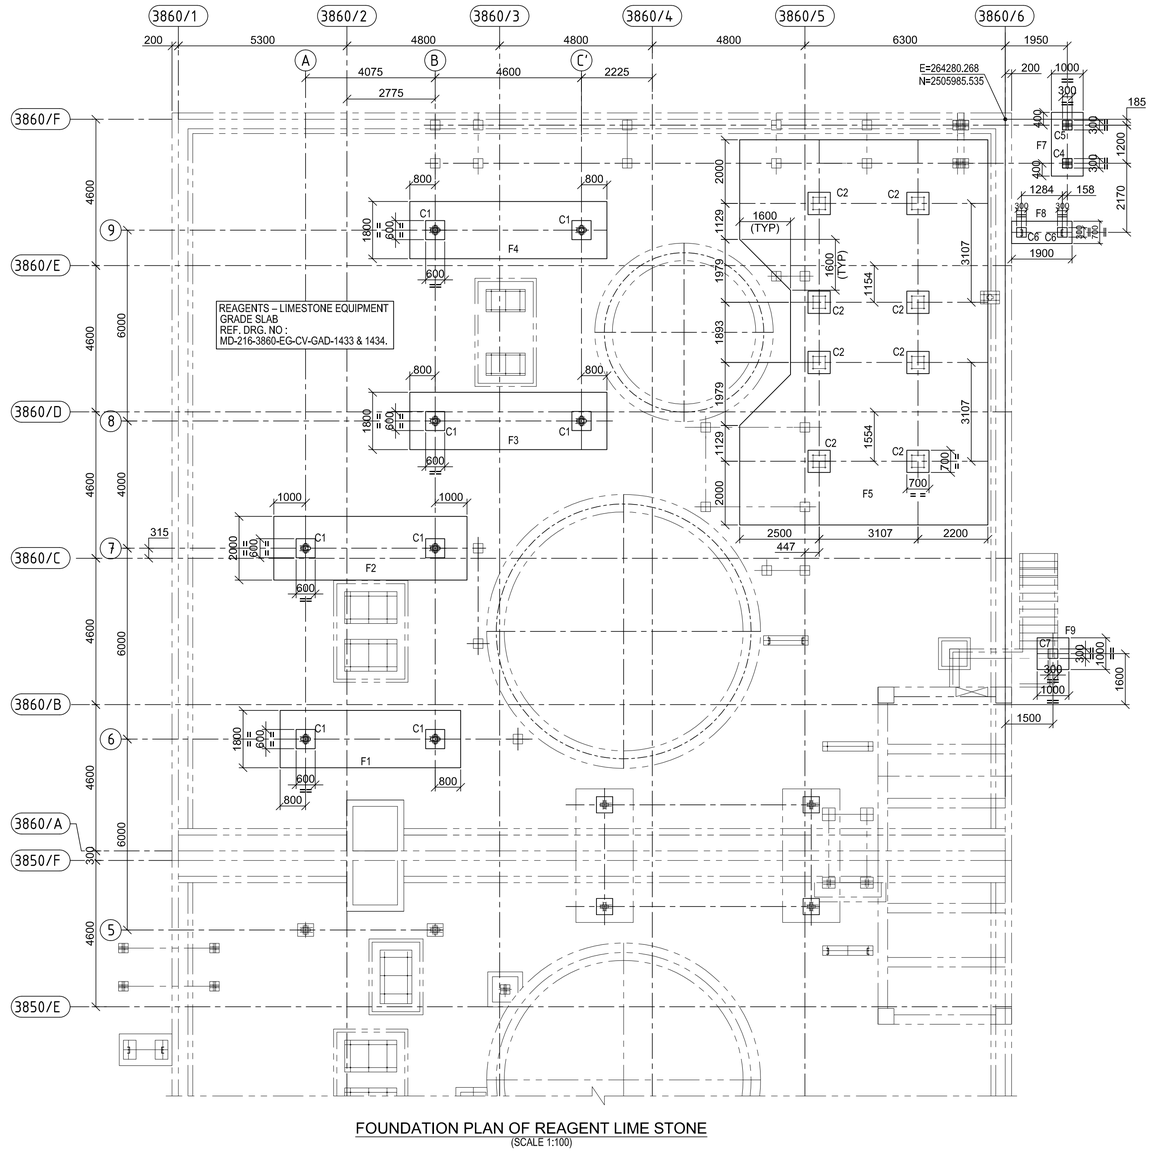


FOUNDATION PLAN OF REAGENT LIME STONE
(SCALE 1:100)

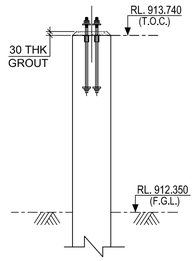


SECTION : C4 - C4
(SCALE-1:25)

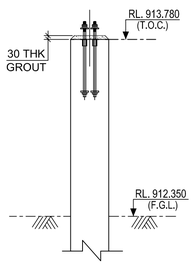

SECTION : C5 - C5
(SCALE-1:25)

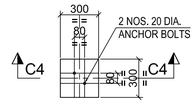


DETAIL OF COLUMN MKD. - C4
(SCALE-1:25)

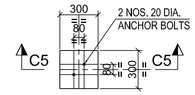


DETAIL OF COLUMN MKD. - C5
(SCALE-1:25)


SECTION : C1 - C1
(SCALE-1:25)

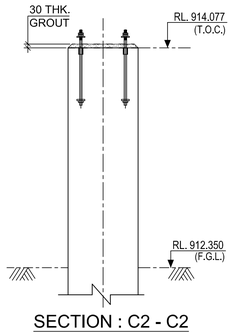


SECTION : C2 - C2
(SCALE-1:25)

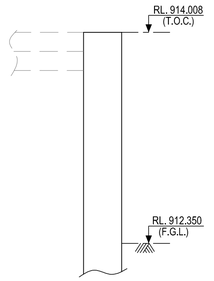


SECTION : C7 - C7
(SCALE-1:25)

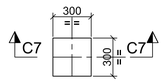


DETAIL OF COLUMN MKD. - C7
(SCALE-1:25)

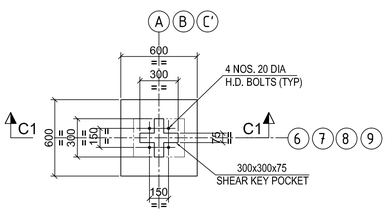

DETAIL OF COLUMN MKD. - C1
(SCALE-1:25)

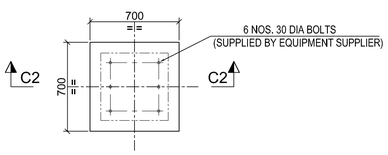

DETAIL OF COLUMN MKD. - C2
(SCALE-1:25)

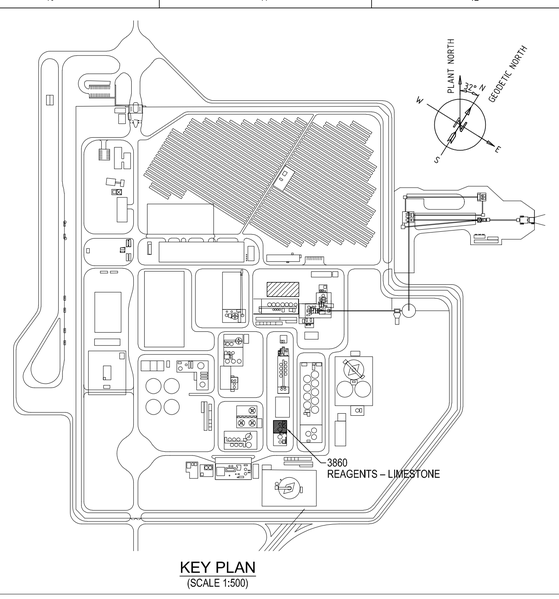

KEY PLAN
(SCALE 1:500)

LEGEND :-

R.L. - REDUCED LEVEL
T.O.C. - TOP OF CONCRETE.
F.G.L. - FINISHED GROUND LEVEL.
TYP. - TYPICAL.
P.C.C - PLAIN CEMENT CONCRETE
MKD. - MARKED.
THK. - THICK
℄ - CENTRE LINE

NOTES:-

1. ALL DIMENSIONS ARE IN MILLIMETRES AND LEVELS ARE IN METRES UNLESS OTHERWISE STATED.
2. GRADE OF CONCRETE SHALL BE C35 UNLESS NOTED OTHERWISE.
3. GRADE OF REINFORCEMENT SHALL BE DEFORMED BAR ASTM A615-GRADE 60 (fy=420 MPa)
4. NET SAFE BEARING CAPACITY OF SOIL AT BOTTOM OF FOUNDATION CONSIDERED 670KN/SQ.M.
5. IF ANY PART OF FOUNDATION COMES ON BACKFILL ZONE OF ADJACENT FOUNDATION OR ANY LOOSE POCKETS ARE ENCOUNTERED BELOW FOUNDATION LEVEL THE SAME SHALL BE REMOVED AND FILLED WITH PCC.
6. FOR REINFORCEMENTS DETAIL REFER DRG. NO. MD - 216 - 3860 - EG - CV - DED - 1433.
7. FOR FOUNDATION BOLT DETAILS REFER DRG. NO : MD-216-1000-EG-CV-DED-1003.
8. FOR GENERAL NOTE FOR CIVIL WORK REFER DRG. NO : MD-216-1000-EG-CV-DED-1001.

DOCUMENT NUMBER	REFERENCE DOCUMENTS	REV	DATE	REVISION DESCRIPTION	DRN	CHK	ENG	APP	EMP
MD-216-3850-EG-ST-GAD-2355	PLAN, ELEVATIONS & DETAILS								
MD-216-3850-EG-ST-GAD-2005	MONORAIL BEAM SUPRTS & WLKWAY DET								
MD-216-3850-EG-ST-GAD-2004	MONORAIL BEAM SUPRTS & WLKWAY DET								
MD-216-3850-EG-ST-GAD-2003	MONORAIL BEAM SUPRTS & WLKWAY DET								
MD-216-3850-EG-ME-GAD-1014	PLAN AT EL. +912.350								
MD-216-3850-EG-ME-GAD-1009	SECTION C-C								
MD-216-3850-EG-ME-GAD-1008	SECTION B-B	D01	22/02/2023	AS-BUILT	SBH	BDA	SUE	AG	
MD-216-3850-EG-ME-GAD-1007	SECTION A-A	C03	19/12/2020	ISSUED FOR CONSTRUCTION & REVISED AS MKD. C03	SBH	BDA	SUE	AG	
MD-216-3850-EG-ME-GAD-1006	PLAN VIEW	C02	28/11/2020	ISSUED FOR CONSTRUCTION & REVISED AS MKD. C02	SBH	BDA	SUE	AG	
MD-216-3850-EG-ME-GAD-1004	PLAN AT EL. +912.350	C01	03/11/2020	ISSUED FOR CONSTRUCTION & REVISED AS MKD. C01	SBH	BDA	SUE	AG	
MD-216-3860-EG-CV-GAD-1001	PLAN AT EL. +912.350 AND SECTIONS	A01	29/09/2020	ISSUED FOR REFERENCE	SBH	BDA	SUE	AG	

RESERVED FOR VENDOR LOGO AND DRAWING NUMBER

LARSEN & TOUBRO

This drawing is the property of *LARSEN & TOUBRO* and must not be passed on to any person or body not authorized by us to receive it nor be copied or otherwise made use either in full or in part by such person or body without our prior permission in writing.

Outotec

The content of these documents are the sole property of Outotec Oyj. Any rights not expressly granted herein are reserved. Reproduction, transfer or distribution of part or all of the contents in any form without prior written permission of Outotec is prohibited.

MA'ADEN معادن
Saudi Arabian Mining Company شركة المعادن العربية السعودية

This document and the information contained herein is Ma'aden proprietary know-how. This document or any part thereof should not be reproduced, stored in a retrieval system or transmitted by any means, electronic or otherwise, or divulged without prior written permission of Ma'aden.

LARSEN & TOUBRO DRAWING NUMBER: 019045_450_C_G_24167_002 | REVISION: 4
OUTOTEC DRAWING NUMBER: 900707 _GAU01 _AA23_MTL01 _38604 | DOCUMENT ID: OU100695878 | REVISION: 4

DRAWN	SBH	26/09/2020
CHECKED	BDA	28/09/2020
ENGINEER	SUE	26/09/2020
APPROVED	AG	29/09/2020
EMPLOYER		
SCALE	1:100 1:25	A1

MANSOURAH - MASSARAH GOLD PROJECT
GENERAL ARRANGEMENT DRAWING
REAGENTS - LIMESTONE EQUIPMENT
FOUNDATION PLAN

DRAWING NUMBER: MD - 216 - 3860 - EG - CV - GAD - 1432 | REV: D01