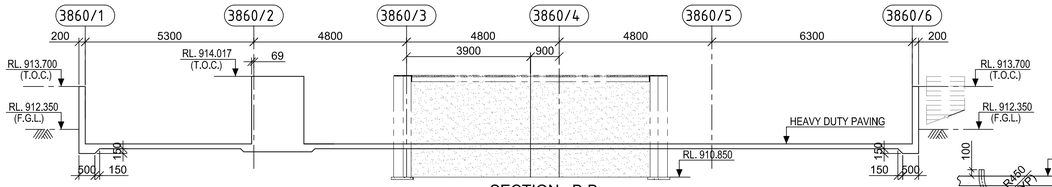
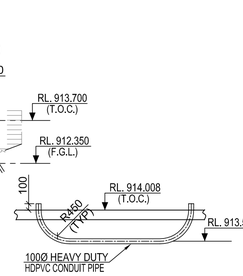
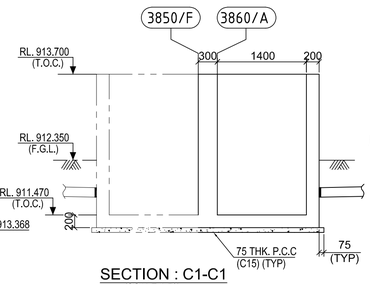
DRAWING NUMBER: MD-216-3860-EG-CV-GAD-1433 | REV: D01



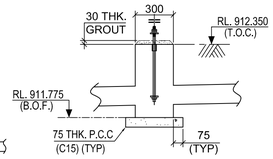

SECTION : B-B
(SCALE 1:100)



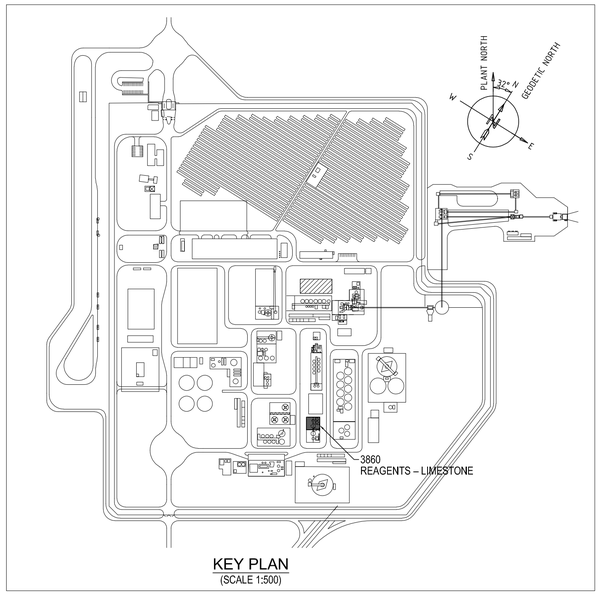

TYPICAL DETAIL OF CONDUIT
(SCALE 1:50)



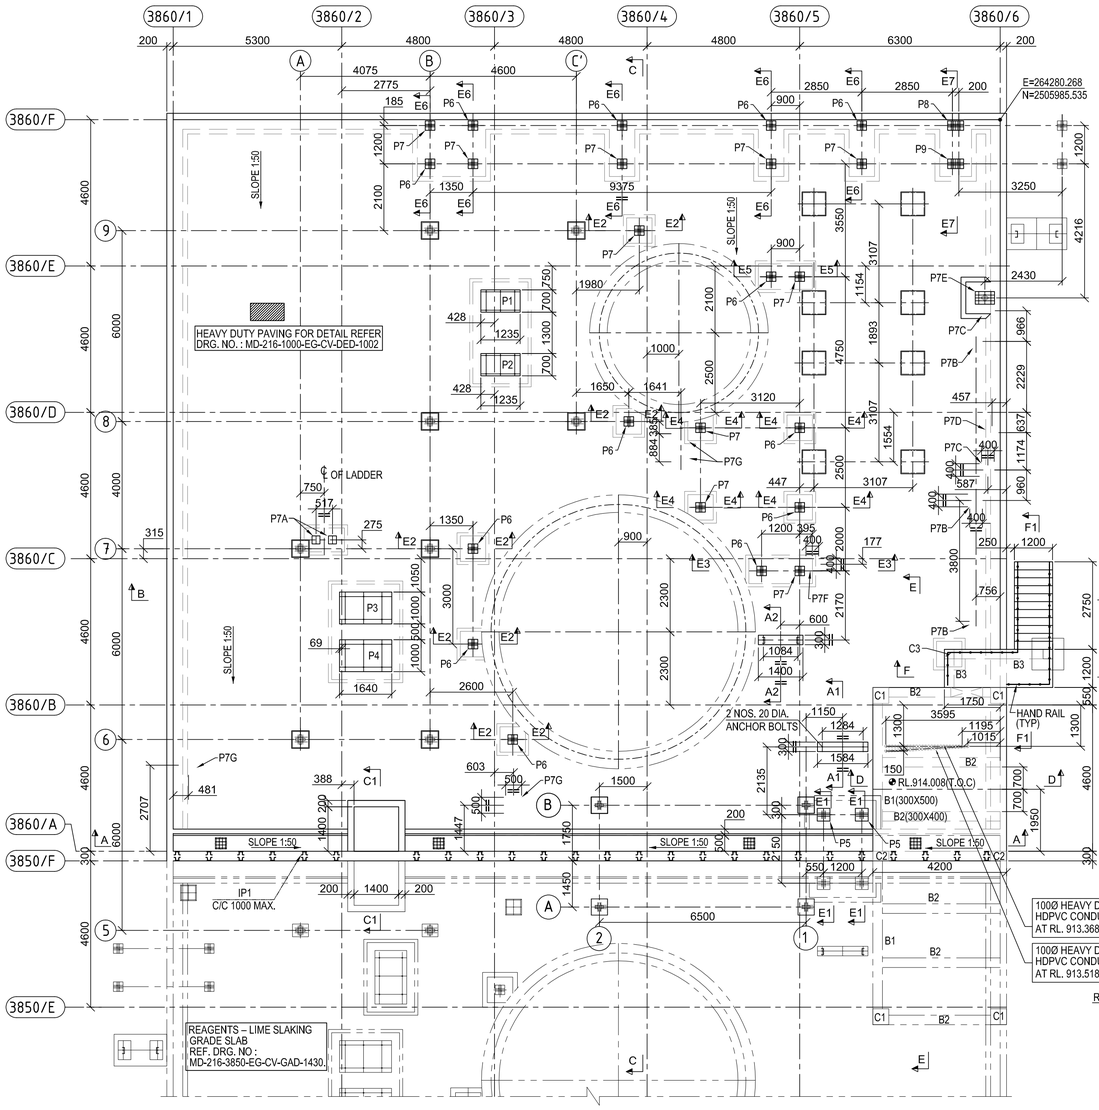

SECTION : C1-C1
(SCALE 1:50)



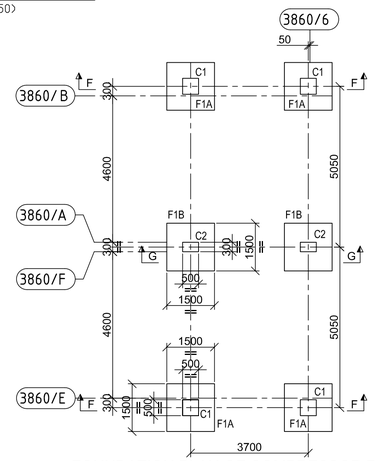

SECTION : A2 - A2
(SCALE 1:25)



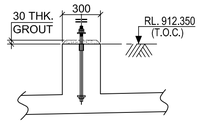

KEY PLAN
(SCALE 1:500)



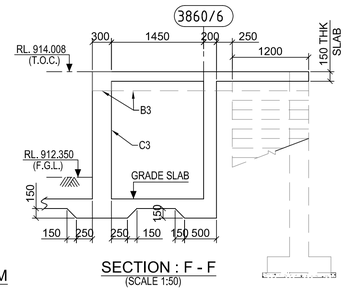

GRADE SLAB PLAN OF REAGENT LIME STONE
(SCALE 1:100)



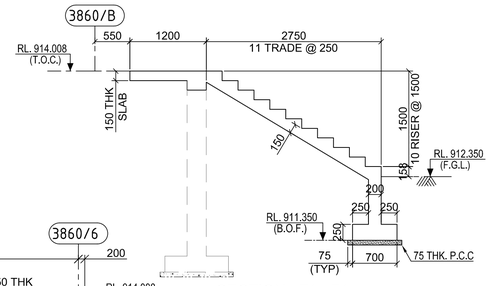

FOUNDATION PLAN OF COMPRESSOR ROOM
(SCALE 1:100)



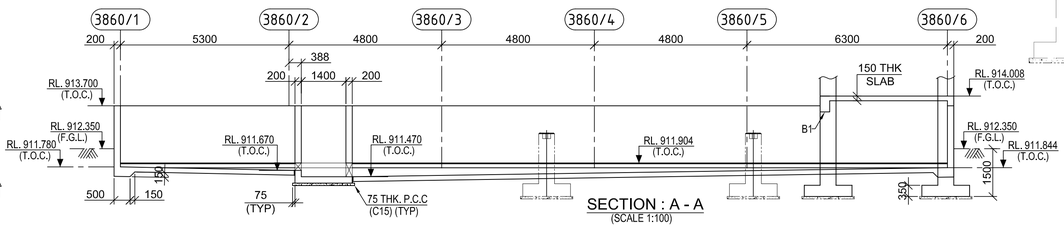

SECTION : A1 - A1
(SCALE 1:25)



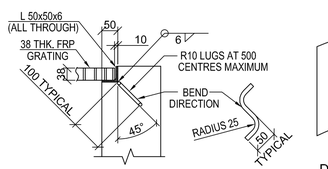

SECTION : F - F
(SCALE 1:50)



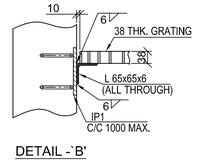

SECTION : F1 - F1
(SCALE 1:50)



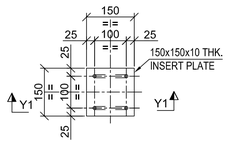

SECTION : A - A
(SCALE 1:100)



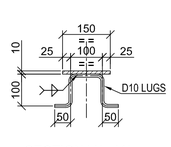

DETAIL -`A'
(SCALE 1:10)



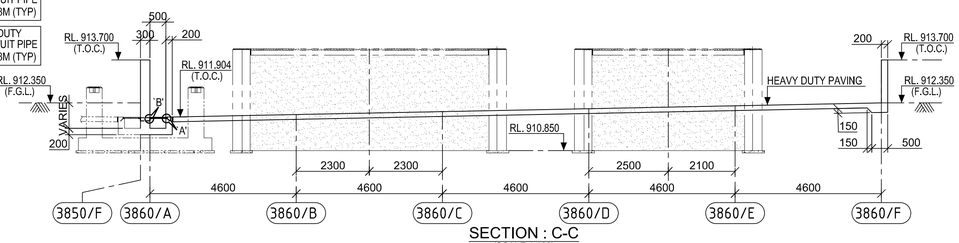

DETAIL -`B'
(SCALE 1:10)




DETAIL OF INSERT PLATE - IP1
(SCALE 1:10)




SECTION Y1 - Y1
(SCALE 1:10)




SECTION : C-C
(SCALE 1:100)

CHEMICAL RESISTANT COATING SHALL BE APPLIED TO THE ALL EXPOSED SURFACE OF CONCRETE INSIDE BUND WALL TO PROTECT AGAINST ACID / ALKALI.

## LEGEND :-

R.L. - REDUCED LEVEL
T.O.C. - TOP OF CONCRETE.
F.G.L. - FINISHED GROUND LEVEL.
B.O.F. - BOTTOM OF FOUNDATION.
TYP. - TYPICAL.
P.C.C - PLAIN CEMENT CONCRETE
MKD. - MARKED.
THK. - THICK

## NOTES :-

1. ALL DIMENSIONS ARE IN MILLIMETRES AND LEVELS AND CO-ORDINATES ARE IN METRES, UNLESS OTHERWISE STATED.
2. GRADE OF CONCRETE SHALL BE C35.
3. GRADE OF REINFORCEMENT SHALL BE DEFORMED BAR ASTM A615 - GRADE 60 (fy = 420 MPa).
4. IF ANY PART OF FOUNDATION COMES ON BACKFILL ZONE OF ADJACENT FOUNDATION OR ANY LOOSE POCKETS ARE ENCOUNTERED BELOW FOUNDATION LEVEL THE SAME SHALL BE REMOVED AND FILLED WITH PCC.
5. FOR OTHER SECTION GA & DETAILS REFER DRG. NO : MD-216-3860-EG-CV-GAD-1434.
6. FOR REINFORCEMENT DETAIL REF. DRG. NO : MD-216-3860-EG-CV-DED-1434 & 1435.
7. FOR STANDARD DETAILS OF PAVING REF. DRG. NO : MD-216-1000-EG-CV-DED-1002.
8. FOR GENERAL NOTE FOR CIVIL WORK REFER DRG. NO : MD-216-1000-EG-CV-DED-1001.
9. FOR BOLT DETAILS REFER DRG. NO : MD-216-1000-EG-CV-DED-1003.
10. BAND WALL CONSTRUCTION WILL BE DONE AFTER ERECTION OF STRUCTURAL PLATFORM
11. FOR ELECTRICAL CABLE ROUTE LAYOUT EMBEDDED PART REF. DRG. NO : MD-216-3850-EG-EL-LAD-1005.

| DOCUMENT NUMBER | REFERENCE DOCUMENTS | REV | DATE | REVISION DESCRIPTION | DRN | CHK | ENG | APP | EMP |
|---|---|---|---|---|---|---|---|---|---|
| MD-216-3850-EG-ST-GAD-2355 | PLAN, ELEVATIONS & DETAILS | | | | | | | | |
| MD-216-3850-EG-ST-GAD-2005 | MONORAIL BEAM SUPRTS & WLKWAY DET | | | | | | | | |
| MD-216-3850-EG-ST-GAD-2004 | MONORAIL BEAM SUPRTS & WLKWAY DET | | | | | | | | |
| MD-216-3850-EG-ST-GAD-2003 | MONORAIL BEAM SUPRTS & WLKWAY DET | | | | | | | | |
| MD-216-3850-EG-ME-GAD-1014 | PLAN AT EL. +912.350 | | | | | | | | |
| MD-216-3850-EG-ME-GAD-1009 | SECTION C-C | D01 | 22/02/2023 | AS-BUILT | SBH | BDA | SUE | AG | |
| MD-216-3850-EG-ME-GAD-1008 | SECTION B-B | C04 | 08/03/2021 | ISSUED FOR CONSTRUCTION & REVISED AS MKD. C04 | SBH | BDA | SUE | AG | |
| MD-216-3850-EG-ME-GAD-1007 | SECTION A-A | C03 | 22/01/2021 | ISSUED FOR CONSTRUCTION & REVISED AS MKD. C03 | SBH | BDA | SUE | AG | |
| MD-216-3850-EG-ME-GAD-1006 | PLAN VIEW | C02 | 28/12/2020 | ISSUED FOR CONSTRUCTION & REVISED AS MKD. C02 | SBH | BDA | SUE | AG | |
| MD-216-3850-EG-ME-GAD-1004 | PLAN AT EL. +912.350 | C01 | 03/11/2020 | ISSUED FOR CONSTRUCTION & REVISED AS MKD. C01 | SBH | BDA | SUE | AG | |
| MD-216-3860-EG-CV-GAD-1001 | PLAN AT EL. +912.350 AND SECTIONS | A01 | 25/09/2020 | ISSUED FOR REFERENCE | SBH | BDA | SUE | AG | |

RESERVED FOR VENDOR LOGO AND DRAWING NUMBER

LARSEN & TOUBRO

This drawing is the property of LARSEN & TOUBRO and must not be passed on to any person or body not authorized by us to receive it nor be copied or otherwise made use either in full or in part by such person or body without our prior permission in writing.

Outotec

The content of these documents are the sole property of Outotec Oyj. Any rights not expressly granted herein are reserved. Reproduction, transfer or distribution of part or all of the contents in any form without prior written permission of Outotec is prohibited.

MA'ADEN معادن
Saudi Arabian Mining Company شركة معادن العربية السعودية

This document and the information contained herein is Ma'aden proprietary know-how. This document or any part thereof should not be reproduced, stored in a retrieval system or transmitted by any means, electronic or otherwise, or divulged without prior written permission of Ma'aden.

| | | | |
|---|---|---|---|
| LARSEN & TOUBRO DRAWING NUMBER | 019045_450_C_G_24167_003 | | REVISION 5 |
| OUTOTEC DRAWING NUMBER | 900707__GAU01__AA23__MTL01__38605 | DOCUMENT ID OU100695879 | REVISION 5 |
| DRAWN | SBH | 23/09/2020 | |
| CHECKED | BDA | 24/09/2020 | |
| ENGINEER | SUE | 23/09/2020 | |
| APPROVED | AG | 25/09/2020 | |
| EMPLOYER | | | |
| SCALE | 1:30 | A1 | |

MANSOURAH - MASSARAH GOLD PROJECT
GENERAL ARRANGEMENT DRAWING
REAGENTS - LIMESTONE EQUIPMENT
GRADE SLAB

DRAWING NUMBER: MD-216-3860-EG-CV-GAD-1433 | REV: D01