MD - 216 - 49PR - EG - CV - GAD - 2011
DRAWING NUMBER
D01
REV

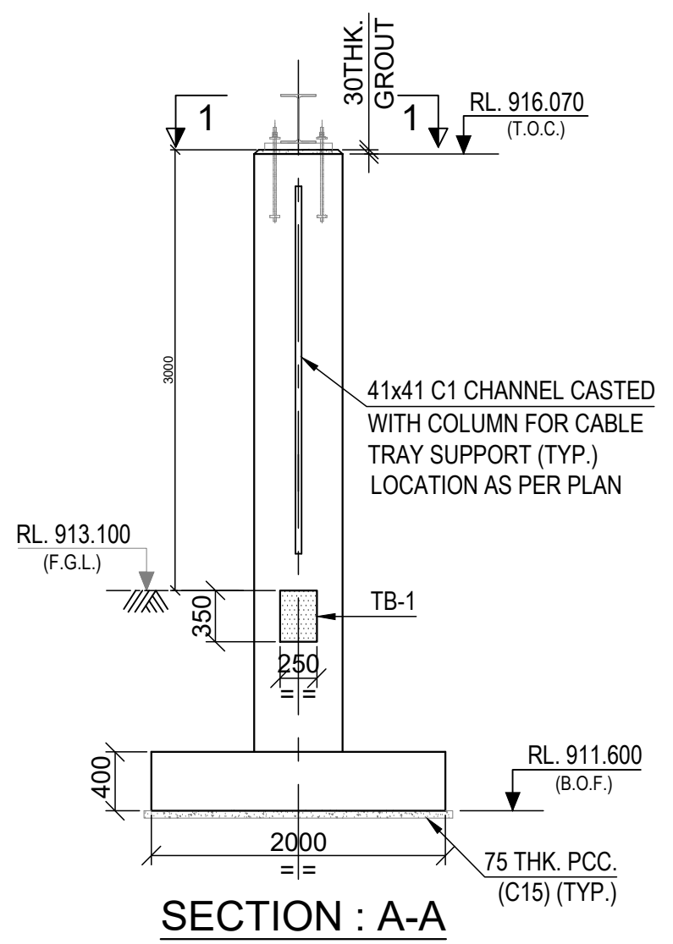

SECTION : A-A
SCALE 1:50

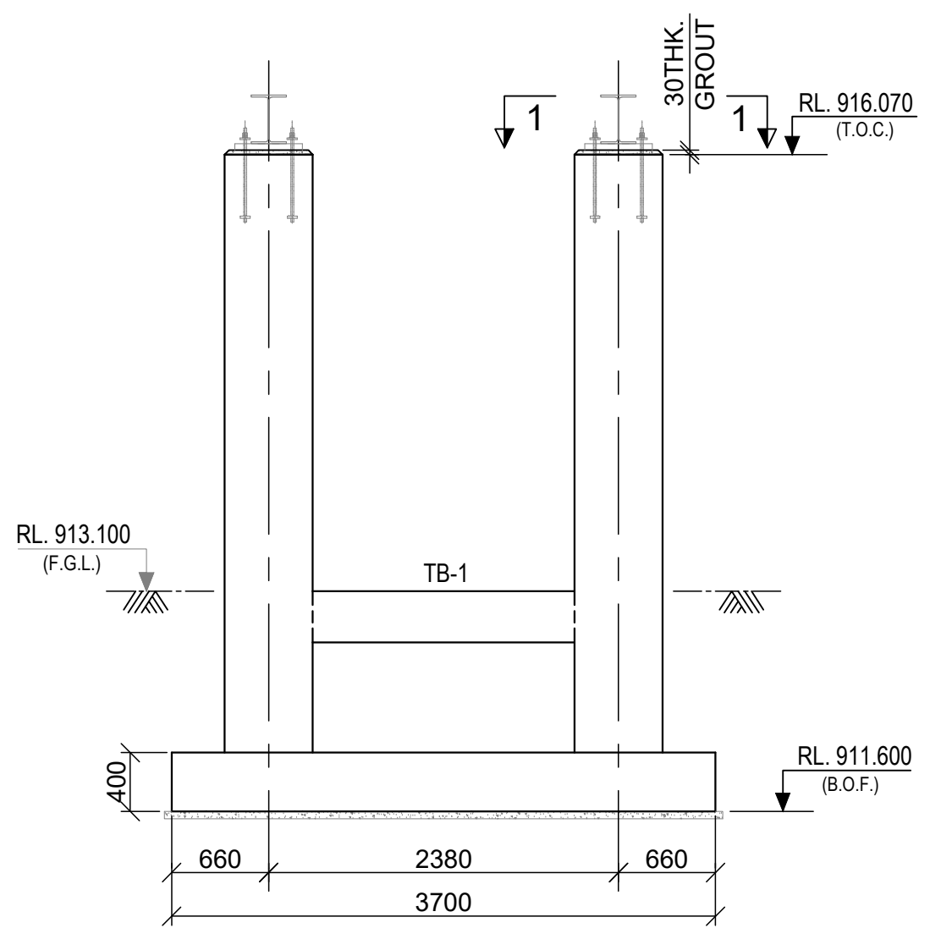

SECTION : B-B
SCALE 1:50

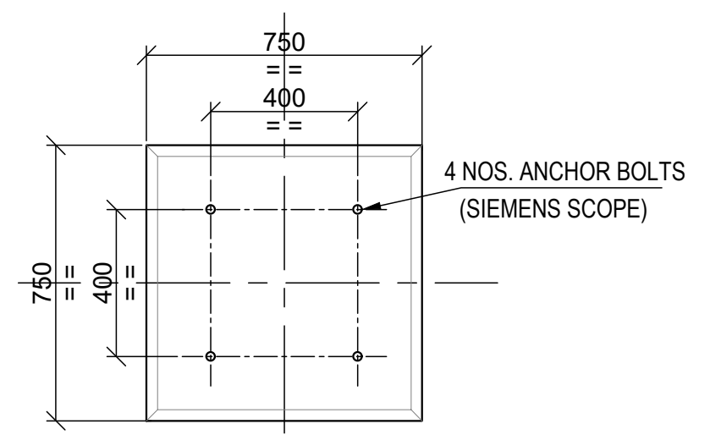

VIEW : 1-1
(DETAIL OF COL. MKD. C1)
SCALE 1:20

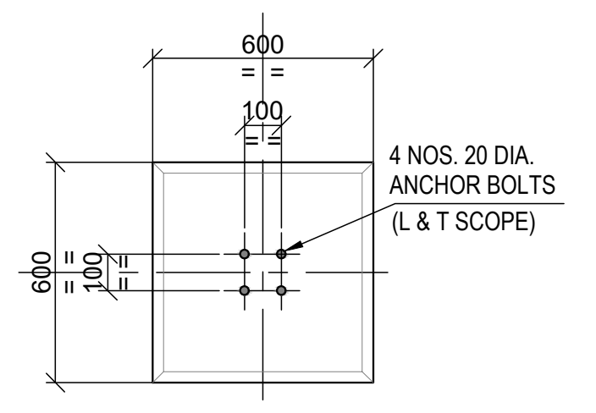

VIEW : 2-2
(DETAIL OF COL. MKD. C2)
SCALE 1:20

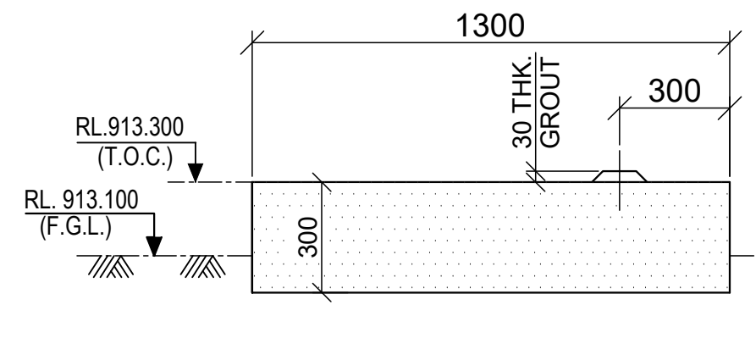

SECTION : F - F
(SCALE - 1 : 20)

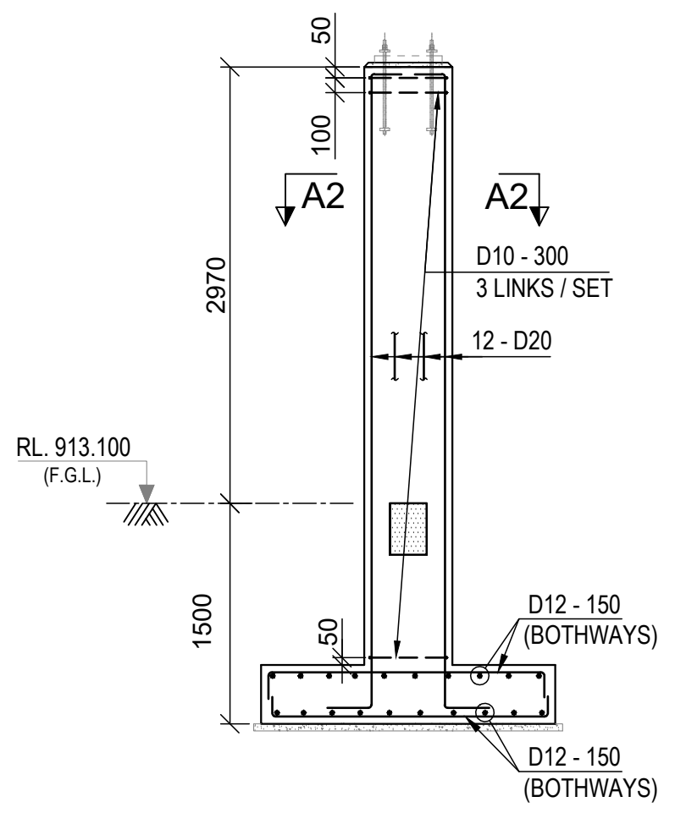

SECTION : A1-A1
SCALE 1:50

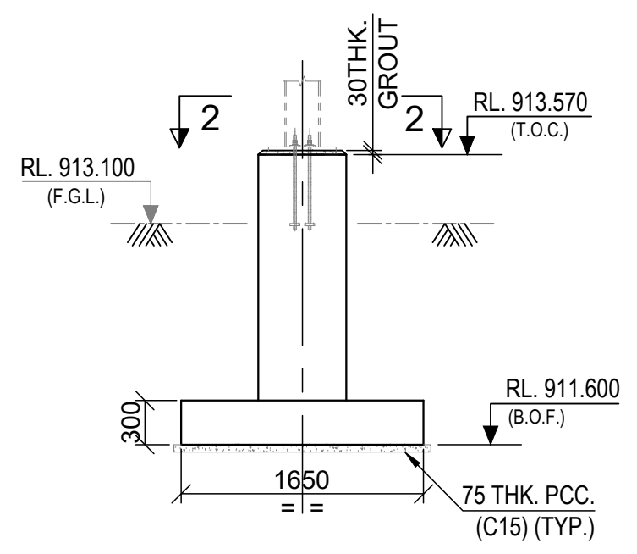

SECTION : C-C
SCALE 1:50

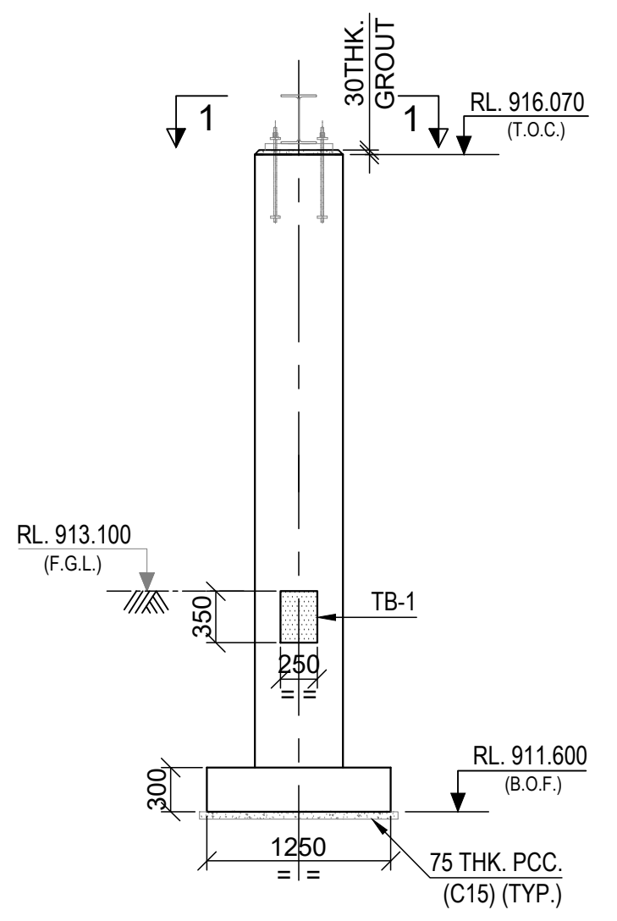

SECTION : D-D
SCALE 1:50

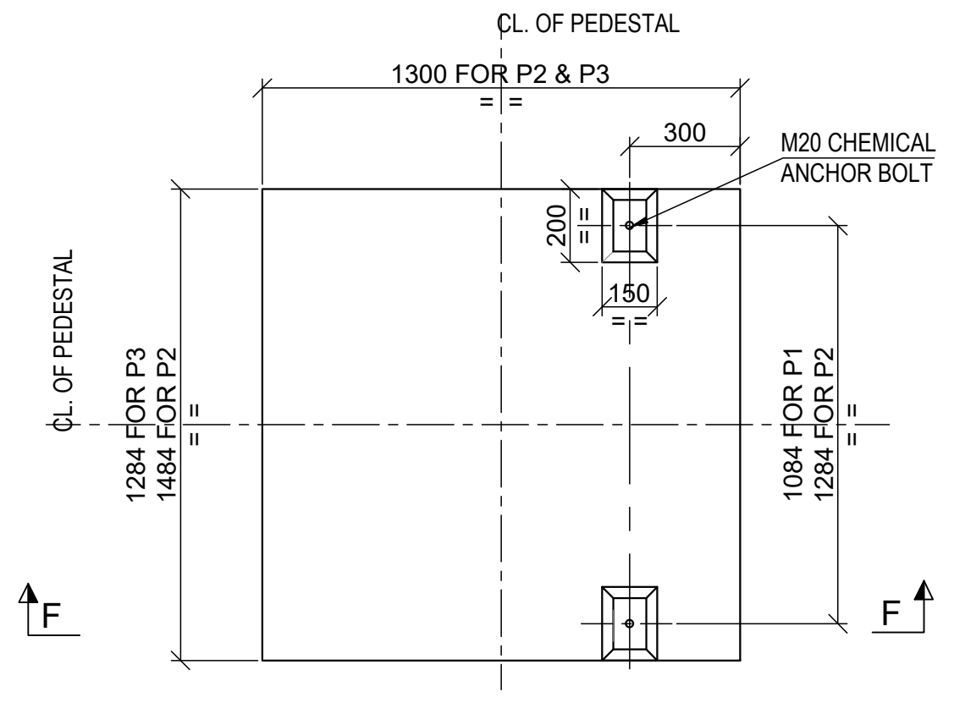

DETAIL OF PEDESTAL
MKD. P2 & P3
(SCALE - 1:20)

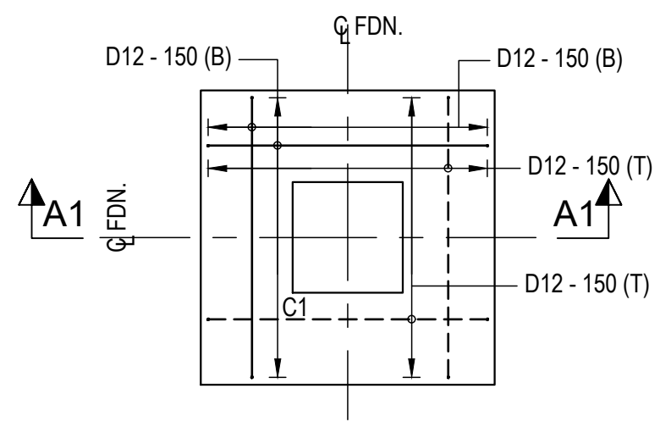

RC. DET. OF FOUNDATION
MKD. F1
SCALE 1:50

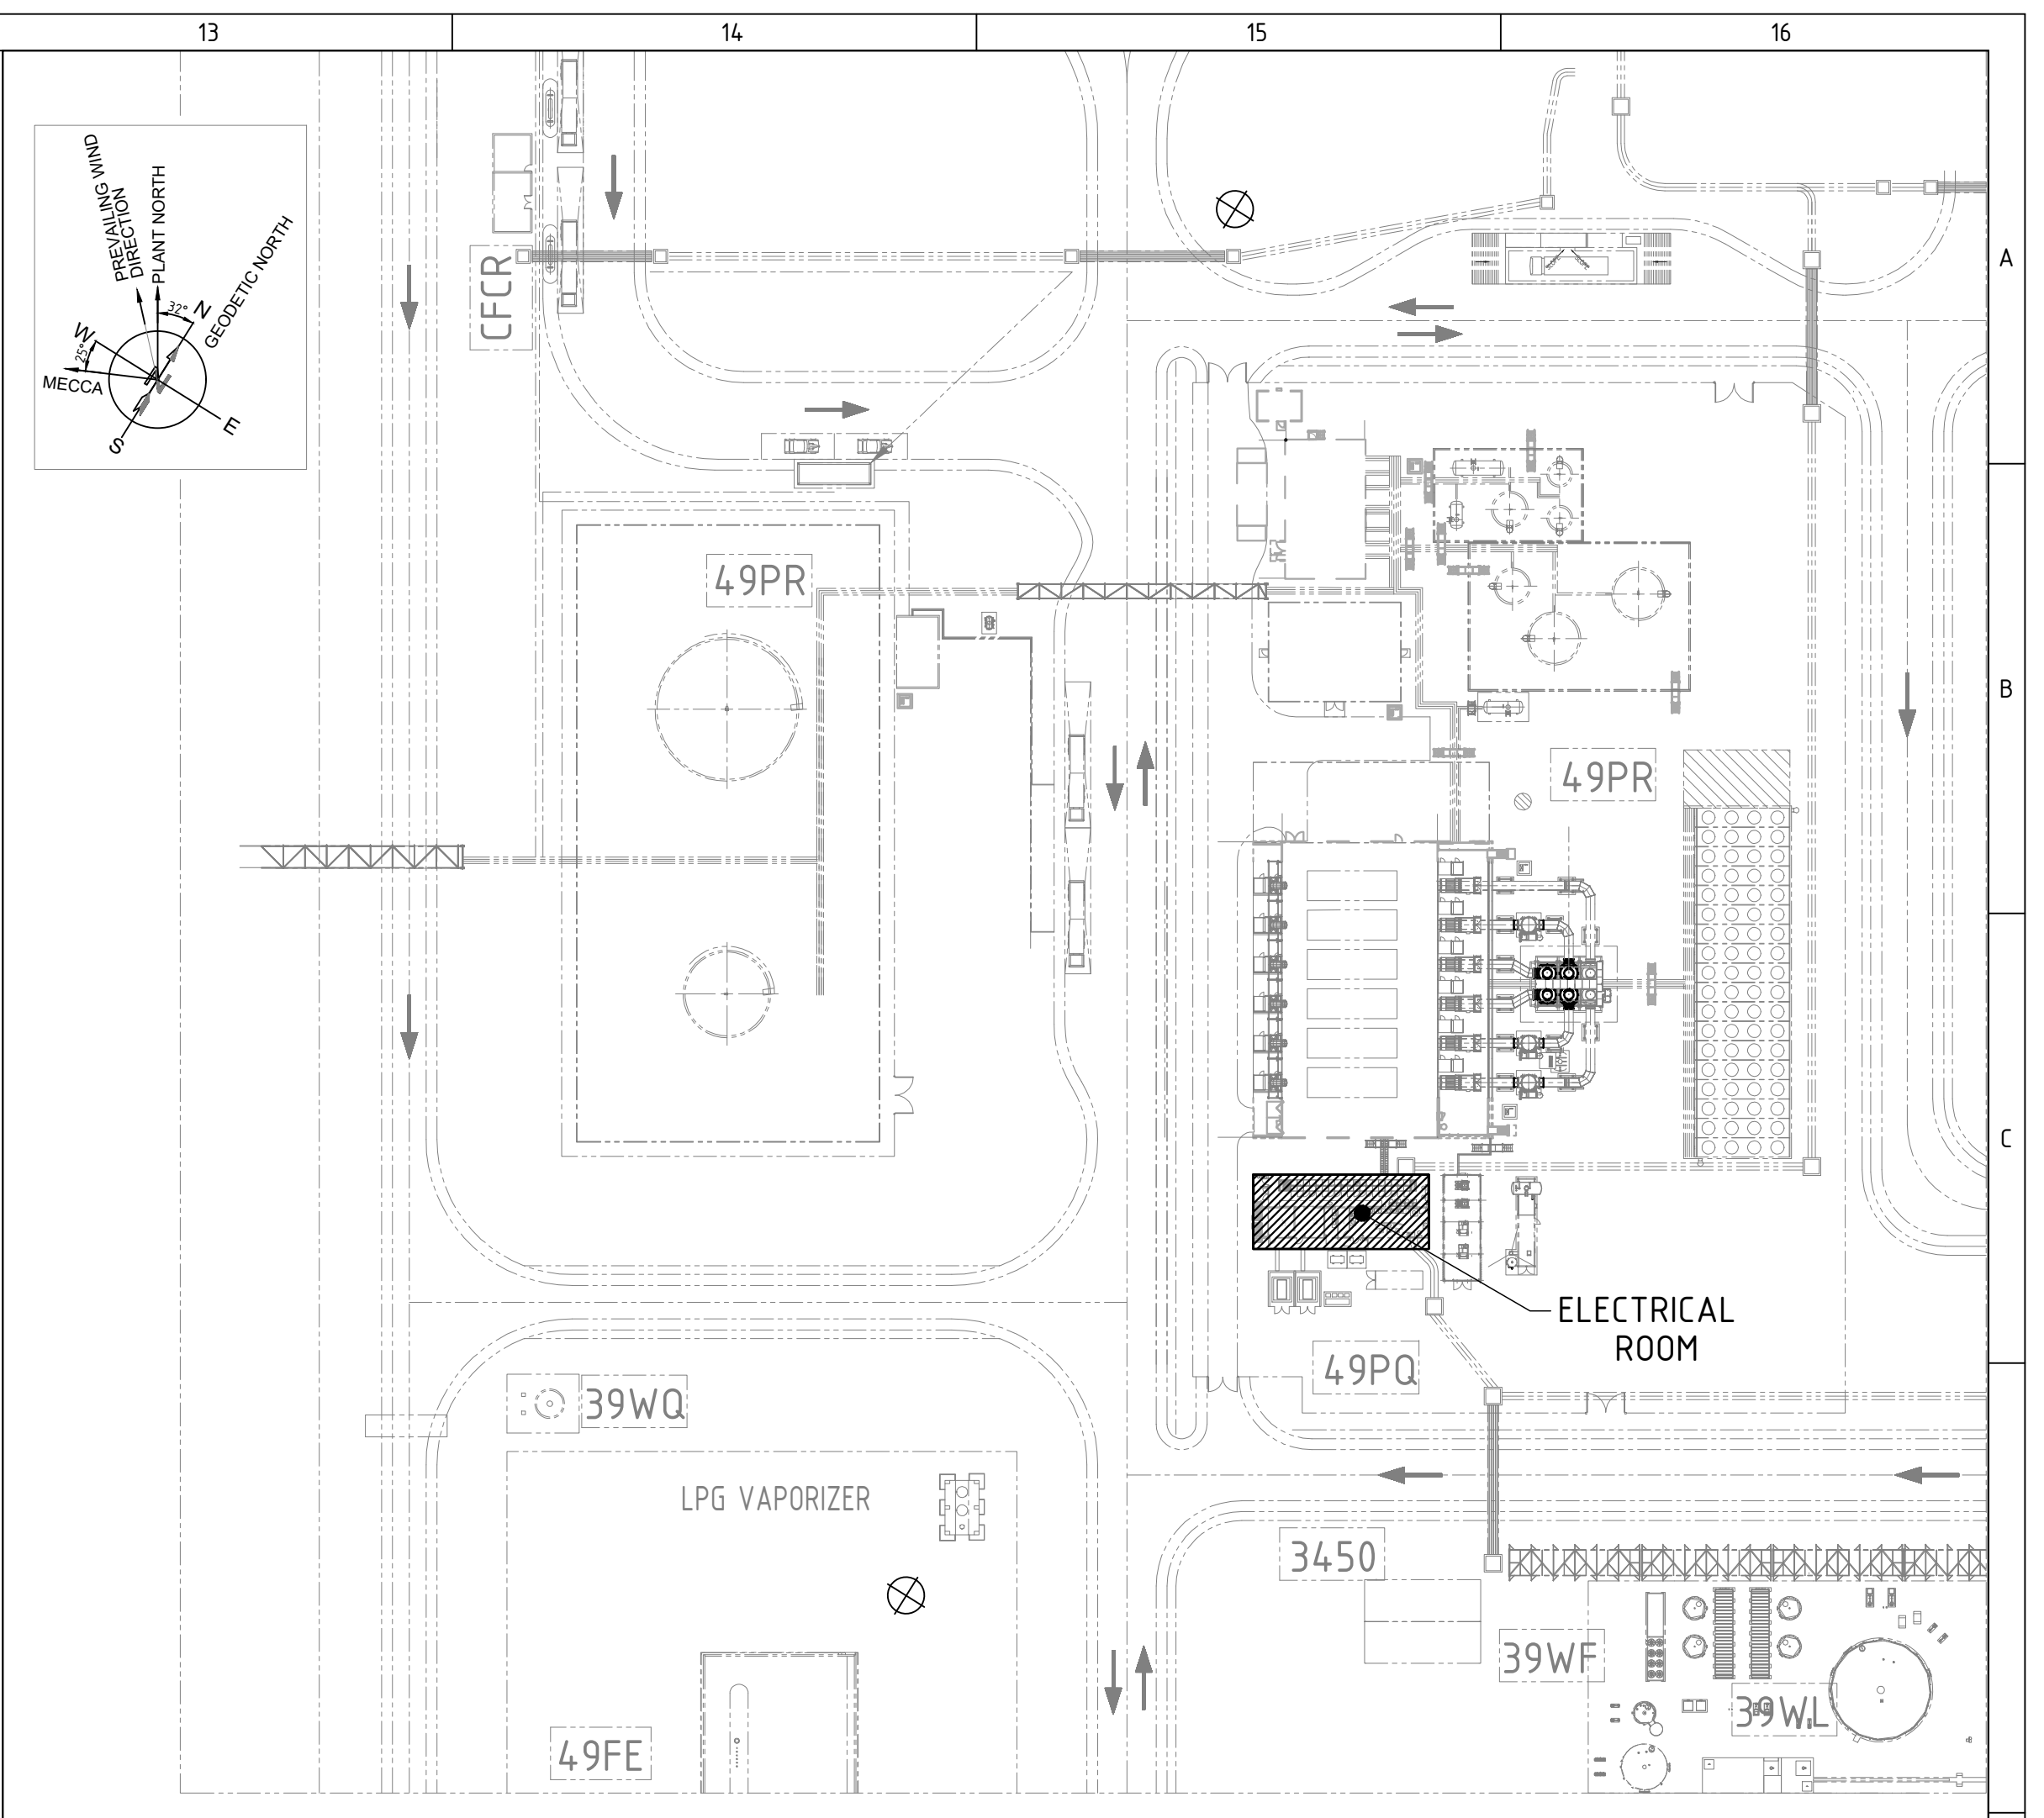

KEY PLAN
(SCALE 1:1000)

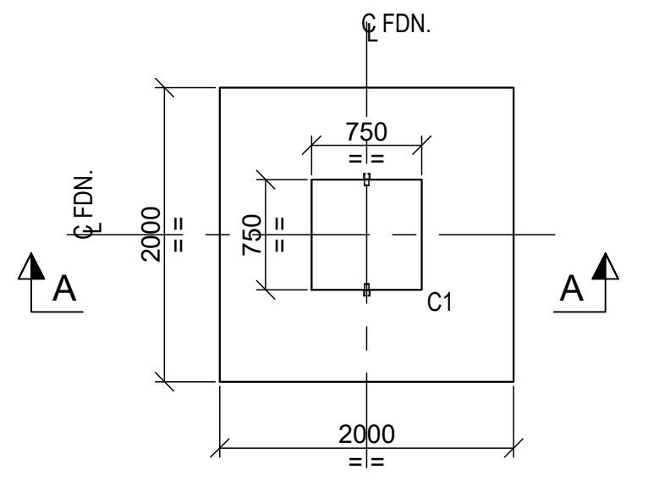

DET. OF FOUNDATION
MKD. F1
(21 NOS. REQUIRED)
SCALE 1:50

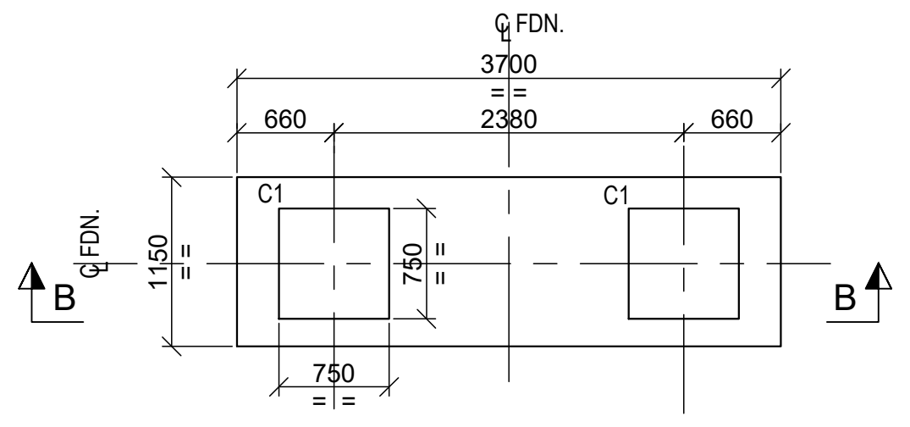

DET. OF FOUNDATION
MKD. F2
(1 NO. REQUIRED)
SCALE 1:50

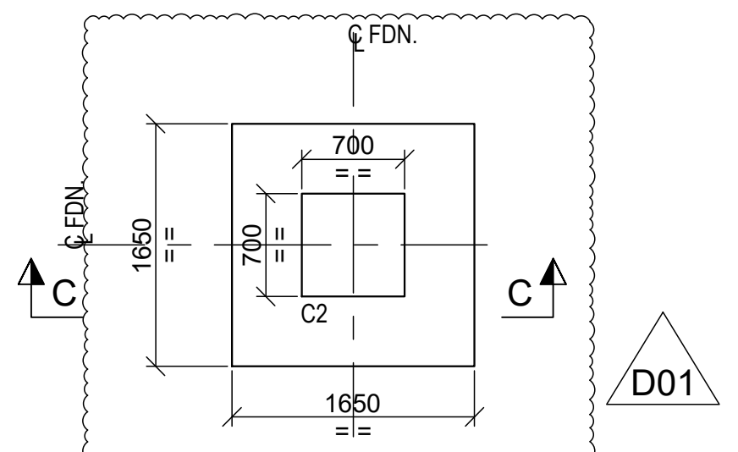

DET. OF FOUNDATION
MKD. F3
(2 NOS. REQUIRED)
SCALE 1:50

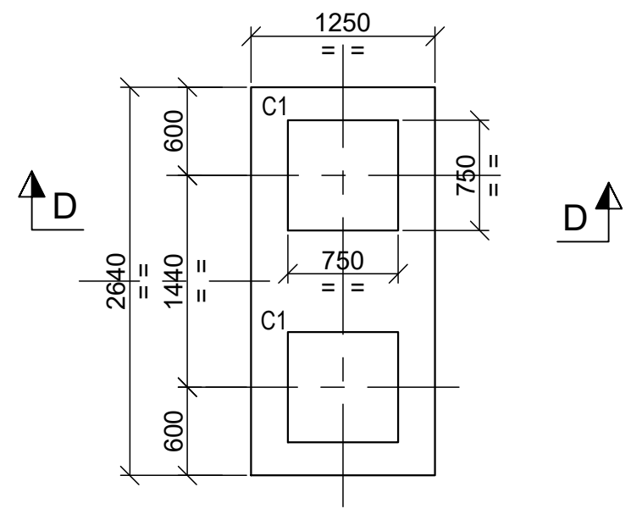

DET. OF FOUNDATION
MKD. F2A
(1 NO. REQUIRED)
SCALE 1:50

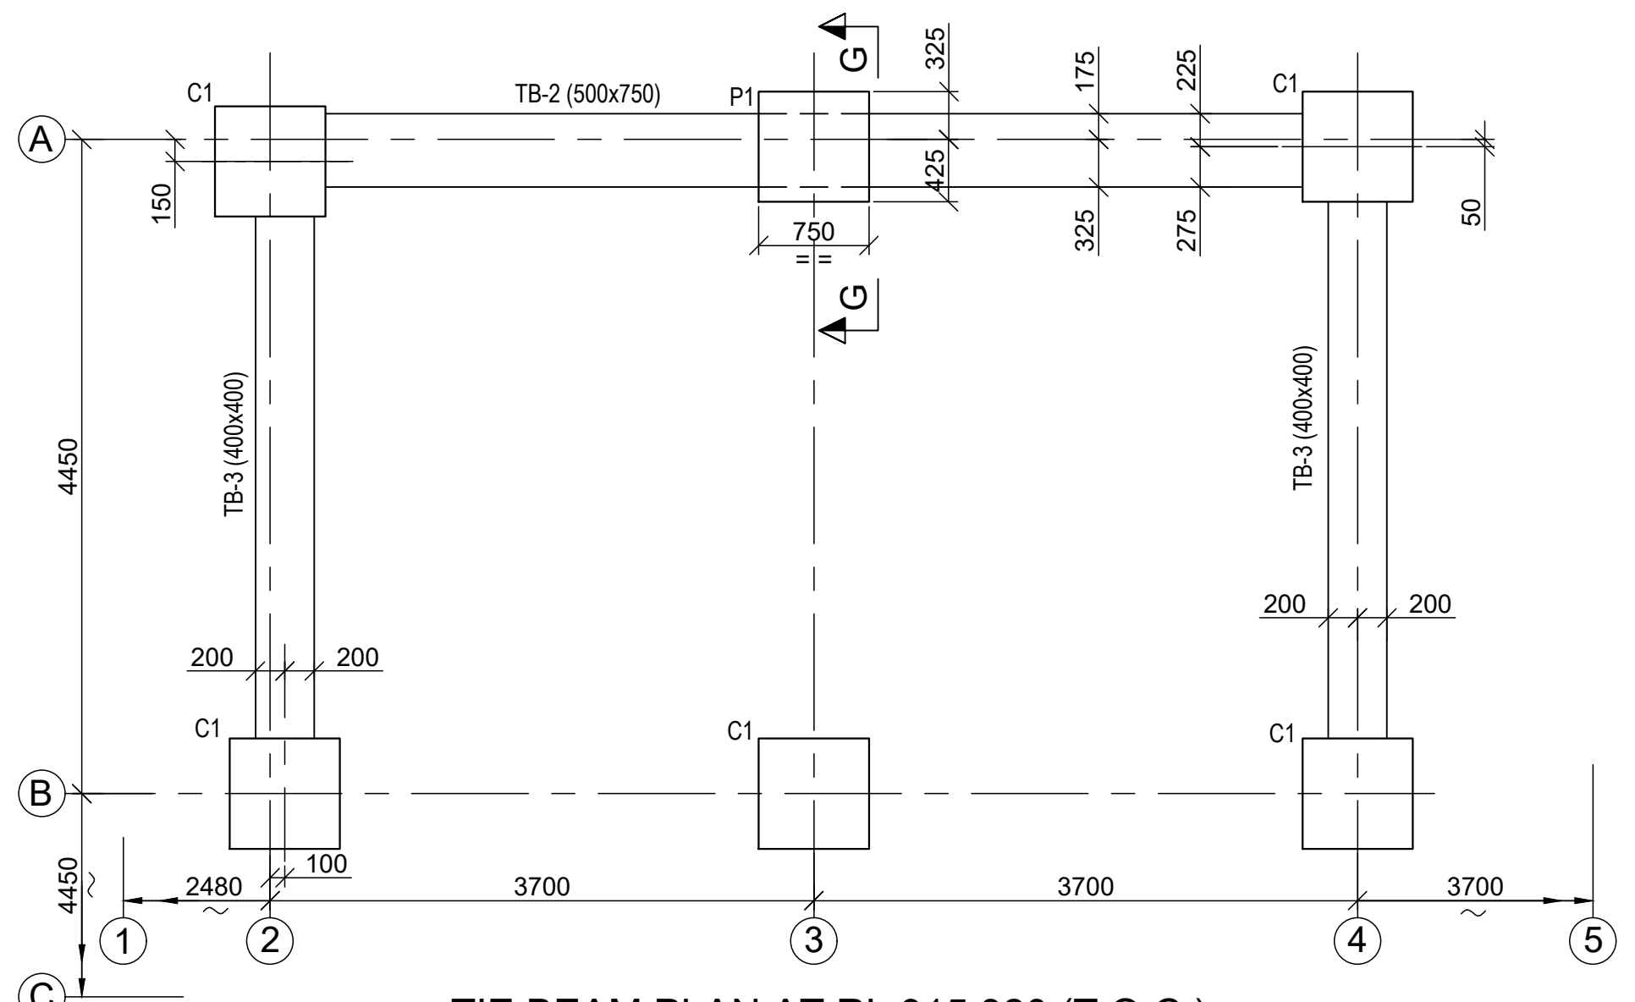

TIE BEAM PLAN AT RL.915.320 (T.O.C.)
(SCALE 1:50)

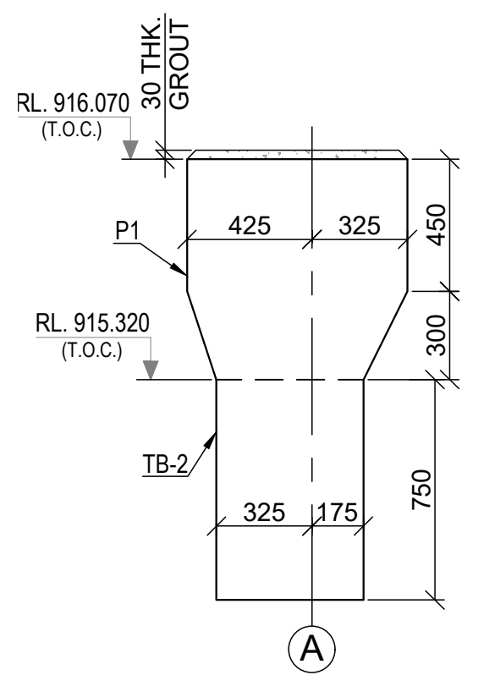

SECTION : G - G
(SCALE - 1 : 25)

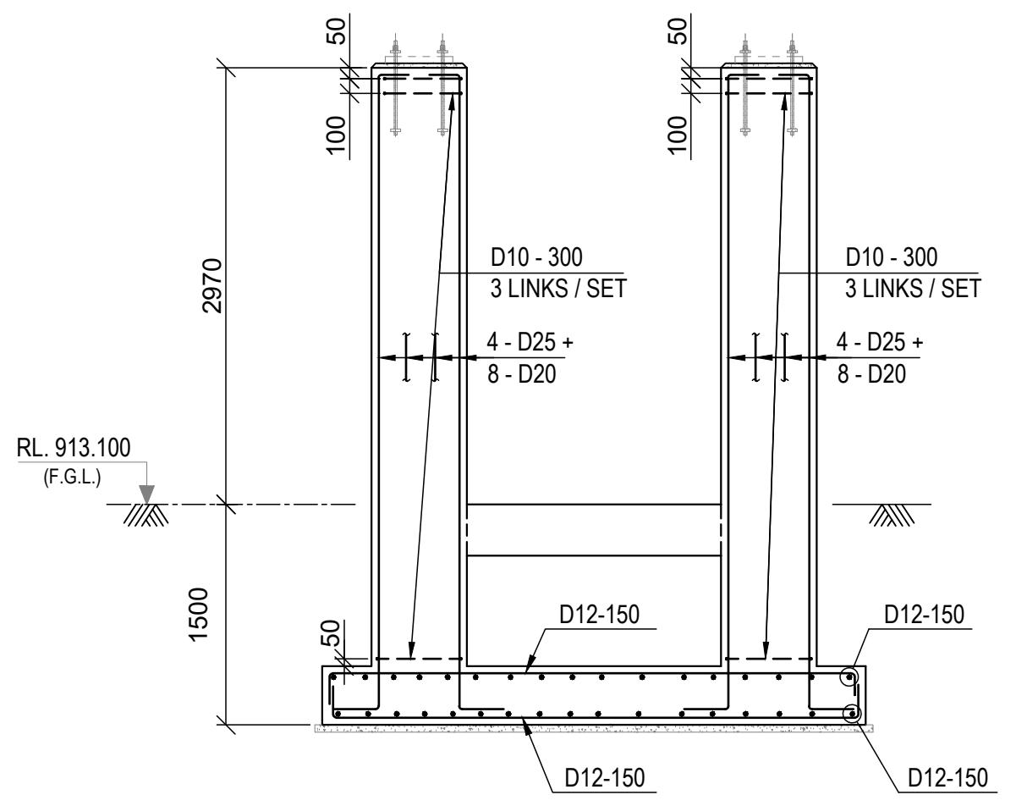

SECTION : B1-B1
SCALE 1:50

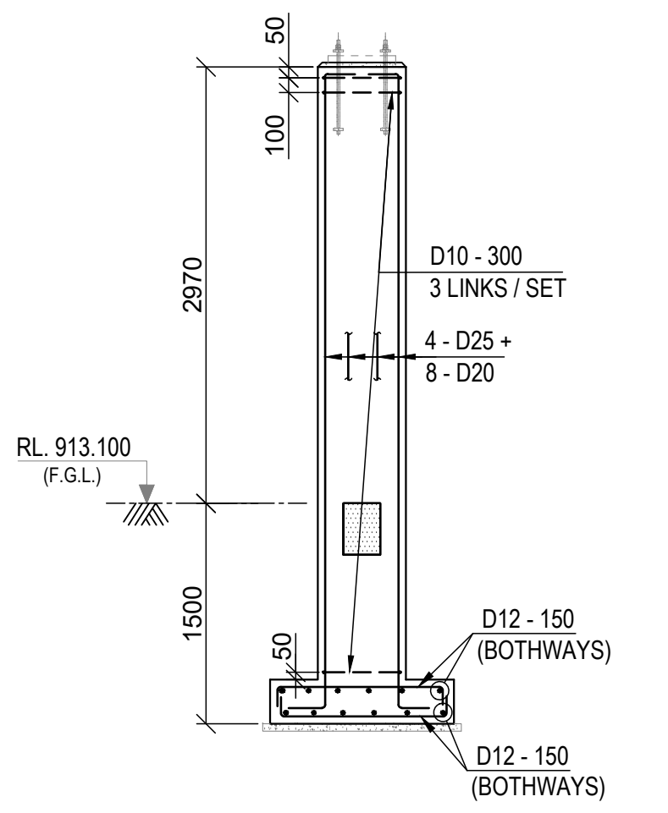

SECTION : D1-D1
SCALE 1:50

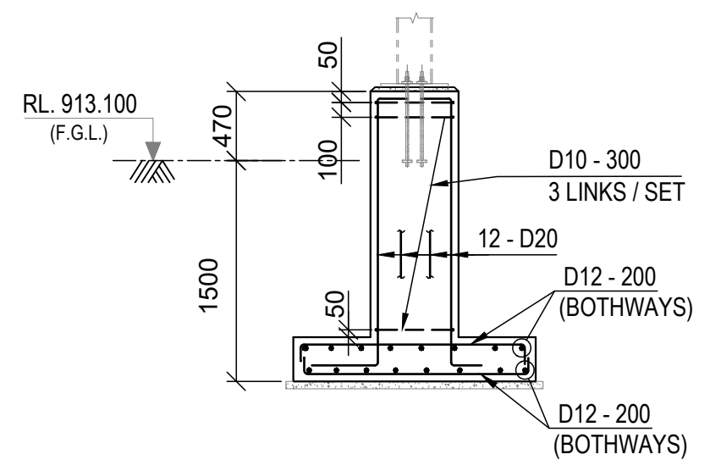

SECTION : C1-C1
SCALE 1:50

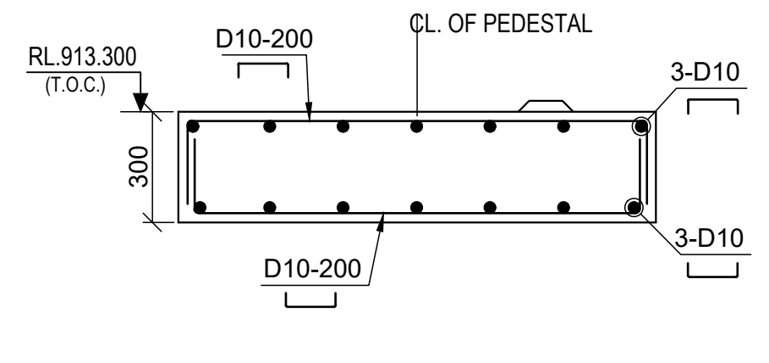

SECTION : F1 - F1
(SCALE - 1 : 20)

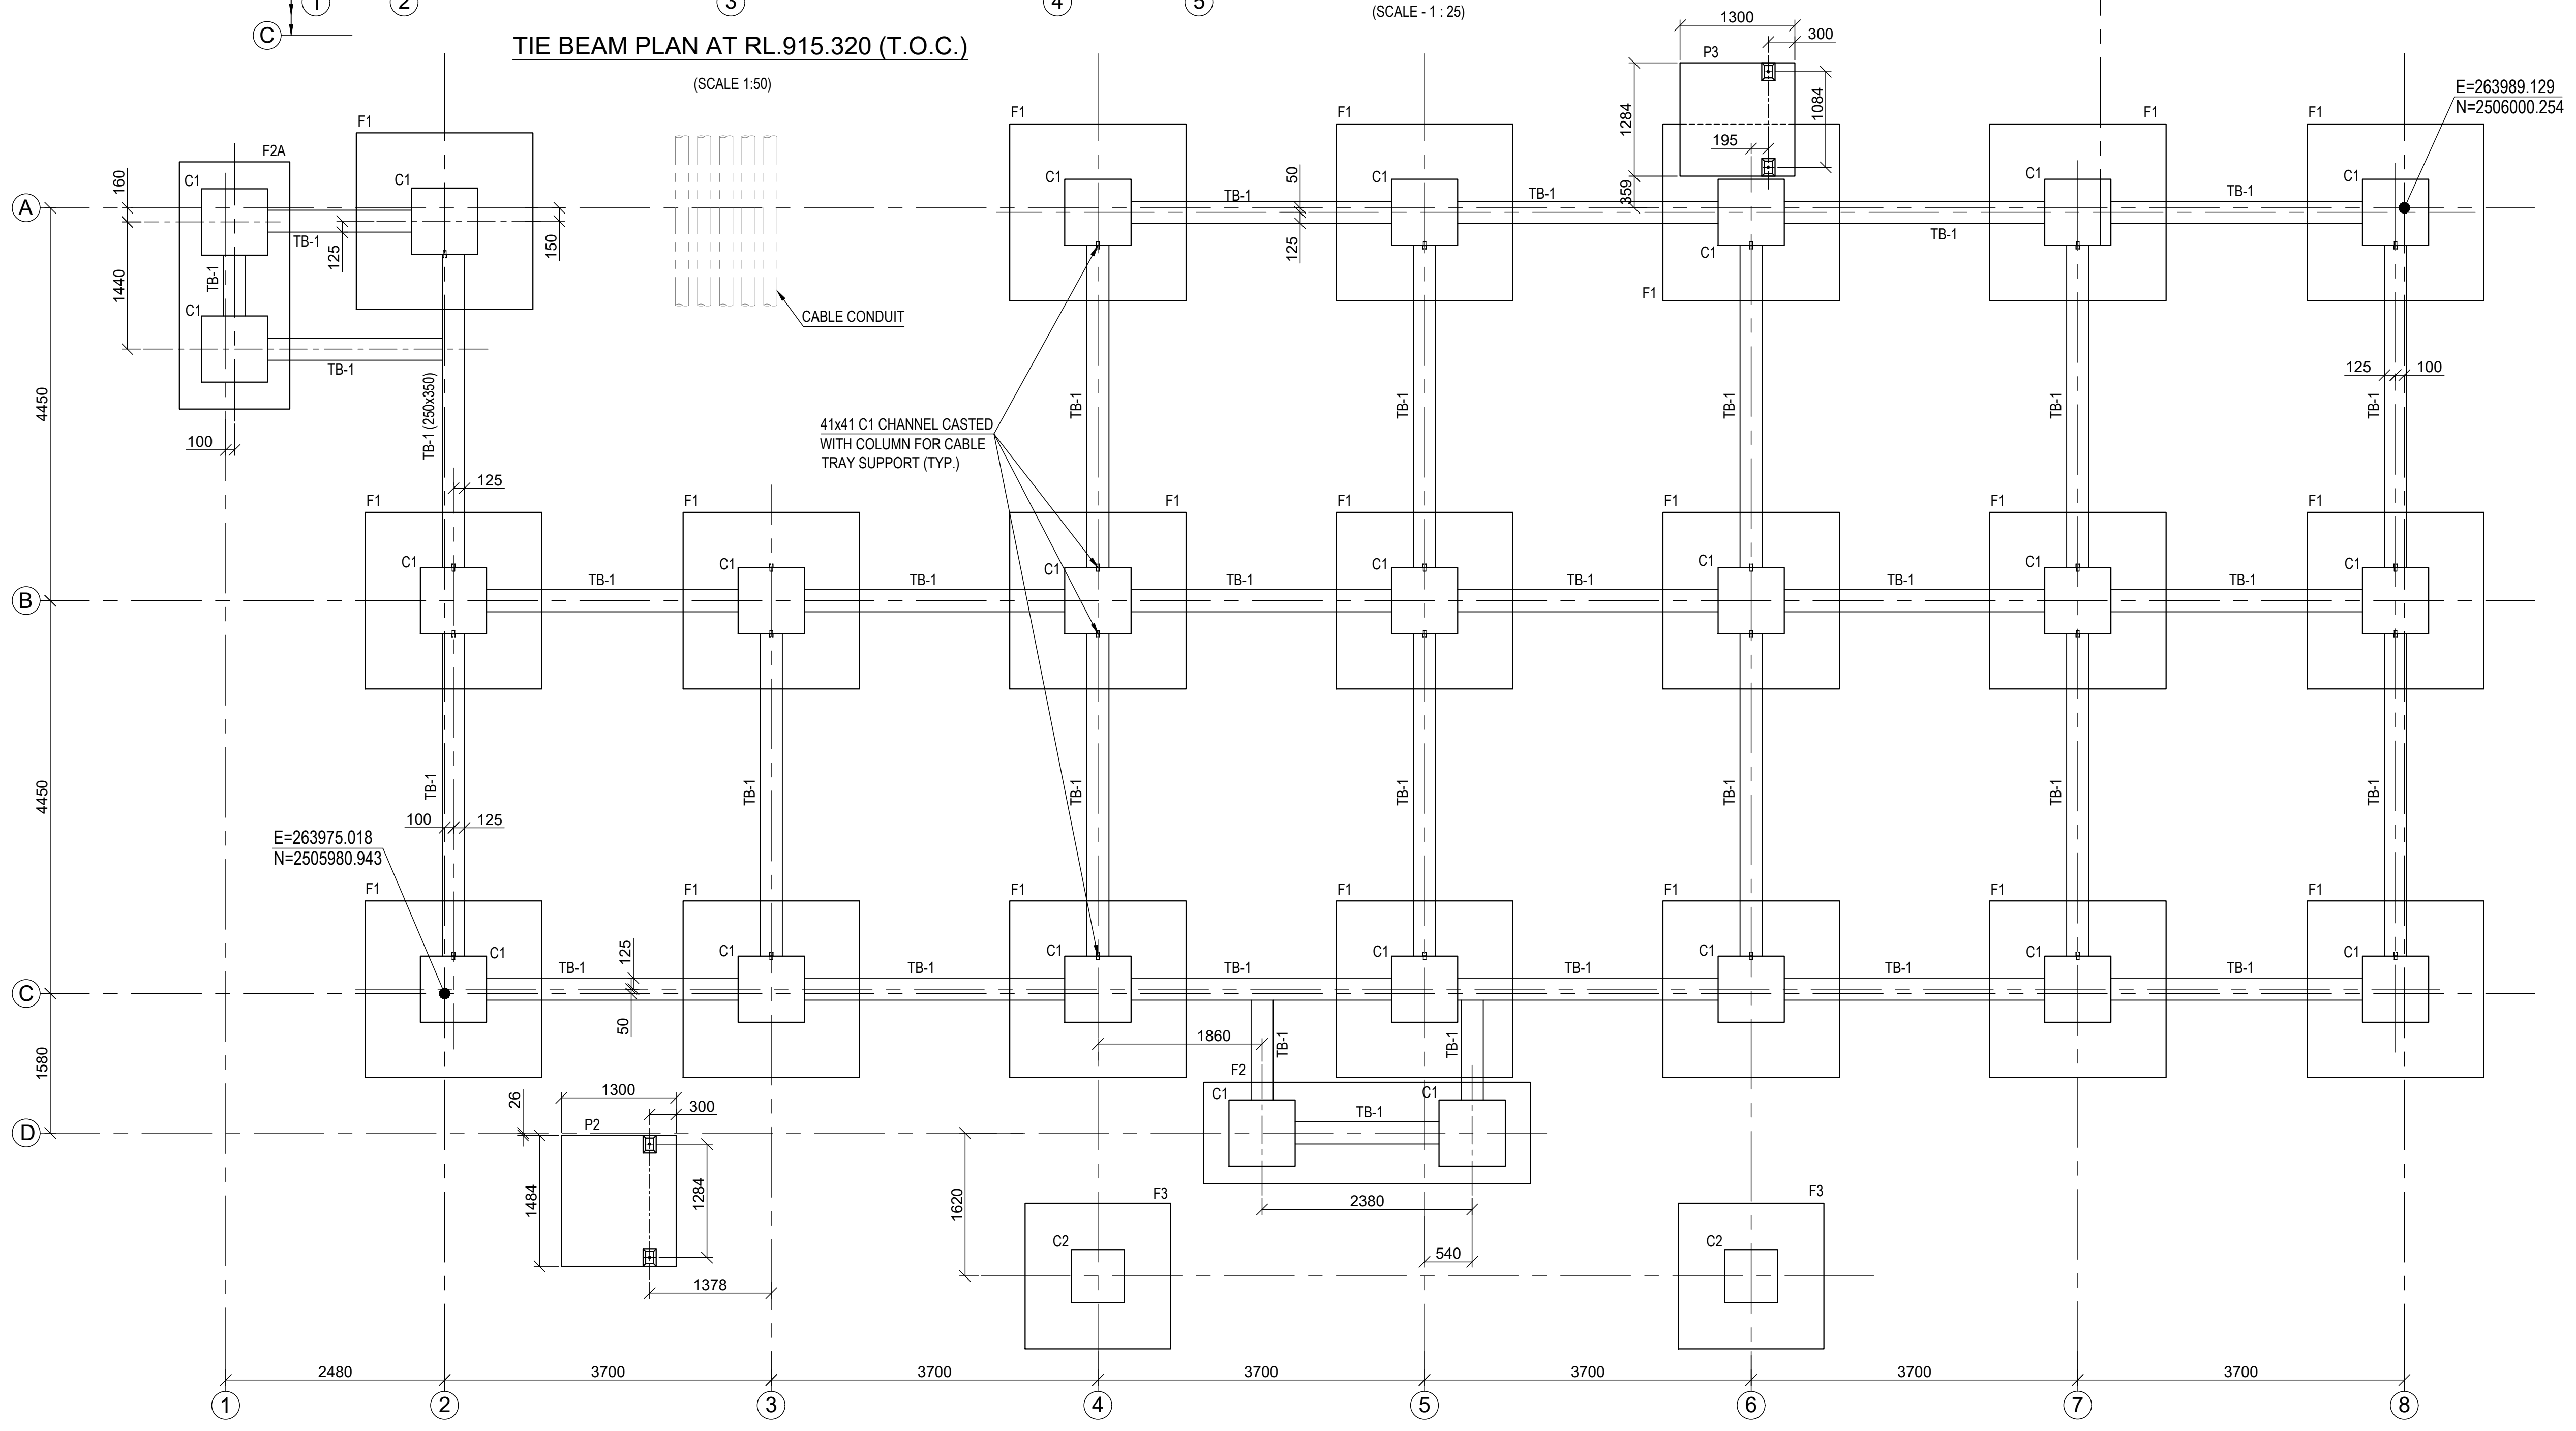

FOUNDATION LAYOUT FOR SUBSTATION
(SCALE 1:50)

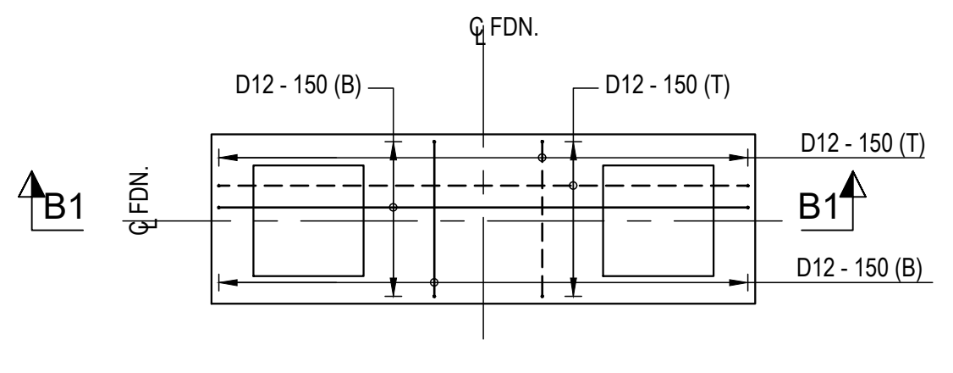

RC. DET. OF FOUNDATION
MKD. F2
SCALE 1:50

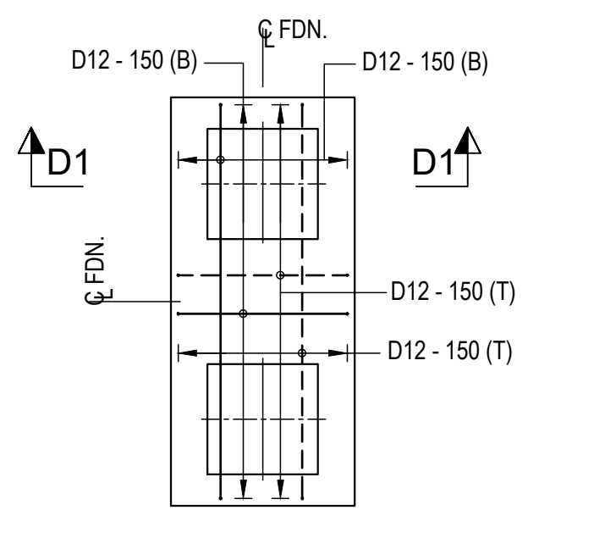

RC. DET. OF FOUNDATION
MKD. F2A
SCALE 1:50

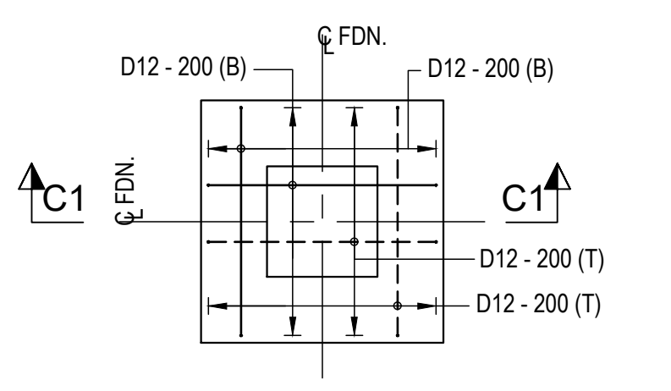

RC. DET. OF FOUNDATION
MKD. F3
SCALE 1:50

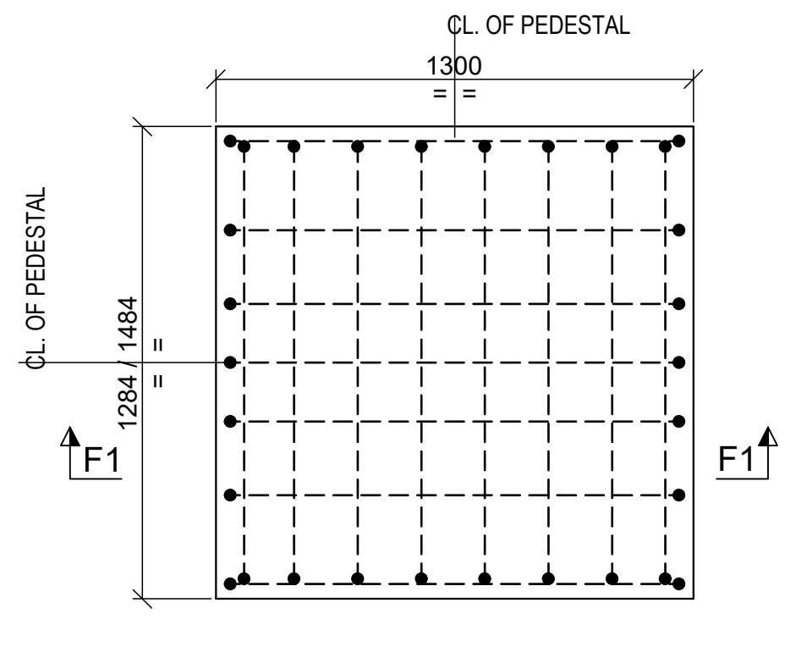

R.C. DETAIL OF PEDESTAL
MKD. P2 & P3
(SCALE - 1:20)

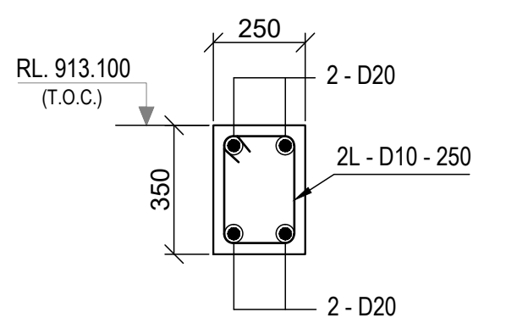

RC. DET. OF TB-1
SCALE 1:20

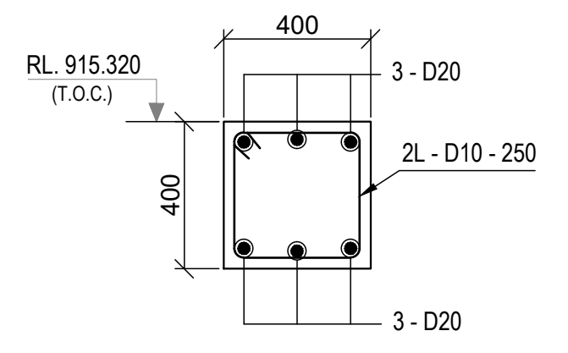

RC. DET. OF TB-3
SCALE 1:20

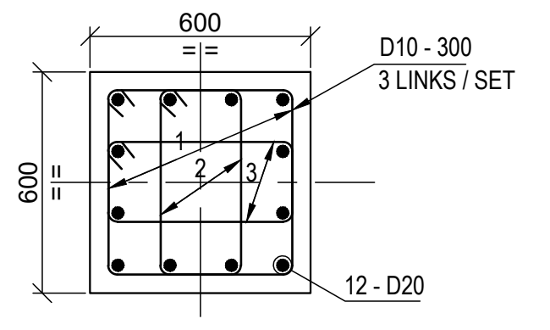

RC. DET. OF COLUMN
MKD. C2
SCALE 1:20

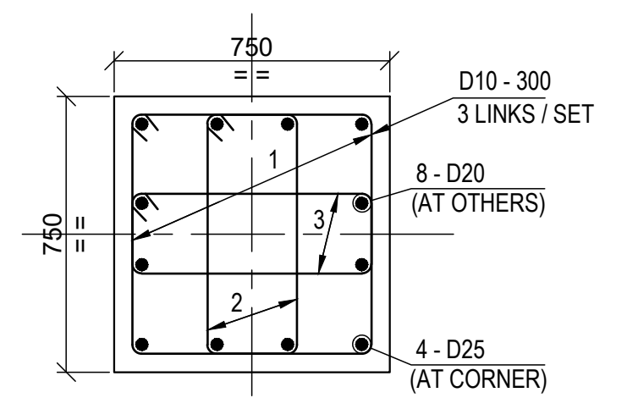

SECTION : A2 - A2 (FOR COLUMN MKD. C1)
SECTION : G1 - G1 (FOR PEDESTAL MKD. P1)
SCALE 1:20

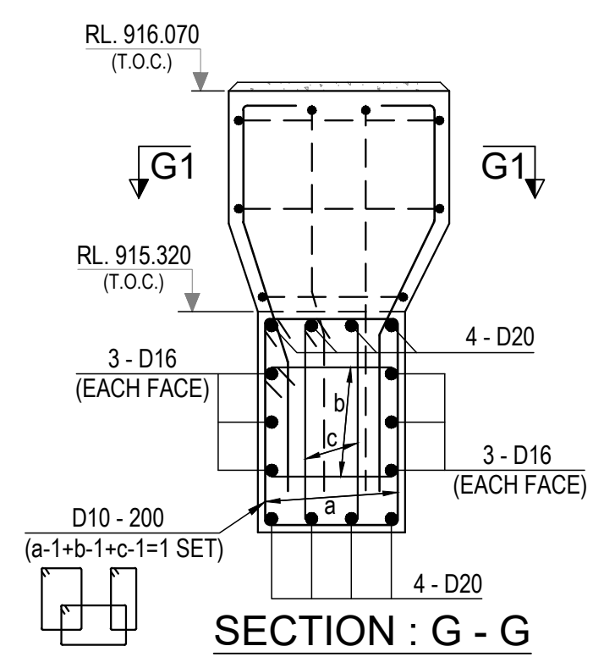

SECTION : G - G
(SHOWING R.C. DETAIL)
(SCALE - 1 : 25)

LEGENDS :-

R.L. - REDUCED LEVEL
℄ - CENTRE LINE
T.O.C. - TOP OF CONCRETE
T.O.G. - TOP OF GROUT
TYP. - TYPICAL
F.G.L. - FINISHED GROUND LEVEL
F.F.L. - FINISHED FLOOR LEVEL
B.O.F. - BOTTOM OF FOUNDATION
MKD. - MARKED
THK. - THICK
BOTTOM REINFORCEMENT (B) - ———
TOP REINFORCEMENT (T) - – – – – –
R.C. - REINFORCED CONCRETE
P.C.C - PLAIN CEMENT CONCRETE
FDN. - FOUNDATION
DET. - DETAIL
COL. - COLUMN
DIA. - DIAMETER

NOTES :-

1. ALL DIMENSIONS ARE IN MILLIMETRES AND LEVELS AND CO-ORDINATES ARE IN METRES. UNLESS OTHERWISE STATED.
2. GRADE OF CONCRETE SHALL BE 35 MPa FOR FOUNDATION & 15 MPa FOR BLINDING CONCRETE.
3. GRADE OF REINFORCEMENT SHALL BE DEFORMED BAR 420 MPa (GRADE 60) - ASTM A615/A615M.
4. NET SAFE BEARING CAPACITY OF SOIL AT BOTTOM OF FOUNDATION CONSIDER 450KN/ SQ. M.
5. CLEAR COVER TO MAIN REINFORCEMENT SHALL BE FOUNDATIONS = 50 MM., COLUMNS = 50 MM.
6. IF ANY PART OF FOUNDATION COMES ON BACKFILL ZONE OF ADJACENT FOUNDATION OR ANY LOOSE SOIL ARE ENCOUNTERED BELOW FOUNDATION LEVEL THE SAME SHALL BE REMOVED AND FILLED WITH PCC.
7. GENERAL NOTES FOR CIVIL WORKS & STANDARD REINFORCEMENT DETAIL REFER DRAWING NO. MD-216-1000-EG-CV-DED-1001 & 1005.

DOCUMENT NUMBER	REFERENCE DOCUMENTS	REV	DATE	REVISION DESCRIPTION	DRN	CHK	ENG	APP	EMP
		D01	17/02/2023	AS-BUILT & REVISED AS MKD. D01	PDK	SGC	SHD	PRI	
		C04	19/01/2021	ISSUED FOR CONSTRUCTION & REVISED AS MKD. C04	PDK	SGC	SHD	PRI	
		C03	22/12/2020	ISSUED FOR CONSTRUCTION & REVISED AS MKD. C03	AMJ	SGC	SHD	PRI	
ASL-RS-DWG-ST-20K052-000105	POWER DISTRIBUTION PROCESS PLANT POWER PLANT SUBSTATION	C02	26/11/2020	ISSUED FOR CONSTRUCTION & REVISED AS MKD. C02	PDK	SGC	SHD	PRI	
MD-216-1000-EG-ST-CRT-1001	CIVIL, STRUCTURAL & ARCHITECTURAL - DESIGN CRITERIA	C01	05/11/2020	ISSUED FOR CONSTRUCTION & REVISED AS MKD. C01	PDK	SGC	SHD	PRI	
MD-216-49PR-EG-ME-LAD-V553-1002	LAYOUT OF POWER GENERATION	A01	15/10/2020	ISSUED FOR REFERENCE	AMJ	SGC	SHD	PRI	

DOCUMENT NUMBER	REFERENCE DOCUMENTS	REV	DATE	REVISION DESCRIPTION	DRN	CHK	ENG	APP	EMP

RESERVED FOR VENDOR LOGO AND DRAWING NUMBER

LARSEN & TOUBRO

This drawing is the property of LARSEN & TOUBRO and must not be passed on to any person or body not authorized by us to receive it nor be copied or otherwise made use either in full or in part by such person or body without our prior permission in writing.

Outotec

The content of these documents are the sole property of Outotec Oyj. Any rights not expressly granted herein are reserved. Reproduction, transfer or distribution of part or all of the contents in any form without prior written permission of Outotec is prohibited.

MA'ADEN معادن
Saudi Arabian Mining Company شركة التعدين العربية السعودية

This document and the information contained herein is Ma'aden proprietary know-how. This document or any part thereof should not be reproduced, stored in a retrieval system or transmitted by any means, electronic or otherwise, or divulged without prior written permission of Ma'aden.

LARSEN & TOUBRO DRAWING NUMBER: 019045_008_C_G_24292_006 — REVISION 5
OUTOTEC DRAWING NUMBER: 900707 _ GAU01 _ WG01 _ MTL01 _ 45082 — DOCUMENT ID: OU100688140 — REVISION 5

DRAWN	AMJ	10/10/2020
CHECKED	SGC	12/10/2020
ENGINEER	SHD	01/10/2020
APPROVED	PRI	15/10/2020
EMPLOYER		
SCALE	1:200,100,20	A0

MANSOURAH - MASSARAH GOLD PROJECT
GENERAL ARRANGEMENT
POWER PLANT SUBSTATION
GA AND DETAIL OF FOUNDATION

DRAWING NUMBER: MD - 216 - 49PR - EG - CV - GAD - 2011
REV: D01