

DRAWING NUMBER: MD-216-49PR-EG-CV-GAD-2015 | REV: D01

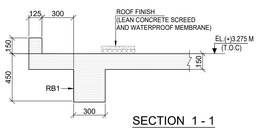


SECTION 1 - 1
(SCALE 1:20)

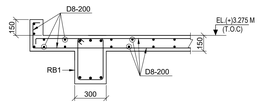


SECTION 1 - 1
(SHOWING RC DETAIL)
(SCALE 1:20)

RCC SCHEDULE OF BEAM


BEAM MKD.	SIZE	CROSS SECTION	TOP OF BEAM (T.O.B)
GB1	300 x 450	3-D16; 450; 2L-D10-200; 3-D16; 300	EL.(-) 0.050 M
LB1	250 x 250	3-D12; 250; 2L-D10-200; 3-D12; 250	EL.(+) 2.350 M
RB1	300 x 450	D8 - 200; 150; 3-D16; 450; 2L-D10-200; 3-D16; 300	EL.(+) 3.275 M
RB2	300 x 450	3-D16; 450; 2L-D10-200; 3-D16; 300	EL.(+) 3.275 M

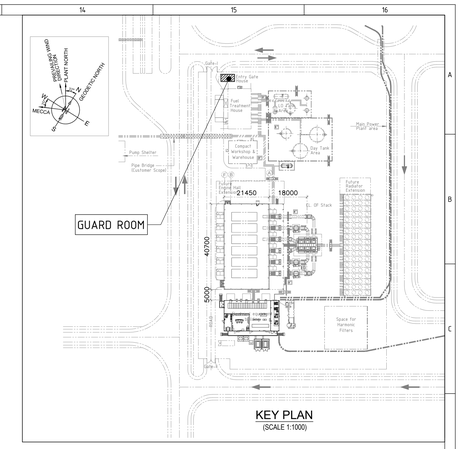


KEY PLAN
(SCALE 1:1000)

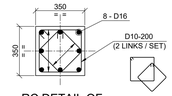


RC DETAIL OF
COLUMN MKD. C1
(6 NOS. REQUIRED)
(SCALE- 1:15)

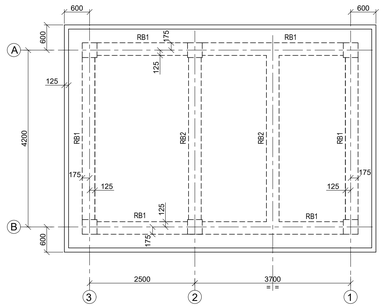


PLAN AT EL. (+) 3.275 M (T.O.C)
(SCALE 1:50)

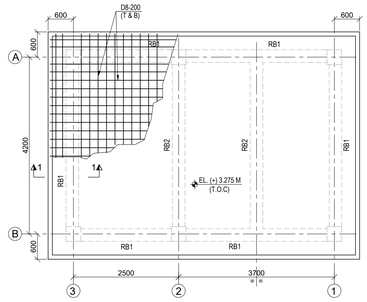


PLAN AT EL. (+) 3.275 M (T.O.C)
(SCALE 1:50)

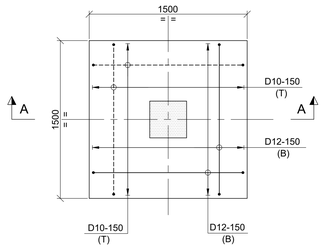


R.C. DETAIL OF FOUNDATION MKD. F1
(F1 - 6 NOS. REQUIRED)
(SCALE- 1:25)

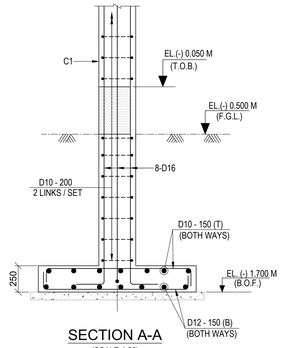


SECTION A-A
(SCALE-1:25)

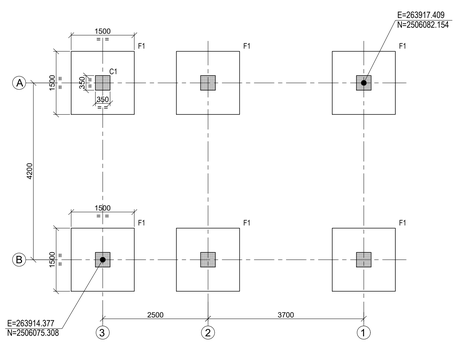

FOUNDATION LAYOUT PLAN FOR GUARD ROOM
(SCALE 1:50)

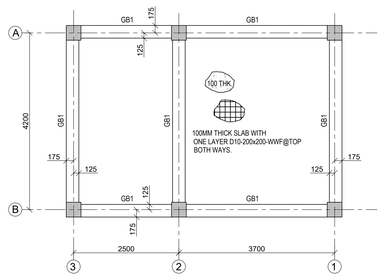

PLAN OF GRADE BEAM AT EL. (-) 0.050 M (T.O.B)
(SCALE 1:50)

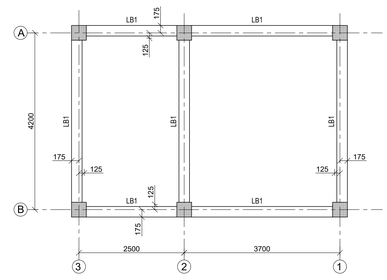

PLAN OF LINTLE BEAM AT EL. (+) 2.100 M (B.O.B)
(SCALE 1:50)

LEGEND :-

RL - REDUCED LEVEL.
T.O.C. - TOP OF CONCRETE.
F.G.L. - FINISHED GROUND LEVEL.
B.O.F. - BOTTOM OF FOOTING.
B.O.B. - BOTTOM OF BEAM.
HCS - HOLLOW CORE SLAB
SSL - STRUCTURAL SLAB LEVEL
CL - CENTRE LINE.
TYP. - TYPICAL.
THK. - THICK.
MKD. - MARKED.
G.A. - GENERAL ARRANGEMENT.
WWF - WELDED WIRE FABRIC.
U.N.O. - UNLESS NOTED OTHERWISE

NOTES :-

1. ALL DIMENSIONS ARE IN MILLIMETERS AND LEVELS AND CO-ORDINATES ARE IN METERS. UNLESS OTHERWISE STATED.
2. FGL CORRESPONDS TO RL. (+) 913.100 M LEVEL.
3. GRADE OF CONCRETE SHALL BE 35 MPa FOR FOUNDATION & 15 MPa FOR BLINDING CONCRETE.
4. GRADE OF REINFORCEMENT SHALL BE DEFORMED BAR 420 MPa (GRADE 60) - ASTM A615/A615M.
5. NET SAFE BEARING CAPACITY OF SOIL AT BOTTOM OF FOUNDATION CONSIDER 500KN/ SQ. M.
6. CLEAR COVER TO MAIN REINFORCEMENT SHALL BE
   a) FOUNDATION = 75 mm (BOTTOM & SIDE) 50 mm. (TOP)
   b) COLUMN & PEDESTAL = 50mm
   c) BEAM = 50mm
   d) SLAB = 20mm
7. IF ANY PART OF FOUNDATION COMES ON BACKFILL ZONE OF ADJACENT FOUNDATION OR ANY LOOSE SOIL ARE ENCOUNTERED BELOW FOUNDATION LEVEL THE SAME SHALL BE REMOVED AND FILLED WITH PCC.
8. ALL OTHER NOTES REFER DRAWING NO. MD-101-SMEM-EG-ST-DST-0001 TO 0008.
9. GENERAL NOTES FOR CIVIL WORKS & STANDARD REINFORCEMENT DETAIL REFER DRAWING NO. MD-216-1000-EG-CV-DED-1001 & 1005.
10. FOR ANCHOR BOLTS STANDARD DETAILS REFER DRAWING NO. MD-216-1000-EG-CV-DED-1003

DOCUMENT NUMBER	REFERENCE DOCUMENTS	REV	DATE	REVISION DESCRIPTION	DRN	CHK	ENG	APP	EMP
		D01	17/02/2023	AS-BUILT	AMJ	SGC	SHD	PRI	
MD-216-49PR-EG-AR-GAD-3183	POWER GENERATION - GUARD ROOM PLAN, ELEVATION, SECTIONS & DETAILS	C02	04/06/2021	ISSUED FOR CONSTRUCTION & REVISED AS MKD	AMJ	SGC	SHD	PRI	
MD-216-1000-EG-ST-CRT-1001	CIVIL, STRUCTURAL & ARCHITECTURAL - DESIGN CRITERIA	C01	01/08/2020	ISSUED FOR CONSTRUCTION	AMJ	SGC	SHD	PRI	
MD-216-49PR-EG-ME-LAD-V553-1002	LAYOUT OF POWER GENERATION	A01	03/07/2020	ISSUED FOR REFERENCE	AMJ	SGC	SHD	PRI	

RESERVED FOR VENDOR LOGO AND DRAWING NUMBER

LARSEN & TOUBRO

This drawing is the property of LARSEN & TOUBRO and must not be passed on to any person or body not authorized by us to receive it nor be copied or otherwise made use either in full or in part by such person or body without our prior permission in writing.

Outotec

The content of these documents are the sole property of Outotec Oyj. Any rights not expressly granted herein are reserved. Reproduction, transfer or distribution of part or all of the contents in any form without prior written permission of Outotec is prohibited.

MA'ADEN معادن
Saudi Arabian Mining Company شركة معادن العربية السعودية

This document and the information contained herein is Ma'aden proprietary know-how. This document or any part thereof should not be reproduced, stored in a retrieval system or transmitted by any means, electronic or otherwise, or divulged without prior written permission of Ma'aden.

LARSEN & TOUBRO DRAWING NUMBER	019045_008_C_G_24298_001		REVISION 3
OUTOTEC DRAWING NUMBER	900707__GAU01__WG01__MTL01__45087	DOCUMENT ID OU100690010	REVISION 3
DRAWN	AMJ	26/06/2020	MANSOURAH - MASSARAH GOLD PROJECT
CHECKED	SGC	02/07/2020	GENERAL ARRANGEMENT
ENGINEER	SHD	23/06/2020	POWER PLANT GUARD ROOM
APPROVED	PRI	03/07/2020	GA AND DETAIL
EMPLOYER			
SCALE	1:200,100,20	A0	DRAWING NUMBER: MD - 216 - 49PR - EG - CV - GAD - 2015 REV: D01