


DRAWING NUMBER MD - 216 - 49PR- EG - CV - GAD - 2017 | REV D01

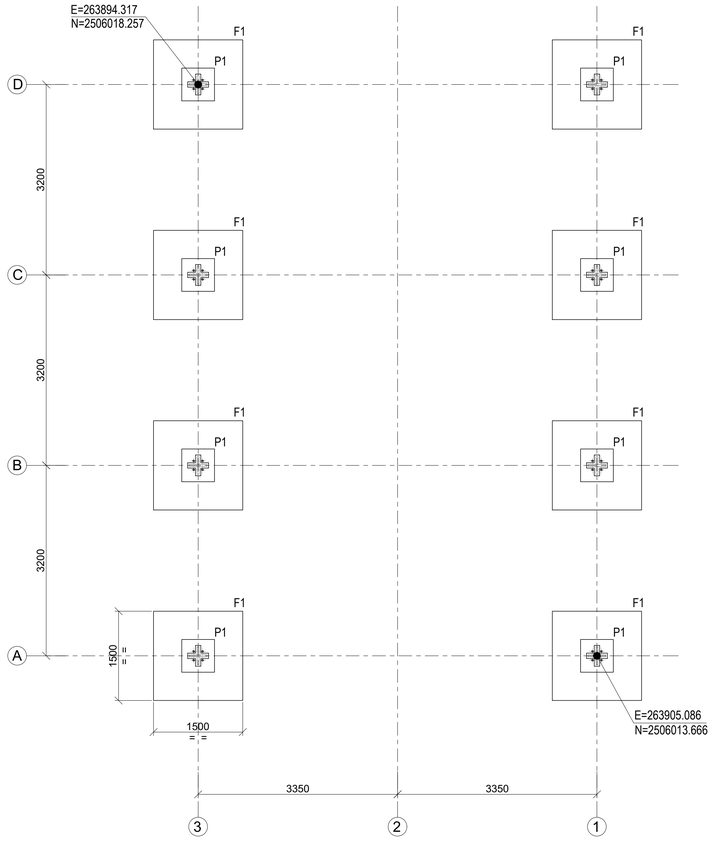


LAYOUT OF FOUNDATION
(SCALE 1:50)

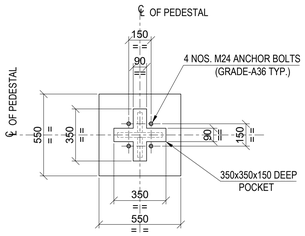


VIEW B - B
(TYP. DETAIL OF PEDESTAL MKD. P1)
(SCALE- 1:20)

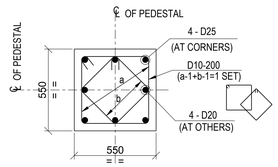


RC DETAIL OF PEDESTAL MKD. P1
(SCALE- 1:20)

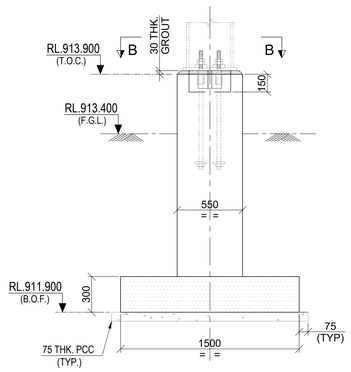


SECTION A-A
(SCALE - 1:25)

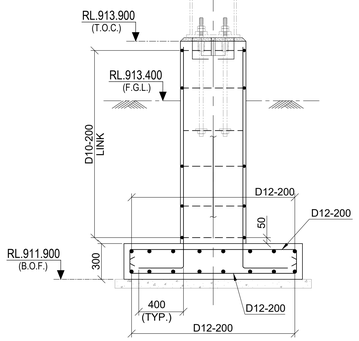


SECTION 1-1
(SCALE - 1:25)

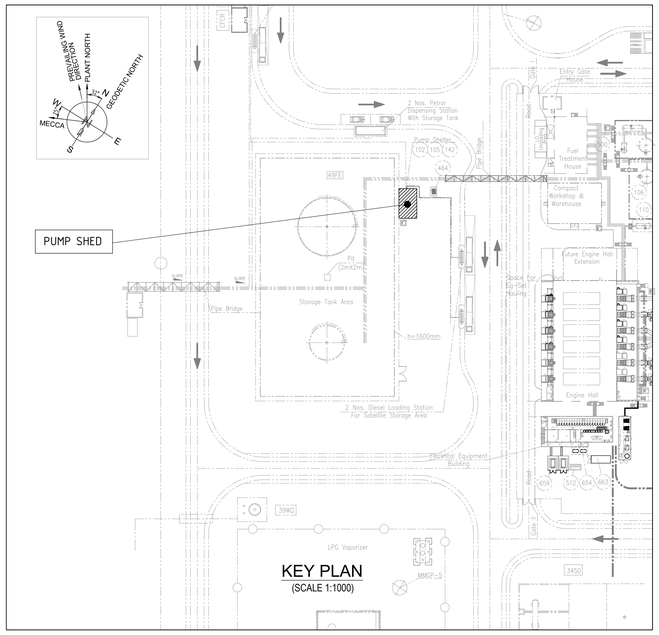

SCHEDULE OF BOLTS	
BOLT (MM)	BOLT NUMBERS REQUIRED
M24	32

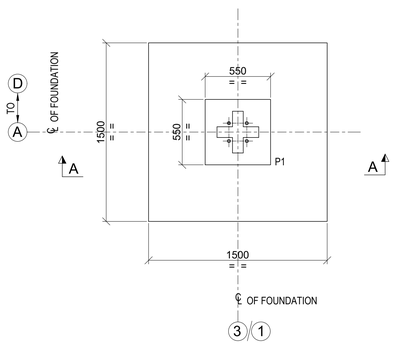

DETAIL OF FOUNDATION MKD. F1
(SCALE - 1:25)

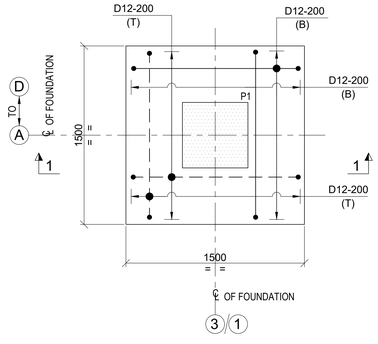

R.C. DETAIL OF FOUNDATION MKD. F1
(8 NOS. REQUIRED)
(SCALE - 1:25)

LEGEND :-

RL. - REDUCED LEVEL.
T.O.C. - TOP OF CONCRETE.
F.G.L. - FINISHED GROUND LEVEL.
B.O.F. - BOTTOM OF FOOTING.
℄ - CENTRE LINE
TYP. - TYPICAL.
THK. - THICK.
MKD. - MARKED.
G.A. - GENERAL ARRANGEMENT.
DIA - DIAMETER.
B - BOTTOM REINFORCEMENT ————
T - TOP REINFORCEMENT – – – – –
R.C. - REINFORCED CONCRETE

NOTES :-

1. ALL DIMENSIONS ARE IN MILLIMETRES AND LEVELS AND CO-ORDINATES ARE IN METRES. UNLESS OTHERWISE STATED.
2. GRADE OF CONCRETE SHALL BE 35 MPa FOR FOUNDATION & 15 MPa FOR BLINDING CONCRETE.
3. GRADE OF REINFORCEMENT SHALL BE DEFORMED BAR 420 MPa (GRADE 60) - ASTM A615/A615M.
4. NET SAFE BEARING CAPACITY OF SOIL AT BOTTOM OF FOUNDATION CONSIDER 500KN/ SQ. M.
5. CLEAR COVER TO MAIN REINFORCEMENT SHALL BE 75 mm FOR RAFT & 50 mm FOR COLUMN.
6. IF ANY PART OF FOUNDATION COMES ON BACKFILL ZONE OF ADJACENT FOUNDATION OR ANY LOOSE SOIL ARE ENCOUNTERED BELOW FOUNDATION LEVEL THE SAME SHALL BE REMOVED AND FILLED WITH PCC.
7. ALL OTHER NOTES REFER DRAWING NO. MD-101-SMEM-EG-ST-DST-0001 TO 0008.
8. GENERAL NOTES FOR CIVIL WORKS & STANDARD REINFORCEMENT DETAIL REFER DRAWING NO. MD-216-1000-EG-CV-DED-1001 & 1005.
9. FOR ANCHOR BOLTS STANDARD DETAILS. REFER DRAWING NO. MD-216-1000-EG-CV-DED-1003

DOCUMENT NUMBER	REFERENCE DOCUMENTS	REV	DATE	REVISION DESCRIPTION	DRN	CHK	ENG	APP	EMP
		D01	17/02/2023	AS-BUILT	AMJ	SGC	SHD	PRI	
MD-216-49PR-EG-ST-GAD-2424	PUMP SHED IN POWER PLANT PLAN, ELEVATIONS & DETAILS	C03	17/12/2020	ISSUED FOR CONSTRUCTION & REVISED AS MKD. C03	AMJ	SGC	SHD	PRI	
MD-216-49PR-EG-ME-GAD-V553-1064	POWER GENERATION PUMP SHELTER	C02	26/11/2020	ISSUED FOR CONSTRUCTION & REVISED AS MKD. C02	PDK	SGC	SHD	PRI	
MD-216-49PR-EG-ME-LAD-V553-1002	LAYOUT OF POWER GENERATION	C01	31/08/2020	ISSUED FOR CONSTRUCTION	AMJ	SGC	SHD	PRI	
MD-216-1000-EG-ST-CRT-1001	CIVIL,STRUCTURAL AND ARCHITECTURAL DESIGN CRITERIA	A01	31/07/2020	ISSUED FOR REFERENCE	AMJ	SGC	SHD	PRI	

RESERVED FOR VENDOR LOGO AND DRAWING NUMBER

LARSEN & TOUBRO

This drawing is the property of LARSEN & TOUBRO and must not be passed on to any person or body not authorized by us to receive it nor be copied or otherwise made use either in full or in part by such person or body without our prior permission in writing.

Outotec

The content of these documents are the sole property of Outotec Oyj. Any rights not expressly granted herein are reserved. Reproduction, transfer or distribution of part or all of the contents in any form without prior written permission of Outotec is prohibited.

MA'ADEN معادن
Saudi Arabian Mining Company شركة معادن العربية السعودية

This document and the information contained herein is Ma'aden proprietary know-how. This document or any part thereof should not be reproduced, stored in a retrieval system or transmitted by any means, electronic or otherwise, or divulged without prior written permission of Ma'aden.

LARSEN & TOUBRO DRAWING NUMBER: O19045_008_C_G_24298_002 | REVISION: 4
OUTOTEC DRAWING NUMBER: 900707__GAU01__WG01__MTL01__45088 | DOCUMENT ID: OU100690011 | REVISION: 4

DRAWN	AMJ	29/07/2020
CHECKED	SGC	30/07/2020
ENGINEER	SHD	28/07/2020
APPROVED	PRI	31/07/2020
EMPLOYER		
SCALE 1:75, 1:25 & 1:15		A1

MANSOURAH - MASSARAH GOLD PROJECT
GENERAL ARRANGEMENT
POWER PLANT PUMP SHED
GA AND DETAIL OF FOUNDATION

DRAWING NUMBER: MD - 216 - 49PR- EG - CV - GAD - 2017 | REV: D01