


DRAWING NUMBER: MD-216-49PR-EG-CV-GAD-2019 REV D01

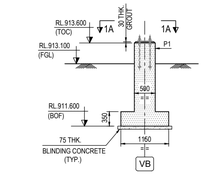


SECTION : F-F
(SCALE - 1:50)

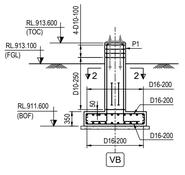


SECTION : 7-7
(SCALE - 1:50)

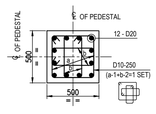


SECTION : 2 - 2
(TYP. RC DETAIL OF PEDESTAL MKD. P1)

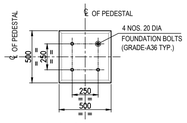


SECTION : 1A - 1A
(TYP. DETAIL OF PEDESTAL MKD. P1)
(SCALE- 1:20)

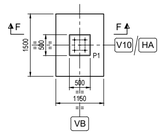


DETAIL OF FOUNDATION MKD. F6
(FOR G.A. DETAIL)
(SCALE - 1:50)

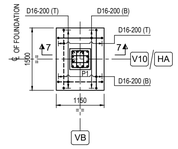


DETAIL OF FOUNDATION MKD. F6
(FOR R.C. DETAIL)
(SCALE - 1:50)

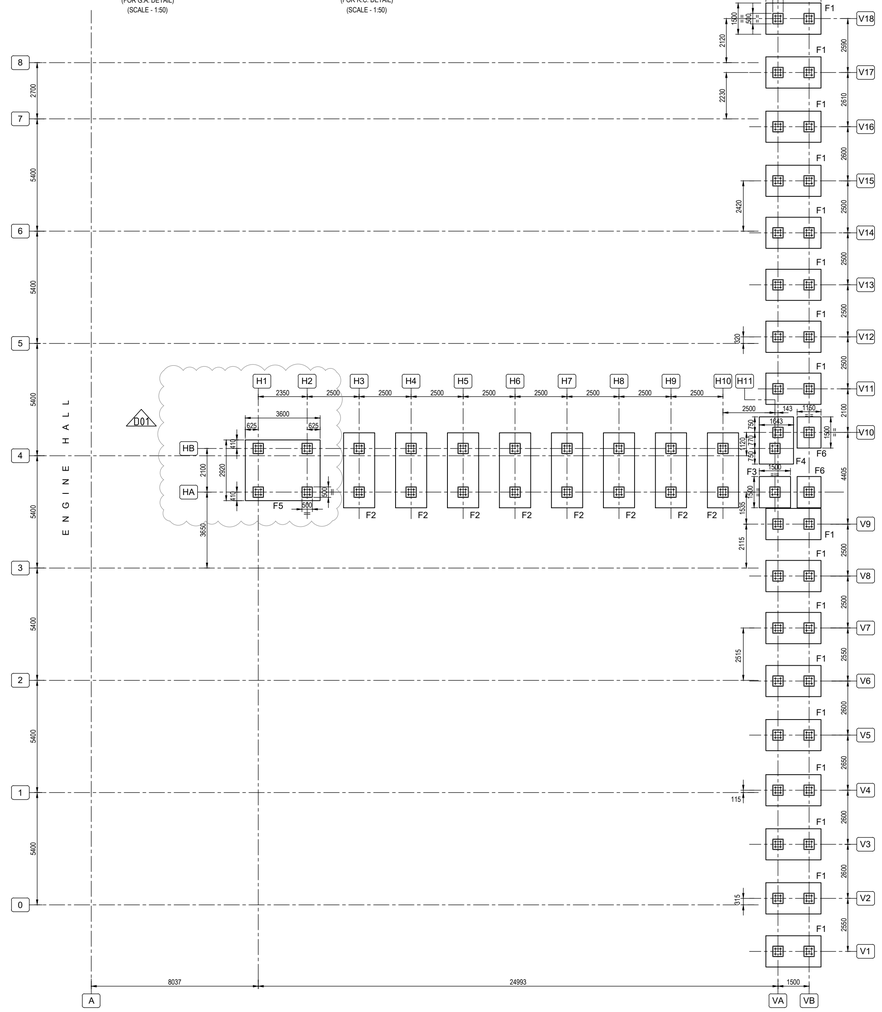


FOUNDATION LAYOUT PLAN
(SCALE 1:100)

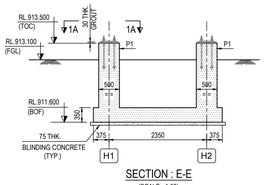

SECTION : E-E
(SCALE - 1:50)

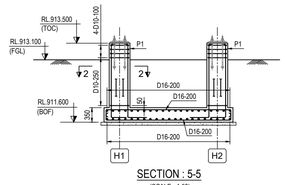


SECTION : 5-5
(SCALE - 1:50)

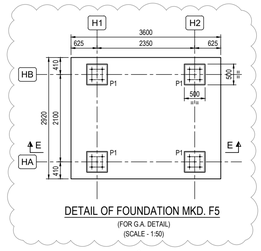


DETAIL OF FOUNDATION MKD. F5
(FOR G.A. DETAIL)
(SCALE - 1:50)

D01

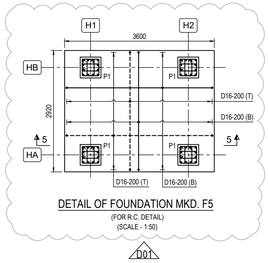


DETAIL OF FOUNDATION MKD. F5
(FOR R.C. DETAIL)
(SCALE - 1:50)


D01

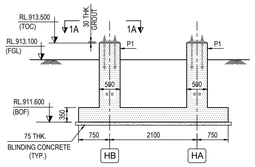


SECTION : B-B
(SCALE - 1:50)

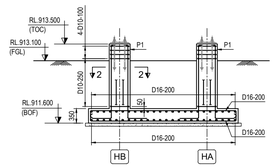


SECTION : 3-3
(SCALE - 1:50)

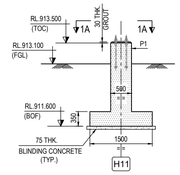


SECTION : D-D
(SCALE - 1:50)

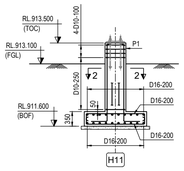


SECTION : 6-6
(SCALE - 1:50)

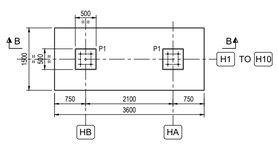


DETAIL OF FOUNDATION MKD. F2
(FOR G.A. DETAIL)
(SCALE - 1:50)

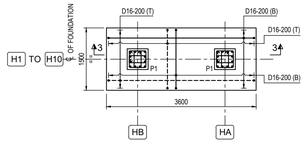

DETAIL OF FOUNDATION MKD. F2
(FOR R.C. DETAIL)
(SCALE - 1:50)

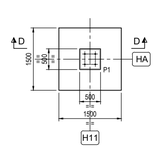

DETAIL OF FOUNDATION MKD. F3
(FOR G.A. DETAIL)
(SCALE - 1:50)

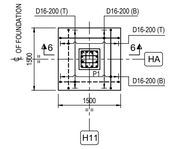


DETAIL OF FOUNDATION MKD. F3
(FOR R.C. DETAIL)
(SCALE - 1:50)

SECTION : A-A
(SCALE - 1:50)


DETAIL OF FOUNDATION MKD. F1
(FOR G.A. DETAIL)
(SCALE - 1:50)

D01

SECTION : 1-1
(SCALE - 1:50)

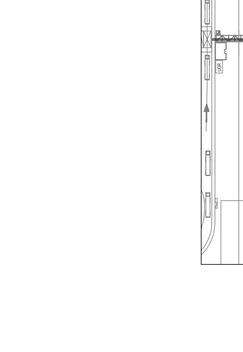

SECTION : C-C
(SCALE - 1:50)

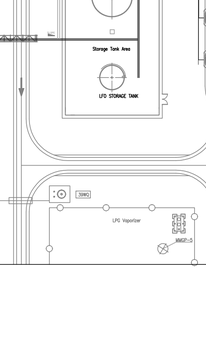


SECTION : 4-4
(SCALE - 1:50)

DETAIL OF FOUNDATION MKD. F1
(FOR R.C. DETAIL)
(SCALE - 1:50)

DETAIL OF FOUNDATION MKD. F4
(FOR G.A. DETAIL)
(SCALE - 1:50)

DETAIL OF FOUNDATION MKD. F4
(FOR G.A. DETAIL)
(SCALE - 1:50)

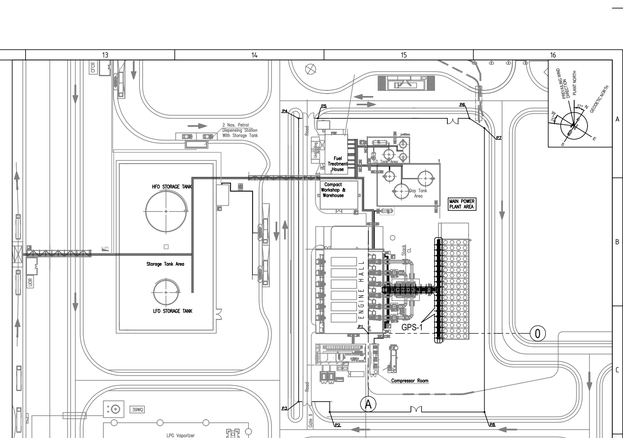

SCHEDULE OF BOLTS	
BOLT DIA. (MM)	BOLT NUMBERS REQUIRED
20	236

LEGEND :-

TOC = TOP OF CONCRETE
BOC = BOTTOM OF CONCRETE
FGL = FINISHED GROUND LEVEL
BOF = BOTTOM OF FOUNDATION
TYP = TYPICAL
MKD = MARKED
℄ = CENTRE LINE
THK = THICK
GA = GENERAL ARRANGEMENT.
RC = REINFORCED CONCRETE
PCC = PLAIN CEMENT CONCRETE
DIA = DIAMETER
T = TOP
B = BOTTOM
RL = REDUCED LEVEL
UNO = UNLESS NOTED OTHERWISE
– – – – = TOP REINFORCEMENT
——— = BOTTOM REINFORCEMENT

NOTES :-

1. ALL DIMENSIONS ARE IN MILLIMETRES AND LEVELS AND CO-ORDINATES ARE IN METRES UNLESS OTHERWISE STATED.
2. GRADE OF CONCRETE SHALL BE 35 MPa FOR FOUNDATION & 15 MPa FOR BLINDING CONCRETE.
3. GRADE OF REINFORCEMENT SHALL BE DEFORMED BAR 420 MPa (GRADE 60) - ASTM A615/A615M.
4. NET SAFE BEARING CAPACITY OF SOIL AT BOTTOM OF FOUNDATION CONSIDER 450KN/ SQ. M.
5. REINFORCEMENT SHALL BE SUITABLY ADJUSTED AT SITE TO CLEAR POCKETS, BOLTS ETC.
6. IF ANY PART OF FOUNDATION COMES ON BACKFILL ZONE OF ADJACENT FOUNDATION OR ANY LOOSE SOIL ARE ENCOUNTERED BELOW FOUNDATION LEVEL THE SAME SHALL BE REMOVED AND FILLED WITH PCC.
7. FOR ALL OTHER NOTES REFER DRAWING NO. MD-101-SMEM-EG-ST-DST-0001 TO 0008.
8. FOR GENERAL NOTES OF CIVIL WORKS & STANDARD REINFORCEMENT DETAIL REFER DRAWING NO. MD-216-1000-EG-CV-DED-1001 & 1005.

DOCUMENT NUMBER	REFERENCE DOCUMENTS	REV	DATE	REVISION DESCRIPTION	DRN	CHK	ENG	APP	EMP
		D01	03/05/2023	AS-BUILT - REVISED AS MARKED (01)	ABH	UR	SVK	AG	
		C02	07/12/2020	ISSUED FOR CONSTRUCTION & REVISED AS MARKED (02)	ABH	UR	SVK	AG	
		C01	19/11/2020	ISSUED FOR CONSTRUCTION	SWB	UR	SVK	AG	
MD-216-49PR-EG-ST-GAD-2412	DETAIL OF PIPE SUPPORT GPS-1	A01	15/10/2020	ISSUED FOR REFERENCE	ABH	UR	SVK	AG	

RESERVED FOR VENDOR LOGO AND DRAWING NUMBER

LARSEN & TOUBRO

This drawing is the property of LARSEN & TOUBRO and must not be passed on to any person or body not authorized by us to receive it nor be copied or otherwise made use either in full or in part by such person or body without our prior permission in writing.

Outotec

The content of these documents are the sole property of Outotec Oyj. Any rights not expressly granted herein are reserved. Reproduction, transfer or distribution of part or all of the contents in any form without prior written permission of Outotec is prohibited.

MA'ADEN معادن Saudi Arabian Mining Company

This document and the information contained herein is Ma'aden proprietary know-how. This document or any part thereof should not be reproduced, stored in a retrieval system or transmitted by any means, electronic or otherwise, or divulged without prior written permission of Ma'aden.

LARSEN & TOUBRO DRAWING NUMBER	019045_008_C_G_24298_003
REVISION	3
OUTOTEC DRAWING NUMBER	900707__GAU01__WG01__MTL01__45089
DOCUMENT ID	OU100690012
REVISION	3
DRAWN	ABH 08/10/2020
CHECKED	UR 12/10/2020
ENGINEER	SVK 08/10/2020
APPROVED	AG 15/10/2020
EMPLOYER	
SCALE	1:100
	A0

MANSOURAH - MASSARAH GOLD PROJECT
GENERAL ARRANGEMENT
POWER PLANT PIPE RACK
G.A. AND DETAIL OF FOUNDATION FOR GPS-1

DRAWING NUMBER: MD-216-49PR-EG-CV-GAD-2019 REV: D01