
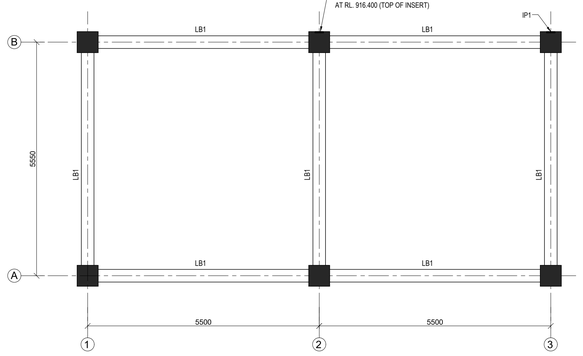



PLAN OF LINTLE BEAM AT RL.916.400 (T.O.B)

(SCALE 1:50)

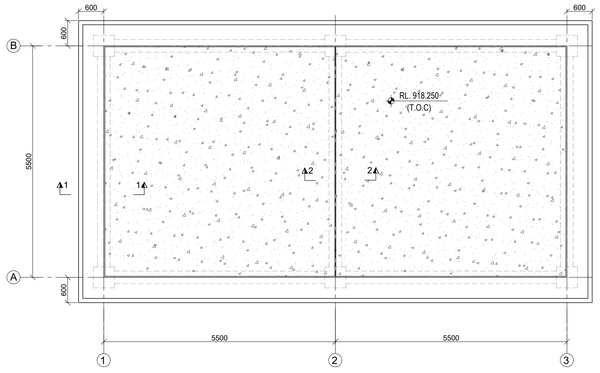


PLAN OF ROOF SLAB AT RL.918.250 (T.O.C)

(SCALE 1:50)

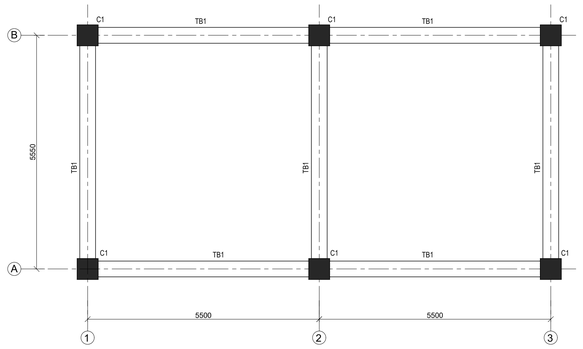


PLAN OF TIE BEAM AT RL.913.250 (T.O.B)

(SCALE 1:50)

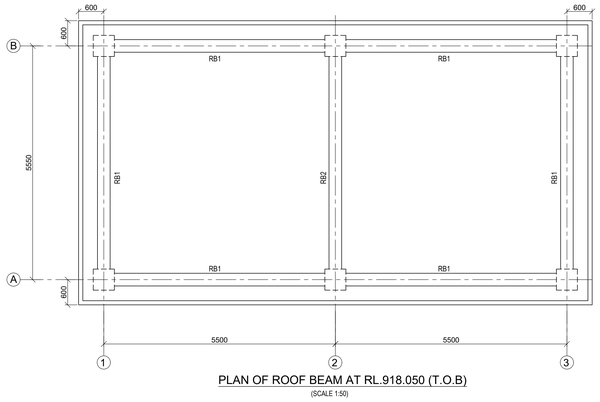


PLAN OF ROOF BEAM AT RL.918.050 (T.O.B)

(SCALE 1:50)

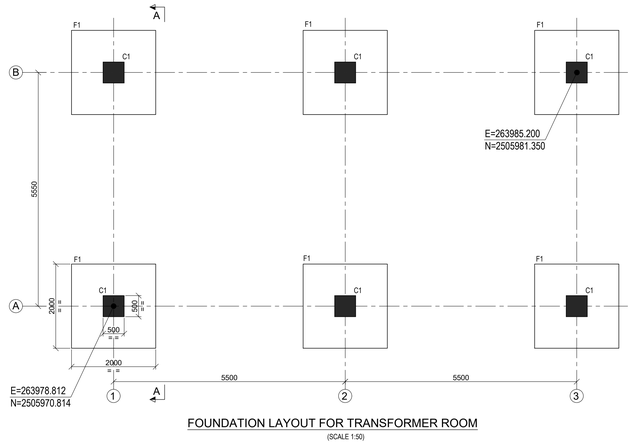


FOUNDATION LAYOUT FOR TRANSFORMER ROOM

(SCALE 1:50)

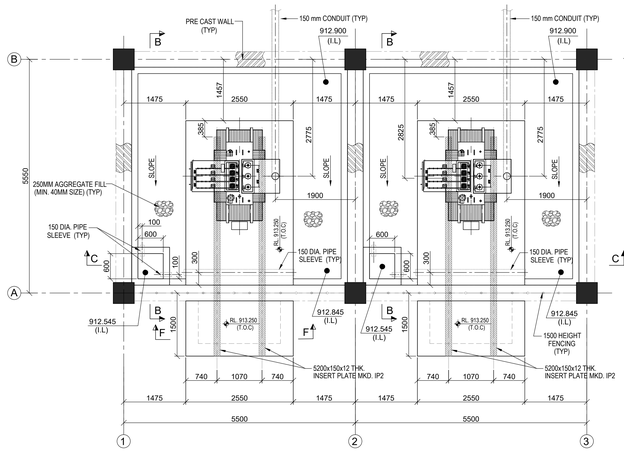


PLAN OF GRADE SLAB AT RL.913.250 (T.O.C)

(SCALE 1:50)

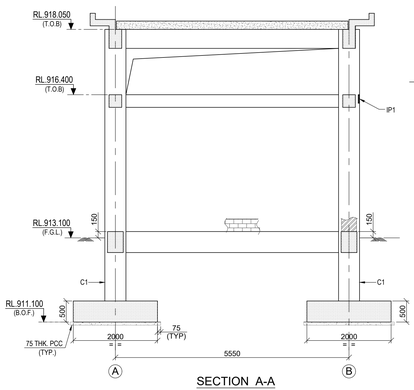


SECTION A-A

(SCALE - 1:50)

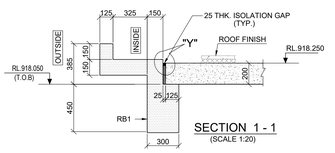


SECTION 1 - 1

(SCALE 1:20)

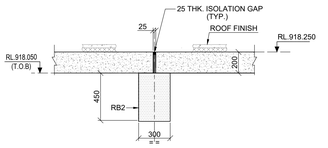


SECTION 2 - 2

(SCALE 1:20)

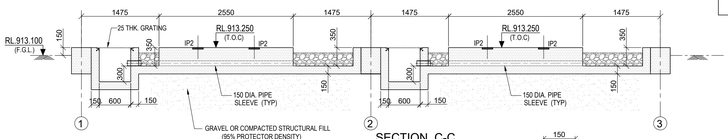


SECTION C-C

(SCALE - 1:40)

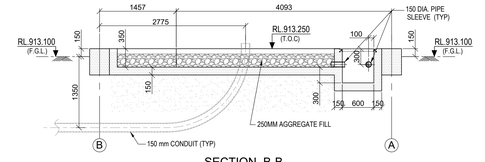


SECTION B-B

(SCALE - 1:40)

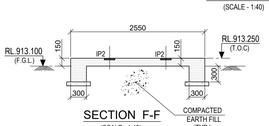


SECTION F-F

(SCALE - 1:40)

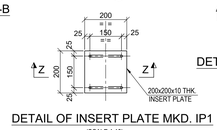

DETAIL OF INSERT PLATE MKD. IP1

(SCALE 1:10)

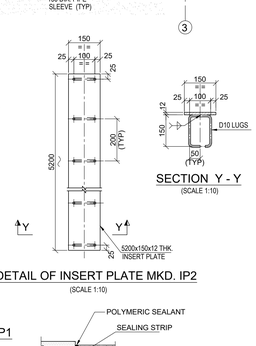


DETAIL OF INSERT PLATE MKD. IP2

(SCALE 1:10)


SECTION Y - Y

(SCALE 1:10)

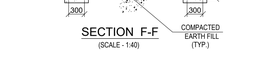


SECTION F-F

(SHOWING RC DETAIL)
(SCALE - 1:40)

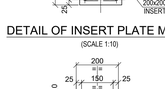


SECTION Z - Z

(SCALE 1:10)

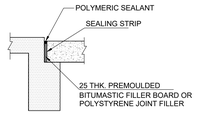


DETAIL 'Y'

(SCALE 1:20)

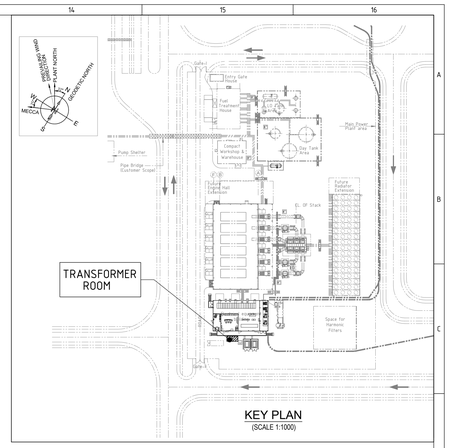


RCC SCHEDULE OF BEAM

BEAM MKD.	SIZE	CROSS SECTION	TOP OF BEAM (T.O.B)
TB1	375 x 500	4-D16; 4L-D10-250; 4-D16; 500; 375	RL. 913.250
LB1	300 x 300	3-D12; 2L-D10-200; 3-D12; 300	RL. 916.400
RB1	300 x 450	D10 @150 C/C; 3-D16; 2L-D10-200; 3-D16; 385; 450; 300	RL. 918.050
RB2	300 x 450	3-D16; 2L-D10-200; 3-D16; 450; 300	RL. 918.050

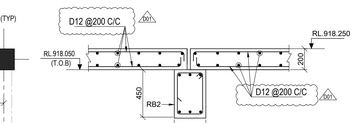


SECTION 2 - 2

(SHOWING RC DETAIL)
(SCALE 1:20)

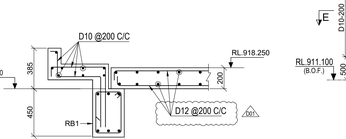


SECTION 1 - 1

(SHOWING RC DETAIL)
(SCALE 1:20)

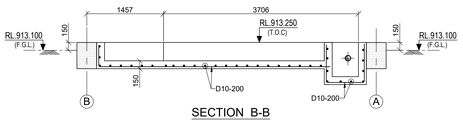


SECTION B-B

(SHOWING RC DETAIL)
(SCALE - 1:40)

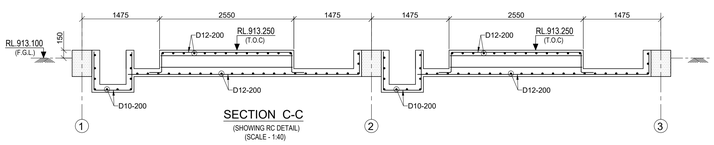


SECTION C-C

(SHOWING RC DETAIL)
(SCALE - 1:40)

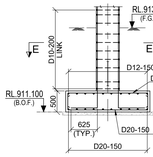


SECTION D-D

(SCALE - 1:50)

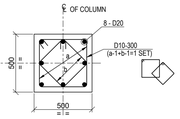

SECTION : E - E

(TYP. RC DETAIL OF COLUMN MKD. C1)
(SCALE- 1:20)

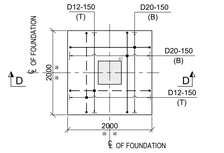

R.C. DETAIL OF FOUNDATION MKD. F1

(6 NOS. REQUIRED)
(SCALE - 1:50)

LEGEND :-

RL. - REDUCED LEVEL.
IL - INVERT LEVEL.
T.O.C. - TOP OF CONCRETE.
T.O.B. - TOP OF BEAM.
F.G.L. - FINISHED GROUND LEVEL.
B.O.F. - BOTTOM OF FOOTING.
B.O.B. - BOTTOM OF BEAM.
HCS - HOLLOW CORE SLAB
SSL - STRUCTURAL SLAB LEVEL
℄ - CENTRE LINE
TYP. - TYPICAL.
THK. - THICK.
DIA. - DIAMETER
MKD. - MARKED.
G.A. - GENERAL ARRANGEMENT.
R.C. - REINFORCED CONCRETE
B - BOTTOM REINFORCEMENT ———
T - TOP REINFORCEMENT – – – – –
WWF - WELDED WIRE FABRIC
U.N.O. - UNLESS NOTED OTHERWISE

NOTES :-

1. ALL DIMENSIONS ARE IN MILLIMETRES AND LEVELS AND CO-ORDINATES ARE IN METRES. UNLESS OTHERWISE STATED.
2. GRADE OF CONCRETE SHALL BE 35 MPa FOR FOUNDATION & 15 MPa FOR BLINDING CONCRETE.
3. GRADE OF REINFORCEMENT SHALL BE DEFORMED BAR 420 MPa (GRADE 60) - ASTM A615/A615M.
4. NET SAFE BEARING CAPACITY OF SOIL AT BOTTOM OF FOUNDATION CONSIDER 500KN/ SQ. M.
5. CLEAR COVER TO MAIN REINFORCEMENT SHALL BE
   a) FOUNDATION = 75 mm (BOTTOM & SIDE) 50 mm. (TOP)
   b) COLUMN & PEDESTAL = 50mm
   c) BEAM = 50mm
   d) SLAB = 20mm
6. IF ANY PART OF FOUNDATION COMES ON BACKFILL ZONE OF ADJACENT FOUNDATION OR ANY LOOSE SOIL ARE ENCOUNTERED BELOW FOUNDATION LEVEL THE SAME SHALL BE REMOVED AND FILLED WITH PCC.
7. GENERAL NOTES FOR CIVIL WORKS & STANDARD REINFORCEMENT DETAIL REFER DRAWING NO. MD-216-1000-EG-CV-DED-1001 & 1005.

REV	DATE	REVISION DESCRIPTION	DRN	CHK	ENG	APP	EMP
D01	17/02/2023	AS-BUILT & REVISED AS MKD. 1001	AMJ	SGC	SHD	PRI	
C03	04/05/2021	ISSUED FOR CONSTRUCTION & REVISED AS MKD. 1001	AMJ	SGC	SHD	PRI	
C02	26/11/2020	ISSUED FOR CONSTRUCTION & REVISED AS MKD. 1001	PDK	SGC	SHD	PRI	
C01	03/11/2020	ISSUED FOR CONSTRUCTION & REVISED AS MKD. 1001	PDK	SGC	SHD	PRI	
A01	16/10/2020	ISSUED FOR REFERENCE	AMJ	SGC	SHD	PRI	

DOCUMENT NUMBER	REFERENCE DOCUMENTS
MD-216-1000-EG-ST-CRT-1001	CIVIL, STRUCTURAL & ARCHITECTURAL - DESIGN CRITERIA
MD-216-49PR-EG-ME-LAD-V553-1002	LAYOUT OF POWER GENERATION

RESERVED FOR VENDOR LOGO AND DRAWING NUMBER

LARSEN & TOUBRO

This drawing is the property of LARSEN & TOUBRO and must not be passed on to any person or body not authorized by us to receive it nor be copied or otherwise made use either in full or in part by such person or body without our prior permission in writing.

Outotec

The content of these documents are the sole property of Outotec Oyj. Any rights not expressly granted herein are reserved. Reproduction, transfer or distribution of part or all of the contents in any form without prior written permission of Outotec is prohibited.

MA'ADEN معادن
Saudi Arabian Mining Company شركة معادن العربية السعودية

This document and the information contained herein is Ma'aden proprietary know-how. This document or any part thereof should not be reproduced, stored in a retrieval system or transmitted by any means, electronic or otherwise, or divulged without prior written permission of Ma'aden.

LARSEN & TOUBRO DRAWING NUMBER: 019045_008_C_G_24298_004 — REVISION: 4
OUTOTEC DRAWING NUMBER: 900707__GAU01__WG01_MTL01__45090 — DOCUMENT ID: OU100690013 — REVISION: 4

DRAWN	AMJ	08/10/2020	MANSOURAH - MASSARAH GOLD PROJECT
CHECKED	SGC	10/10/2020	GENERAL ARRANGEMENT
ENGINEER	SHD	06/10/2020	TRANSFORMER ROOM
APPROVED	PRI	16/10/2020	GA AND DETAIL
EMPLOYER			
SCALE	1:200,100,20	A0	DRAWING NUMBER: MD-216-49PR-EG-CV-GAD-2021 — REV: D01