


DRAWING NUMBER: MD - 216 - 49PR- EG - CV - GAD - 2022 | REV: D01

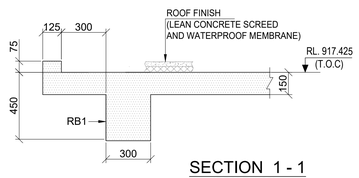

SECTION 1 - 1
(SCALE 1:20)

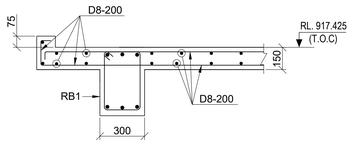


SECTION 1 - 1
(SHOWING RC DETAIL)
(SCALE 1:20)

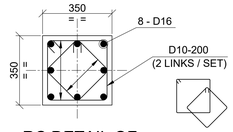


RC DETAIL OF COLUMN MKD. C1
(4 NOS. REQUIRED)
(SCALE- 1:15)

RCC SCHEDULE OF BEAM


BEAM MKD.	SIZE	CROSS SECTION	TOP OF BEAM (T.O.B)
GB1	300 x 450	3-D16; 450; 2L-D10-200; 3-D16; 300	RL. 914.100
LB1	250 x 250	3-D12; 250; 2L-D10-200; 3-D12; 250	RL. 916.450
RB1	300 x 450	75; D8 - 200; 3-D16; 450; 2L-D10-200; 3-D16; 300	RL. 917.425
RB2	300 x 450	3-D16; 450; 2L-D10-200; 3-D16; 300	RL. 917.425

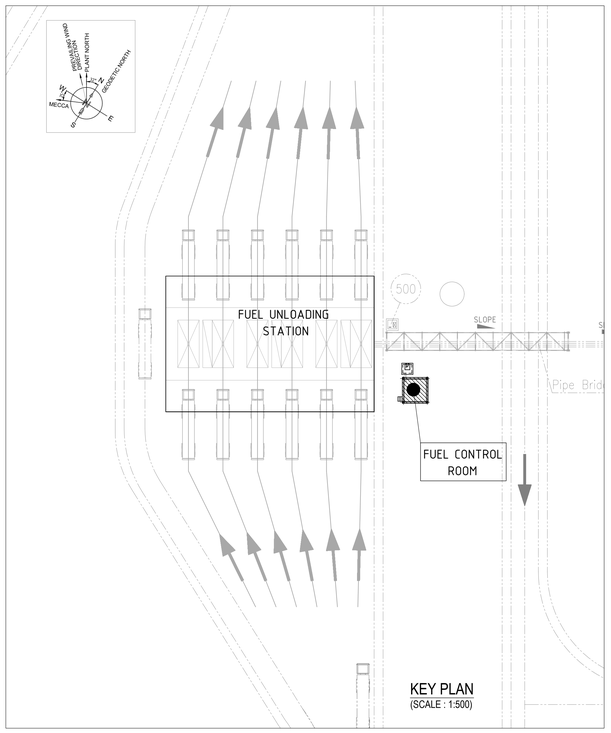


KEY PLAN
(SCALE : 1:500)

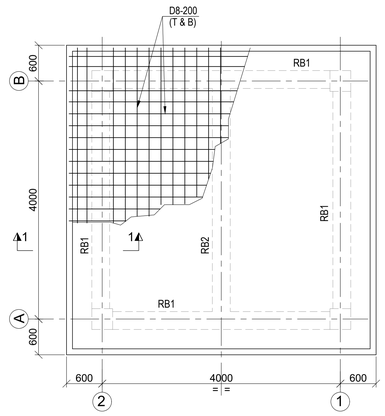

PLAN AT RL. 917.425 (T.O.C)
(SCALE 1:50)

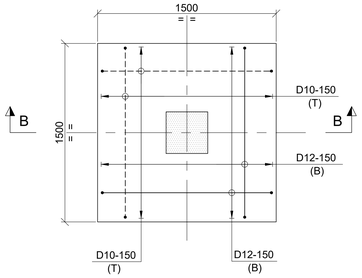


R.C. DETAIL OF FOUNDATION MKD. F1
(F1 - 6 NOS. REQUIRED)
(SCALE- 1:25)

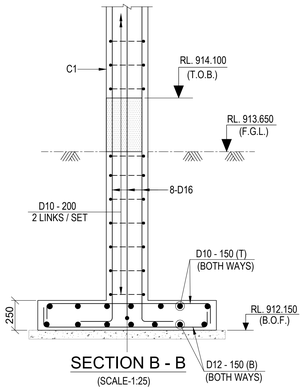


SECTION B - B
(SCALE-1:25)

LEGEND :-


RL. - REDUCED LEVEL.
T.O.C. - TOP OF CONCRETE.
T.O.B. - TOP OF BEAM.
F.G.L. - FINISHED GROUND LEVEL.
B.O.F. - BOTTOM OF FOOTING.
B.O.B. - BOTTOM OF BEAM.
HCS - HOLLOW CORE SLAB
SSL - STRUCTURAL SLAB LEVEL
CL - CENTRE LINE.
TYP. - TYPICAL.
THK. - THICK.
MKD. - MARKED.
G.A. - GENERAL ARRANGEMENT.
R.C.C. - REINFORCED CEMENT CONRETE.
WWF - WELDED WIRE FABRIC
U.N.O. - UNLESS NOTED OTHERWISE
T - TOP.
B - BOTTOM.
DRG - DRAWING.

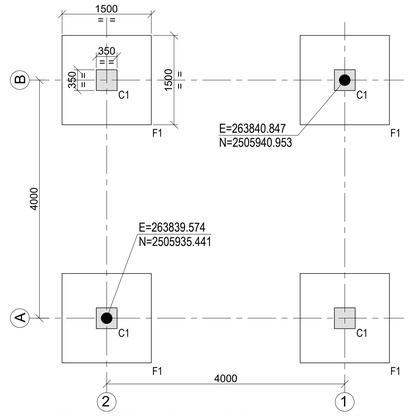


FOUNDATION PLAN AT RL.912.150 (B.O.F.)
(SCALE 1:50)

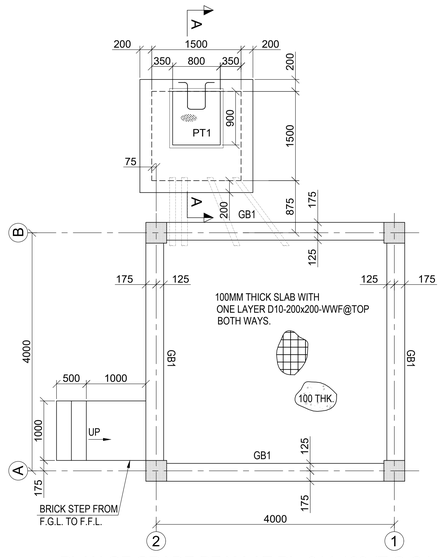


PLAN OF GRADE BEAM AT RL. 914.100 (T.O.C.)
(SCALE 1:50)

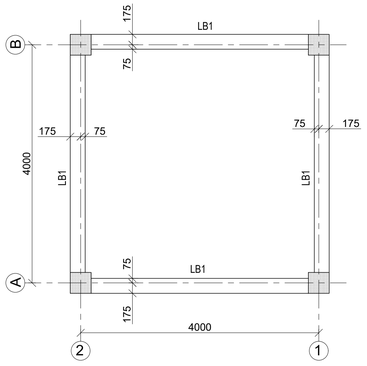

PLAN OF LINTEL BEAM AT RL. 916.450 (T.O.C.)
(SCALE 1:50)

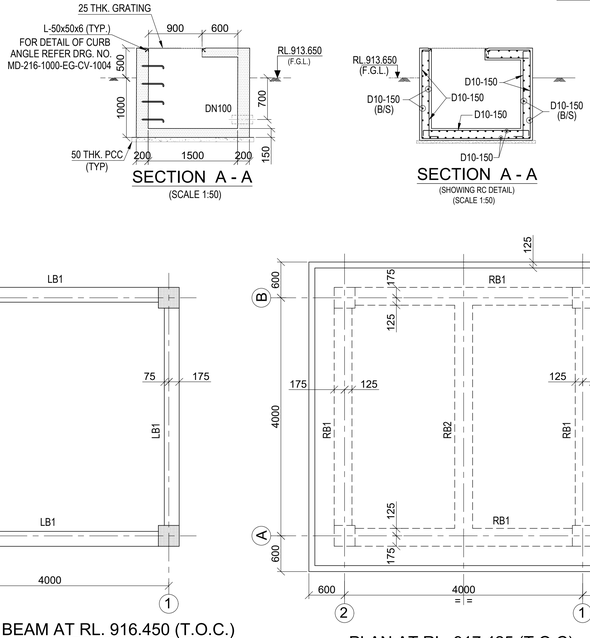

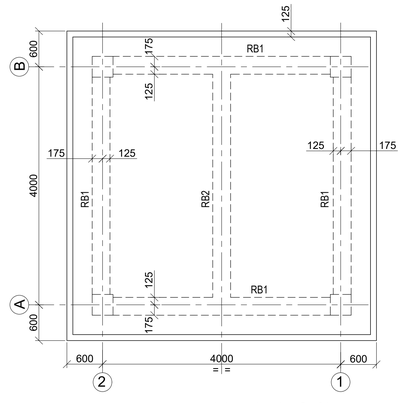

PLAN AT RL. 917.425 (T.O.C)
(SCALE 1:50)

NOTES :-

1. ALL DIMENSIONS ARE IN MILLIMETRES AND LEVELS AND CO-ORDINATES ARE IN METRES. UNLESS OTHERWISE STATED.
2. FGL CORRESPONDS TO RL. (+) 913.100 M LEVEL.
3. GRADE OF CONCRETE SHALL BE 35 MPa FOR FOUNDATION & 15 MPa FOR BLINDING CONCRETE.
4. GRADE OF REINFORCEMENT SHALL BE DEFORMED BAR 420 MPa (GRADE 60) - ASTM A615/A615M.
5. NET SAFE BEARING CAPACITY OF SOIL AT BOTTOM OF FOUNDATION CONSIDER 500KN/ SQ. M.
6. CLEAR COVER TO MAIN REINFORCEMENT SHALL BE
   a) FOUNDATION = 75 mm (BOTTOM & SIDE) 50 mm. (TOP)
   b) COLUMN & PEDESTAL = 50mm
   c) BEAM = 50mm
   d) SLAB = 20mm
7. IF ANY PART OF FOUNDATION COMES ON BACKFILL ZONE OF ADJACENT FOUNDATION OR ANY LOOSE SOIL ARE ENCOUNTERED BELOW FOUNDATION LEVEL THE SAME SHALL BE REMOVED AND FILLED WITH PCC.
8. ALL OTHER NOTES REFER DRAWING NO. MD-101-SMEM-EG-ST-DST-0001 TO 0008.
9. GENERAL NOTES FOR CIVIL WORKS & STANDARD REINFORCEMENT DETAIL REFER DRAWING NO. MD-216-1000-EG-CV-DED-1001 & 1005.
10. FOR ANCHOR BOLTS STANDARD DETAILS. REFER DRAWING NO. MD-216-1000-EG-CV-DED-1003

DOCUMENT NUMBER	REFERENCE DOCUMENTS	REV	DATE	REVISION DESCRIPTION	DRN	CHK	ENG	APP	EMP
MD-216-1000-EG-ST-CRT-1001	CIVIL, STRUCTURAL & ARCHITECTURAL-	D01	17/02/2023	AS-BUILT	AMJ	SGC	SHD	PRI	
	DESIGN CRITERIA	C02	04/06/2021	ISSUED FOR CONSTRUCTION & REVISED AS MKD. C02	AMJ	SGC	SHD	PRI	
MD-216-1000-EG-CV-DED-1003	ANCHOR BOLTS STANDARD DETAILS.	C01	15/01/2021	ISSUED FOR CONSTRUCTION & REVISED AS MKD. C01	PDK	SGC	SHD	PRI	
MD-216-49PR-EG-ME-LAD-V553-1002	LAYOUT OF POWER GENERATION	A01	08/12/2020	ISSUED FOR REVIEW	PDK	SGC	SHD	PRI	

RESERVED FOR VENDOR LOGO AND DRAWING NUMBER

LARSEN & TOUBRO DRAWING NUMBER: O19045_008_C_G_24298_005 | REVISION: 3
OUTOTEC DRAWING NUMBER: 900707__GAU01__WG01__MTL01__45091 | DOCUMENT ID: OU100690014 | REVISION: 3

LARSEN & TOUBRO
This drawing is the property of LARSEN & TOUBRO and must not be passed on to any person or body not authorized by us to receive it nor be copied or otherwise made use either in full or in part by such person or body without our prior permission in writing.

Outotec
The content of these documents are the sole property of Outotec Oyj. Any rights not expressly granted herein are reserved. Reproduction, transfer or distribution of part or all of the contents in any form without prior written permission of Outotec is prohibited.

MA'ADEN معادن
Saudi Arabian Mining Company شركة معادن العربية السعودية
This document and the information contained herein is Ma'aden proprietary know-how. This document or any part thereof should not be reproduced, stored in a retrieval system or transmitted by any means, electronic or otherwise, or divulged without prior written permission of Ma'aden.

DRAWN	PDK	18/11/2020
CHECKED	SGC	24/11/2020
ENGINEER	SHD	15/11/2020
APPROVED	PRI	08/12/2020
EMPLOYER		
SCALE 1:175, 1:40 & 1:25	A1	

MANSOURAH - MASSARAH GOLD PROJECT
GENERAL ARRANGEMENT
FUEL CONTROL ROOM
G.A. AND DETAIL

DRAWING NUMBER: MD - 216 - 49PR- EG - CV - GAD - 2022 | REV: D01