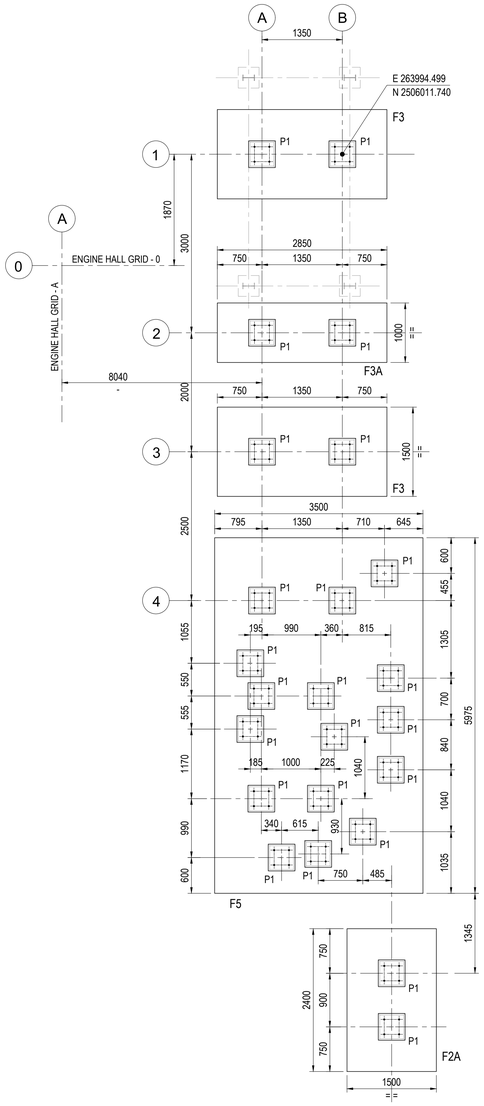
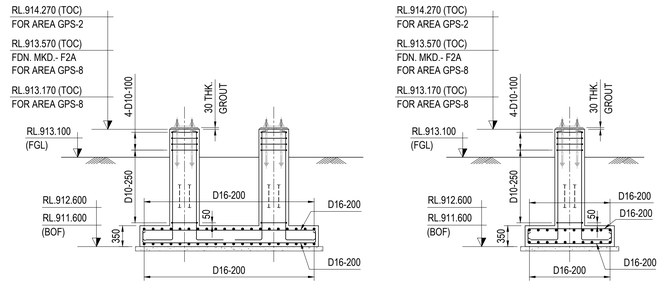
DRAWING NUMBER MD-216-49PR-EG-CV-GAD-2027 REV D01



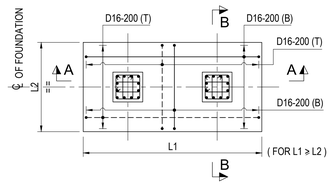

FOUNDATION LAYOUT PLAN AT RL.911.600 B.O.F. (U.N.O.)
AREA GPS - 8
(SCALE 1:50)



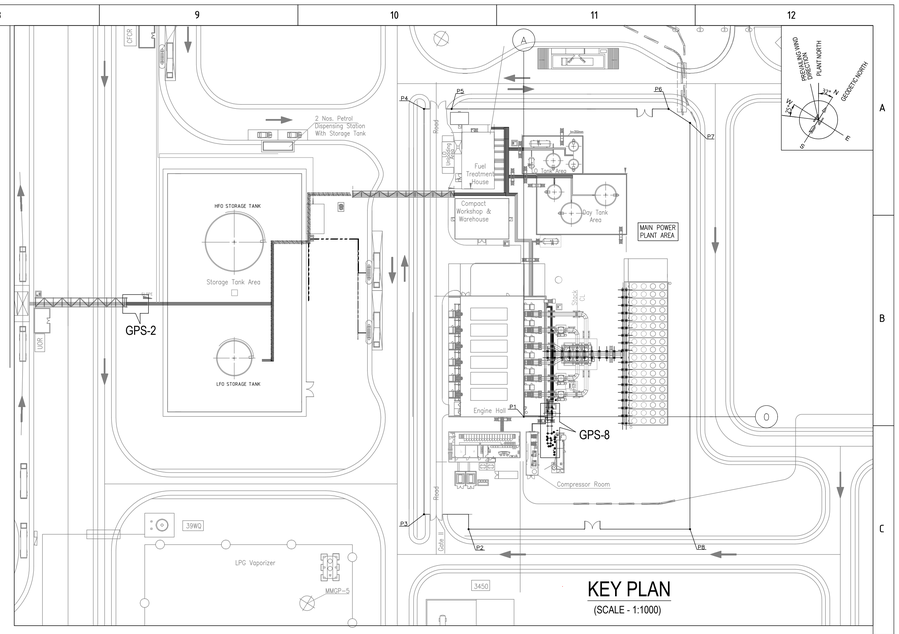

SECTION : A-A
(SCALE - 1:50)



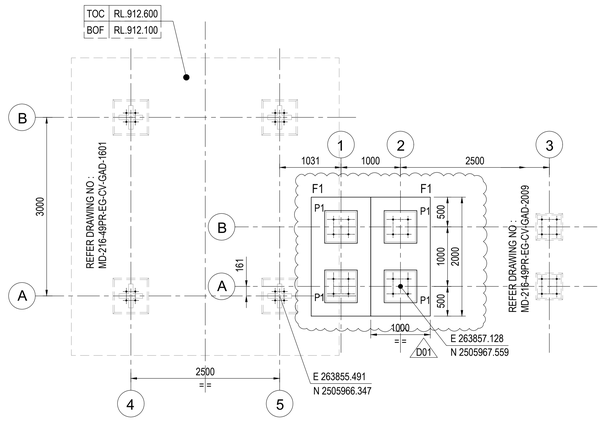

SECTION : B-B
(SCALE - 1:50)



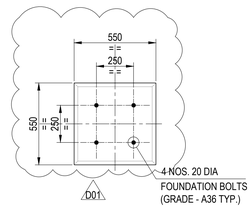

REINFORCEMENT DETAIL OF FOUNDATION (TYPICAL)
(SCALE - 1:50)



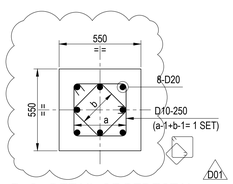

| SCHEDULE OF BOLTS | | |
|---|---|---|
| AREA | BOLT DIA. (MM) | BOLT NUMBERS REQUIRED |
| GPS-8 | 20 | 96 |
| GPS-2 | 20 | 16 |




FOUNDATION LAYOUT PLAN AT RL.912.600 B.O.F. (U.N.O.)
AREA GPS - 2
(SCALE 1:50)




BOLT ARRANGEMENT DETAIL OF
PEDESTAIL MKD. P1 (TYP.)
(SCALE- 1:20)




R. C. DETAIL OF PEDESTAL
MKD. P1 (TYP.)
(SCALE- 1:20)

## LEGEND :-

TOC = TOP OF CONCRETE
BOC = BOTTOM OF CONCRETE
FGL = FINISHED GROUND LEVEL
BOF = BOTTOM OF FOUNDATION
TYP = TYPICAL
MKD = MARKED
℄ = CENTRE LINE
THK = THICK
GA = GENERAL ARRANGEMENT.
RC = REINFORCED CONCRETE
PCC = PLAIN CEMENT CONCRETE
DIA = DIAMETER
T = TOP
B = BOTTOM
RL = REDUCED LEVEL
UNO = UNLESS NOTED OTHERWISE
– – – – = TOP REINFORCEMENT
——— = BOTTOM REINFORCEMENT

## NOTES :-

1. ALL DIMENSIONS ARE IN MILLIMETRES AND LEVELS AND CO-ORDINATES ARE IN METRES UNLESS OTHERWISE STATED.
2. GRADE OF CONCRETE SHALL BE 35 MPa FOR FOUNDATION & 15 MPa FOR BLINDING CONCRETE.
3. GRADE OF REINFORCEMENT SHALL BE DEFORMED BAR 420 MPa (GRADE 60) - ASTM A615/A615M.
4. NET SAFE BEARING CAPACITY OF SOIL AT BOTTOM OF FOUNDATION CONSIDER 450KN/ SQ. M.
5. REINFORCEMENT SHALL BE SUITABLY ADJUSTED AT SITE TO CLEAR POCKETS, BOLTS ETC.
6. IF ANY PART OF FOUNDATION COMES ON BACKFILL ZONE OF ADJACENT FOUNDATION OR ANY LOOSE SOIL ARE ENCOUNTERED BELOW FOUNDATION LEVEL THE SAME SHALL BE REMOVED AND FILLED WITH PCC.
7. FOR ALL OTHER NOTES REFER DRAWING NO. MD-101-SMEM-EG-ST-DST-0001 TO 0008.
8. FOR GENERAL NOTES OF CIVIL WORKS & STANDARD REINFORCEMENT DETAIL REFER DRAWING NO. MD-216-1000-EG-CV-DED-1001 & 1005.

| DOCUMENT NUMBER | REFERENCE DOCUMENTS | REV | DATE | REVISION DESCRIPTION | DRN | CHK | ENG | APP | EMP |
|---|---|---|---|---|---|---|---|---|---|
| | | D01 | 17/02/2023 | AS-BUILT & REVISED AS MARKED △D01 | ABH | UR | SVK | AG | |
| | | C02 | 07/12/2020 | ISSUED FOR CONSTRUCTION & REVISED AS MARKED △C02 | ABH | UR | SVK | AG | |
| MD-216-49PR-EG-ST-GAD-2413 | DETAIL OF PIPE SUPPORT GPS-2, | C01 | 19/11/2020 | ISSUED FOR CONSTRUCTION & REVISED AS MARKED △C01 | SWB | UR | SVK | AG | |
| MD-216-49PR-EG-ST-GAD-2429 | DETAIL OF PIPE SUPPORT GPS-8, | A01 | 15/10/2020 | ISSUED FOR REFERENCE | ABH | UR | SVK | AG | |

RESERVED FOR VENDOR LOGO AND DRAWING NUMBER

LARSEN & TOUBRO
This drawing is the property of LARSEN & TOUBRO and must not be passed on to any person or body not authorized by us to receive it nor be copied or otherwise made use either in full or in part by such person or body without our prior permission in writing.

Outotec
The content of these documents are the sole property of Outotec Oyj. Any rights not expressly granted herein are reserved. Reproduction, transfer or distribution of part or all of the contents in any form without prior written permission of Outotec is prohibited.

MA'ADEN معادن
Saudi Arabian Mining Company شركة معادن العربية السعودية
This document and the information contained herein is Ma'aden proprietary know-how. This document or any part thereof should not be reproduced, stored in a retrieval system or transmitted by any means, electronic or otherwise, or divulged without prior written permission of Ma'aden.

| | | |
|---|---|---|
| LARSEN & TOUBRO DRAWING NUMBER | O19045_008_C_G_24375_002 | REVISION 3 |
| OUTOTEC DRAWING NUMBER | 900707__GAU01__WG01__MTL01__45101 | DOCUMENT ID OU100692104 REVISION 3 |

| | | |
|---|---|---|
| DRAWN | ABH | 04/10/2020 |
| CHECKED | UR | 13/10/2020 |
| ENGINEER | SVK | 04/10/2020 |
| APPROVED | AG | 15/10/2020 |
| EMPLOYER | | |
| SCALE 1:100 | | A1 |

MANSOURAH - MASSARAH GOLD PROJECT
GENERAL ARRANGEMENT
POWER PLANT PIPE RACK
G.A. AND DETAIL OF FOUNDATION FOR GPS-2 & 8

DRAWING NUMBER MD - 216 - 49PR- EG - CV - GAD - 2027 REV D01