MD - 216 - 49PR - EG - CV - GAD - 2030
DRAWING NUMBER
D01
REV

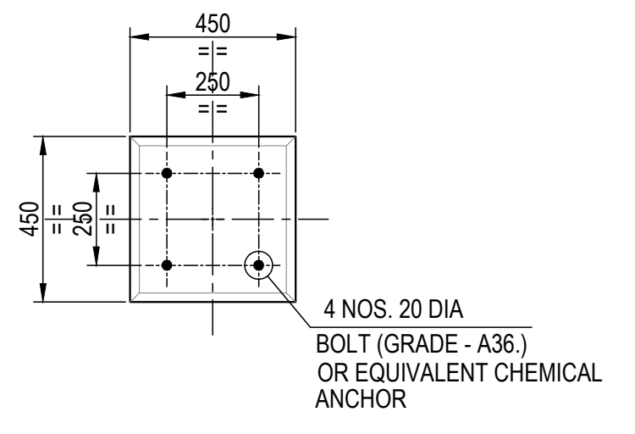

BOLT ARRANGEMENT DETAIL OF PEDESTAL MKD. P1 (TYP.)

(SCALE- 1:20)

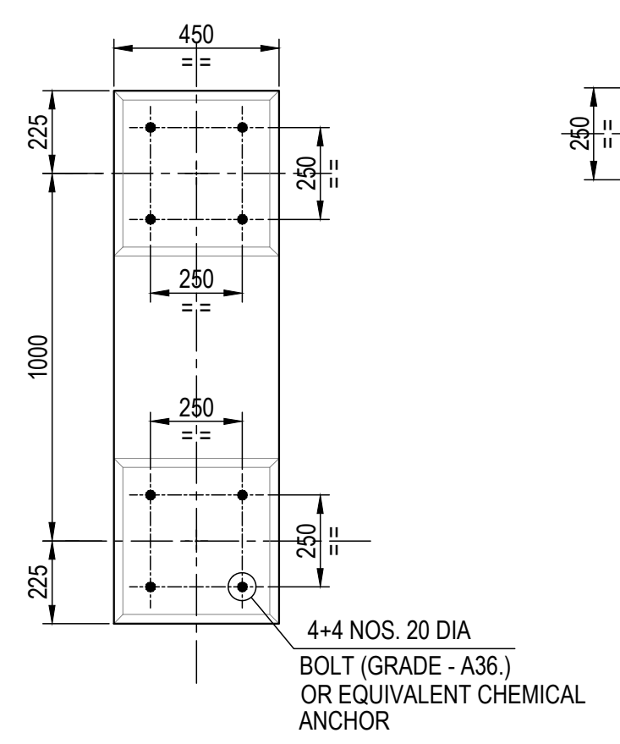

BOLT ARRANGEMENT DETAIL OF PEDESTAL MKD. P2 (TYP.)

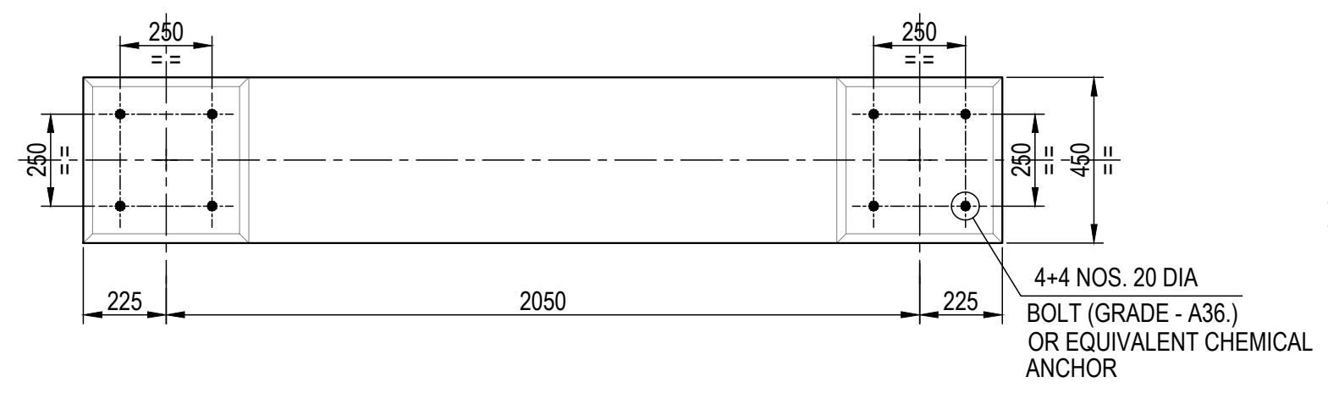

BOLT ARRANGEMENT DETAIL OF PEDESTAL MKD. P3 (TYP.)

(SCALE- 1:20)

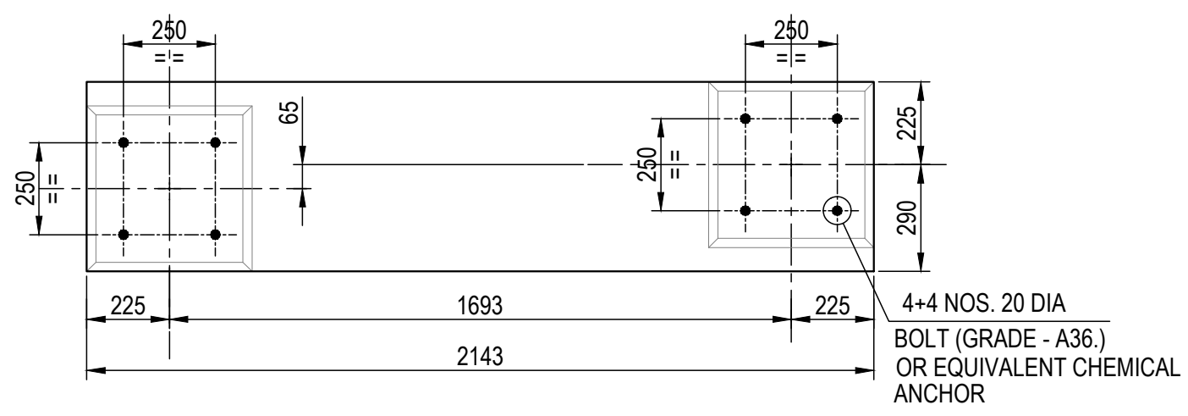

BOLT ARRANGEMENT DETAIL OF PEDESTAL MKD. P6

(SCALE- 1:20)

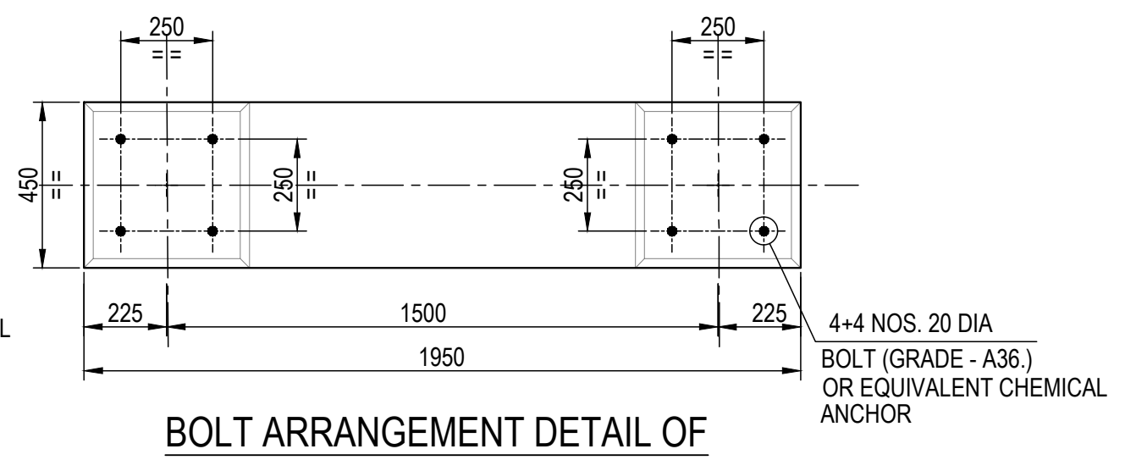

BOLT ARRANGEMENT DETAIL OF PEDESTAL MKD. P7

(SCALE- 1:20)

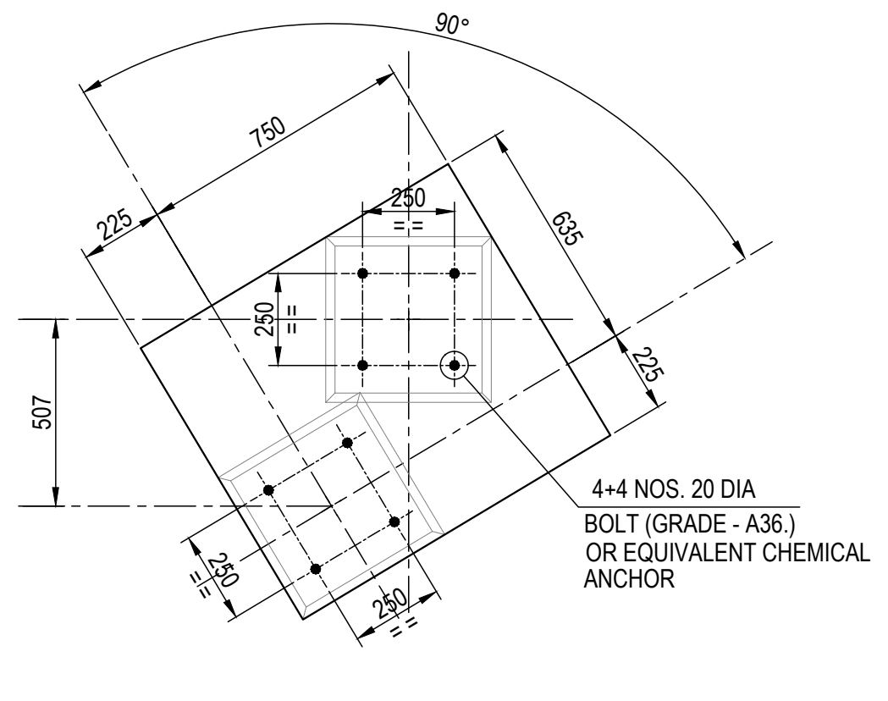

BOLT ARRANGEMENT DETAIL OF PEDESTAL MKD. P9

(SCALE- 1:20)

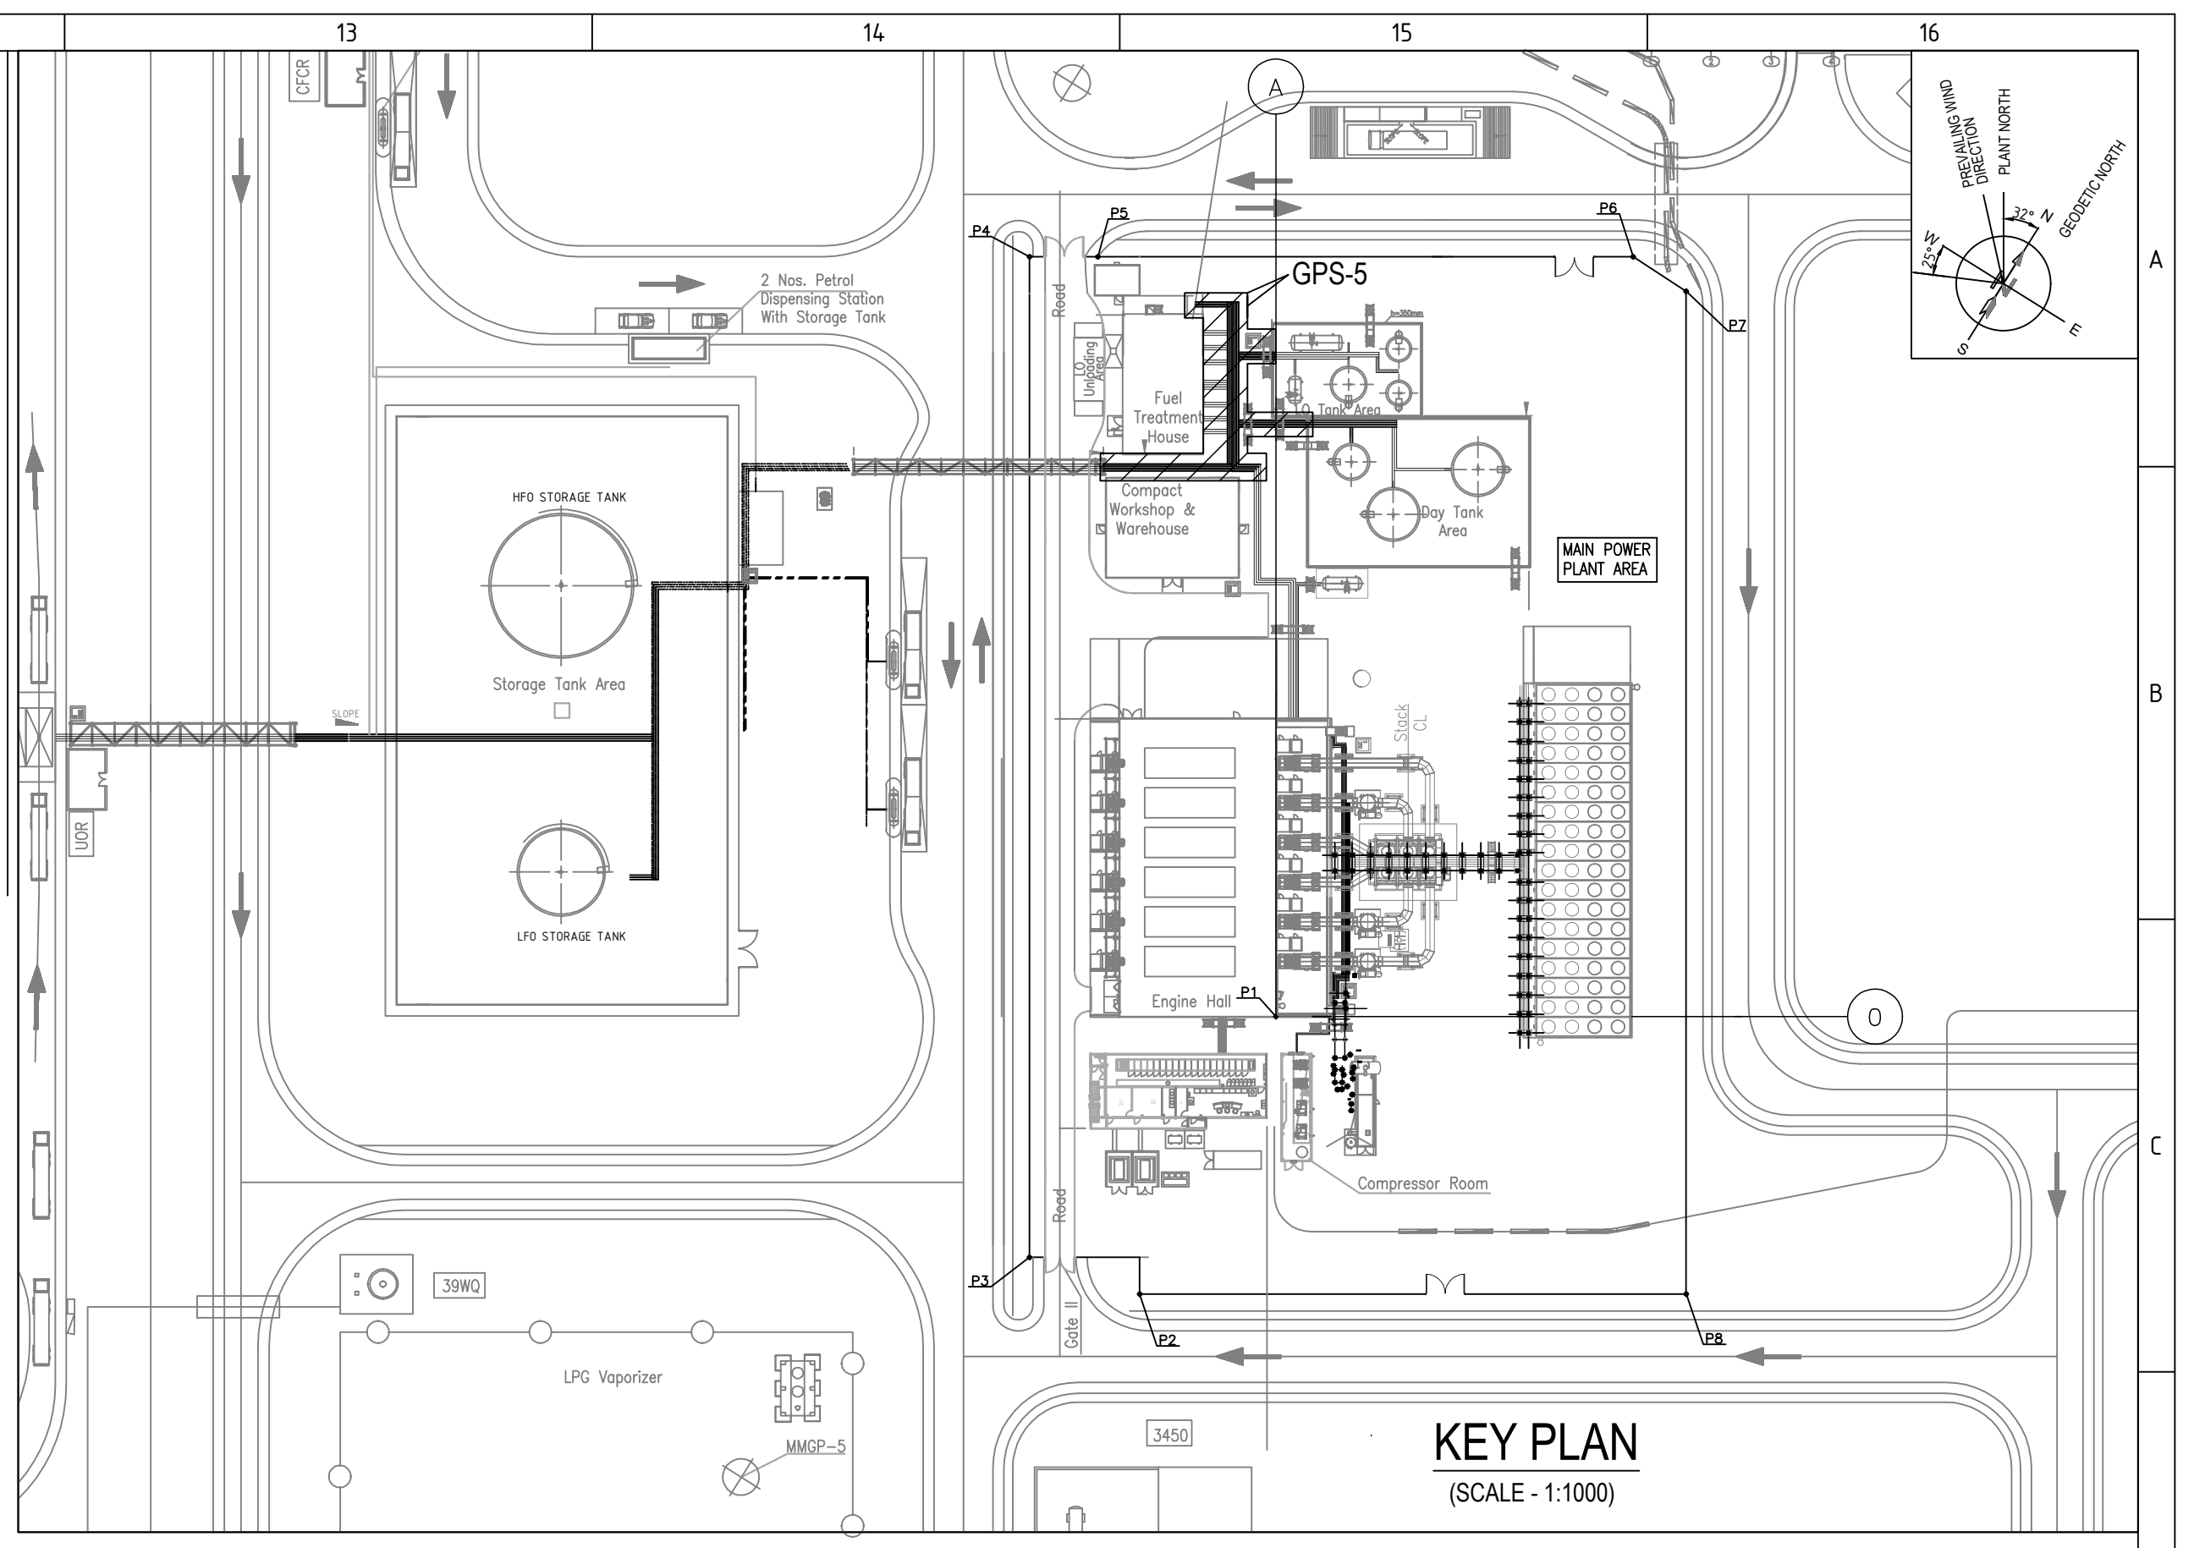

KEY PLAN

(SCALE - 1:1000)

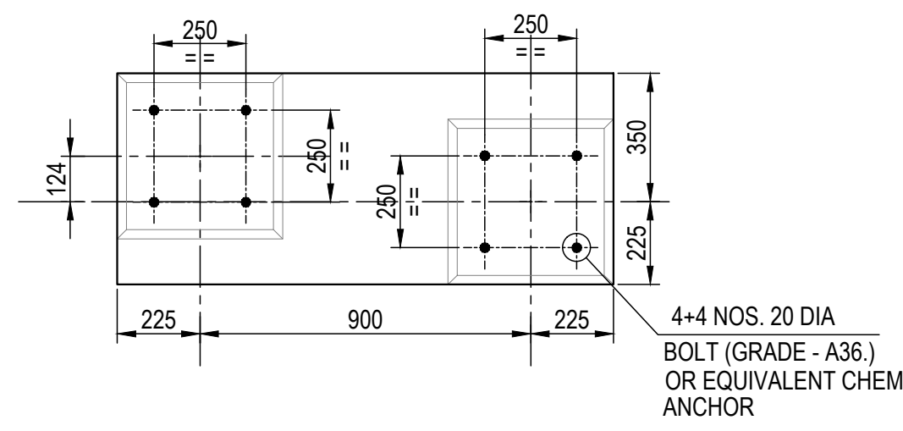

BOLT ARRANGEMENT DETAIL OF PEDESTAL MKD. P10

(SCALE- 1:20)

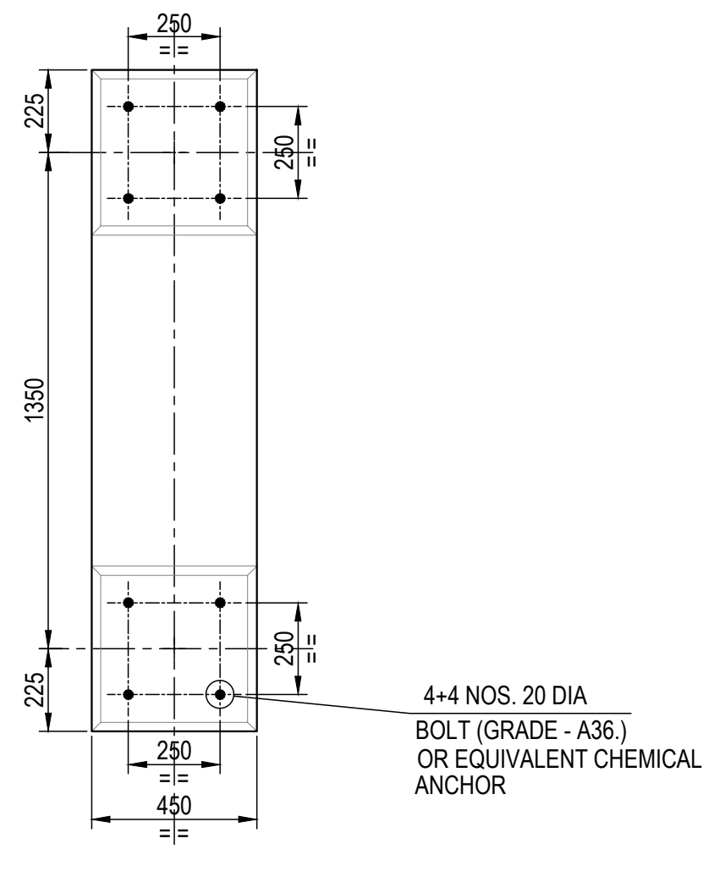

BOLT ARRANGEMENT DETAIL OF PEDESTAL MKD. P4 (TYP.)

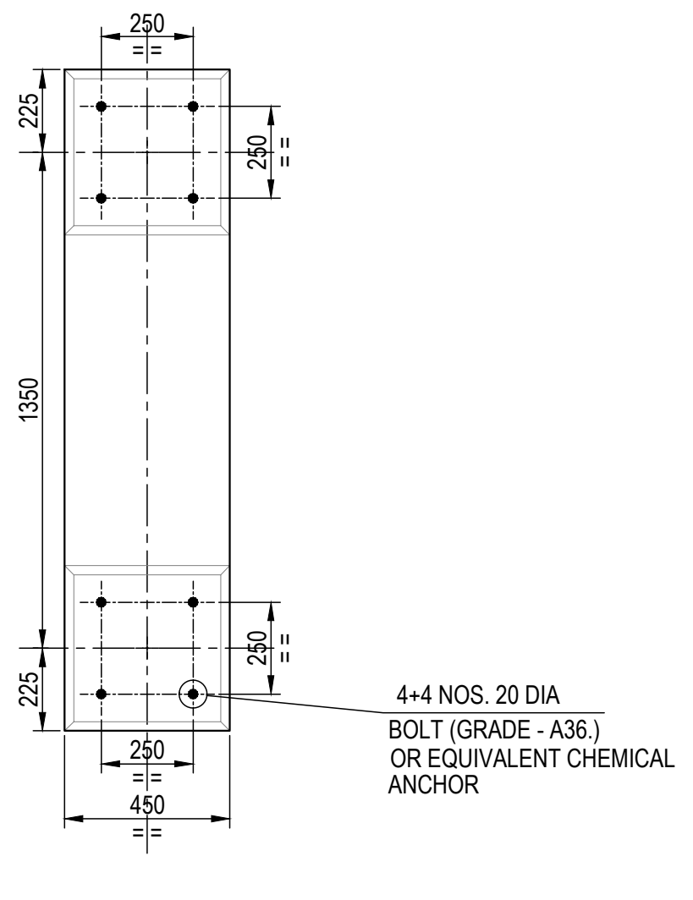

BOLT ARRANGEMENT DETAIL OF PEDESTAL MKD. P5 (TYP.)

(SCALE- 1:20)

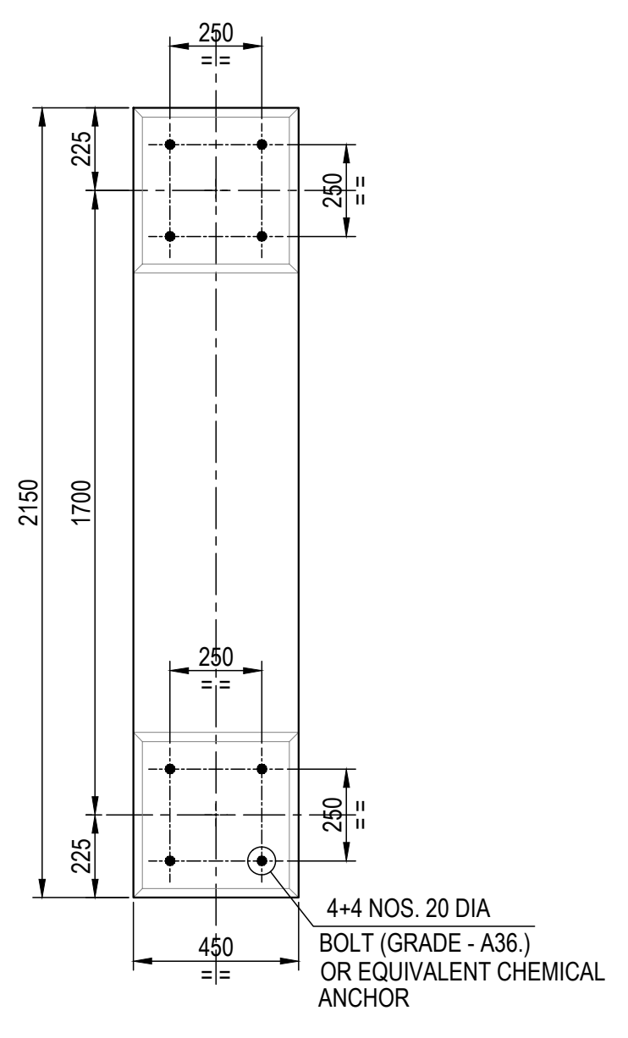

BOLT ARRANGEMENT DETAIL OF PEDESTAL MKD. P8

(SCALE- 1:20)

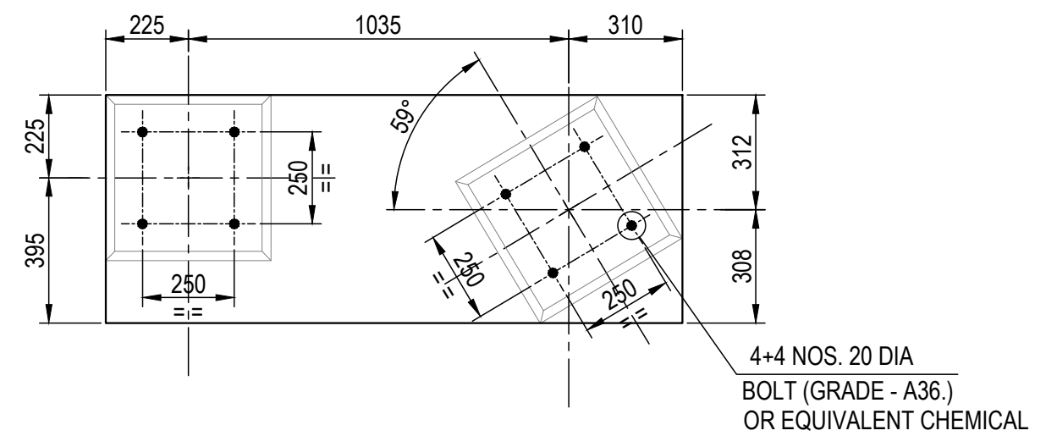

BOLT ARRANGEMENT DETAIL OF PEDESTAL MKD. P11

(SCALE- 1:20)

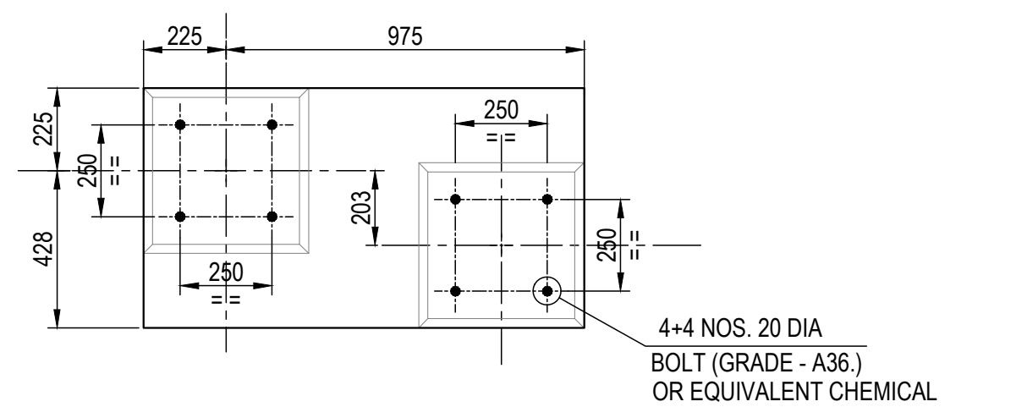

BOLT ARRANGEMENT DETAIL OF PEDESTAL MKD. P12

(SCALE- 1:20)

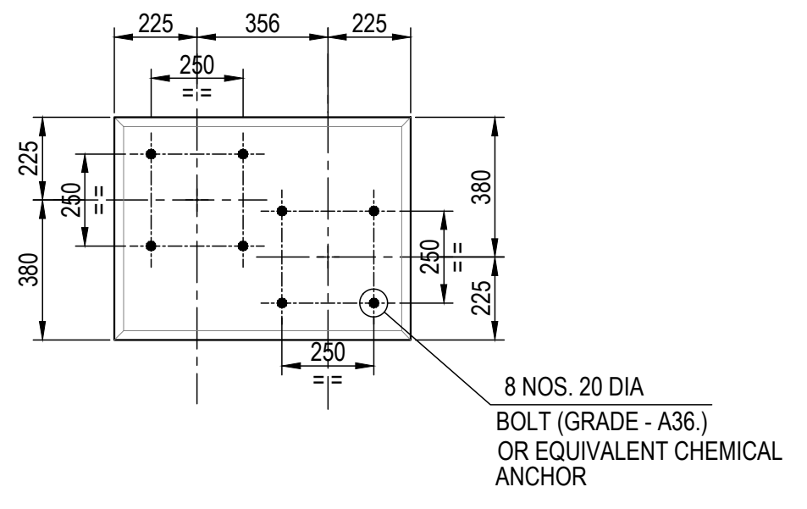

BOLT ARRANGEMENT DETAIL OF PEDESTAL MKD. P13

(SCALE- 1:20)

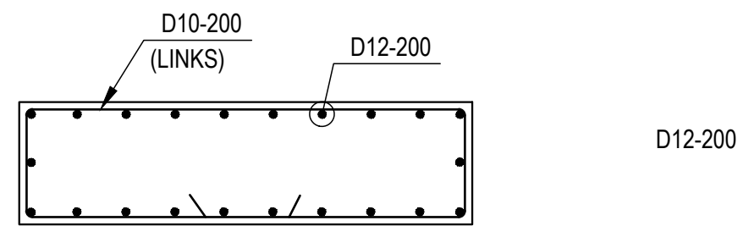

SECTION B-B

(RC DETAIL OF PEDESTAL)

(SCALE 1:30)

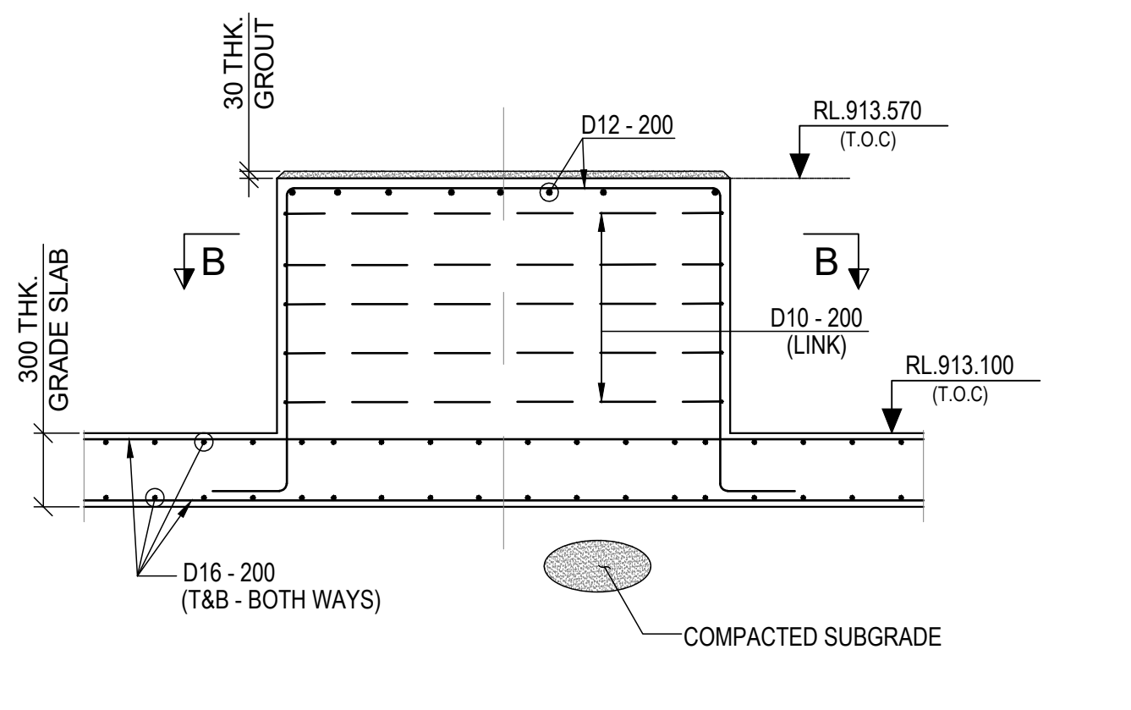

TYP. DETAIL OF PEDESTAL

(SHOWING RC DETAIL)

(SCALE 1:30)

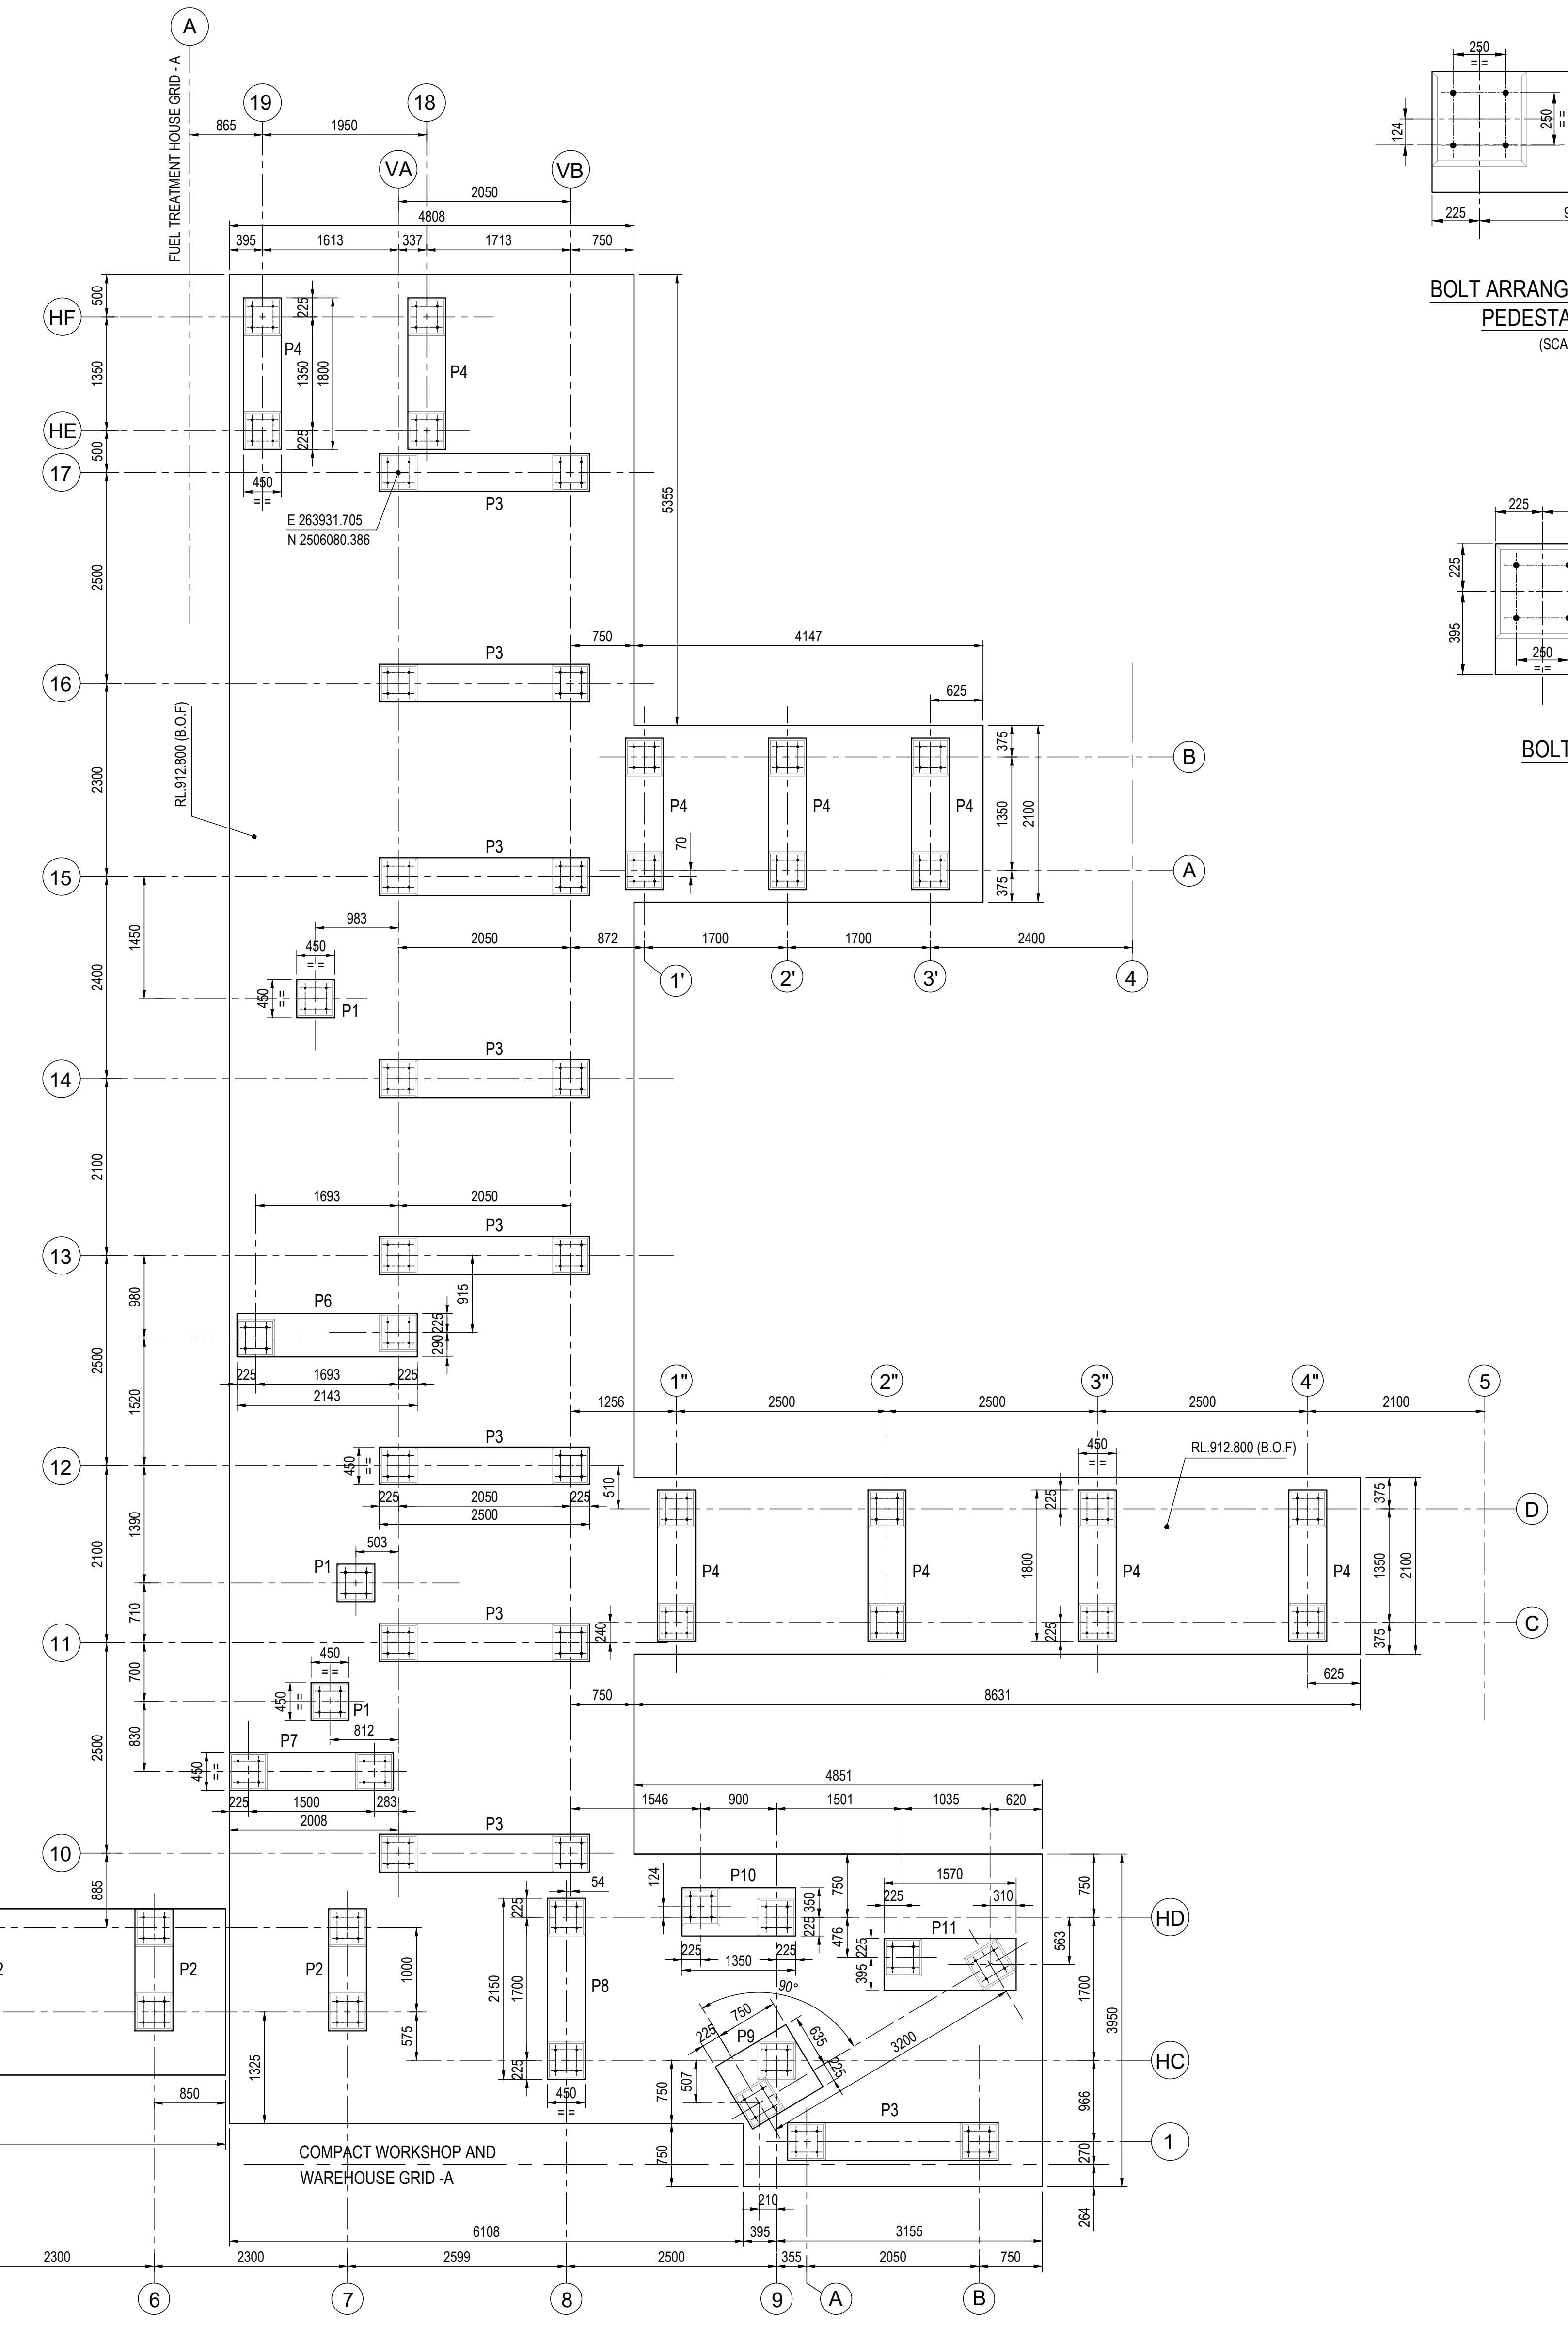

FOUNDATION LAYOUT PLAN AT RL.911.600 B.O.F. (U.N.O.)

(SCALE 1:50)

SCHEDULE OF BOLTS OR EQUIVALENT CHEMICAL ANCHOR

AREA	BOLT DIA. (MM)	BOLT NUMBERS REQUIRED
GPS-5	20	268

LEGEND :-

TOC = TOP OF CONCRETE
BOC = BOTTOM OF CONCRETE
FGL = FINISHED GROUND LEVEL
BOF = BOTTOM OF FOUNDATION
TYP = TYPICAL
MKD = MARKED
℄ = CENTRE LINE
THK = THICK
GA = GENERAL ARRANGEMENT.
RC = REINFORCED CONCRETE
PCC = PLAIN CEMENT CONCRETE
DIA = DIAMETER
RL = REDUCED LEVEL
T&B = TOP & BOTTOM
SBC = SAFE BEARING CAPACITY
UNO = UNLESS NOTED OTHERWISE

NOTES :-

1. ALL DIMENSIONS ARE IN MILLIMETRES AND LEVELS AND CO-ORDINATES ARE IN METRES UNLESS OTHERWISE STATED.
2. GRADE OF CONCRETE SHALL BE 35 MPa FOR FOUNDATION & 15 MPa FOR BLINDING CONCRETE.
3. GRADE OF REINFORCEMENT SHALL BE DEFORMED BAR 420 MPa (GRADE 60) - ASTM A615/A615M.
4. NET SAFE BEARING CAPACITY OF SOIL AT BOTTOM OF FOUNDATION CONSIDERED 100 KN/ SQ. M.
5. REINFORCEMENT SHALL BE SUITABLY ADJUSTED AT SITE TO CLEAR POCKETS, BOLTS ETC.
6. IF ANY PART OF FOUNDATION COMES ON BACKFILL ZONE OF ADJACENT FOUNDATION OR ANY LOOSE SOIL ARE ENCOUNTERED BELOW FOUNDATION LEVEL THE SAME SHALL BE REMOVED AND FILLED WITH PCC.
7. FOR ALL OTHER NOTES REFER DRAWING NO. MD-101-SMEM-EG-ST-DST-0001 TO 0008.
8. FOR GENERAL NOTES OF CIVIL WORKS & STANDARD REINFORCEMENT DETAIL REFER DRAWING NO. MD-216-1000-EG-CV-DED-1001 & 1005.

DOCUMENT NUMBER	REFERENCE DOCUMENTS	REV	DATE	REVISION DESCRIPTION	DRN	CHK	ENG	APP	EMP
MD-216-49PR-EG-ST-GAD-2426	DETAIL OF PIPE SUPPORT GPS-5,								

DOCUMENT NUMBER	REFERENCE DOCUMENTS	REV	DATE	REVISION DESCRIPTION	DRN	CHK	ENG	APP	EMP
		D01	17/02/2023	AS-BUILT	SYA	UR	SVK	AG	
		C04	13/02/2021	ISSUED FOR CONSTRUCTION & REVISED AS MARKED C04	SYA	UR	SVK	AG	
		C03	22/01/2021	ISSUED FOR CONSTRUCTION & REVISED AS MARKED C03	ABH	UR	SVK	AG	
		C02	08/12/2020	ISSUED FOR CONSTRUCTION & REVISED AS MARKED C02	ABH	UR	SVK	AG	
		C01	19/11/2020	ISSUED FOR CONSTRUCTION & REVISED AS MARKED C01	SWB	UR	SVK	AG	
		A01	15/10/2020	ISSUED FOR REFERENCE	ABH	UR	SVK	AG	

RESERVED FOR VENDOR LOGO AND DRAWING NUMBER

LARSEN & TOUBRO

This drawing is the property of LARSEN & TOUBRO and must not be passed on to any person or body not authorized by us to receive it nor be copied or otherwise made use either in full or in part by such person or body without our prior permission in writing.

Outotec

The content of these documents are the sole property of Outotec Oyj. Any rights not expressly granted herein are reserved. Reproduction, transfer or distribution of part or all of the contents in any form without prior written permission of Outotec is prohibited.

MA'ADEN معادن
Saudi Arabian Mining Company شركة التعدين العربية السعودية

This document and the information contained herein is Ma'aden proprietary know-how. This document or any part thereof should not be reproduced, stored in a retrieval system or transmitted by any means, electronic or otherwise, or divulged without prior written permission of Ma'aden.

LARSEN & TOUBRO DRAWING NUMBER: 019045_008_C_G_24380_003 — REVISION 5
OUTOTEC DRAWING NUMBER: 900707 __GAU01 __WG01__MTL01 __45127 — DOCUMENT ID: OU100697487 — REVISION 5

DRAWN	ABH	03/10/2020
CHECKED	UR	12/10/2020
ENGINEER	SVK	03/10/2020
APPROVED	AG	15/10/2020
EMPLOYER		
SCALE	1:100	A0

MANSOURAH - MASSARAH GOLD PROJECT
GENERAL ARRANGEMENT
POWER PLANT PIPE RACK
G.A. AND DETAIL OF FOUNDATION FOR GPS- 5

DRAWING NUMBER: MD - 216 - 49PR - EG - CV - GAD - 2030
REV: D01