


DRAWING NUMBER: MD - 216 - 49PR - EG - CV - GAD - 2033
REV: D01

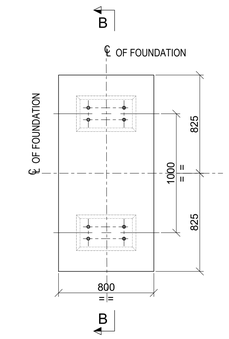


FOUNDATION MKD. F1
(SCALE - 1:25)

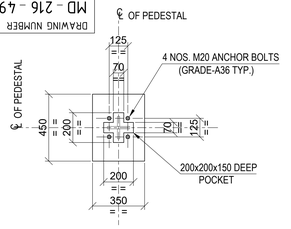


VIEW : 2- 2
(TYP. DETAIL OF PEDESTAL MKD. P1)
(SCALE- 1:20)

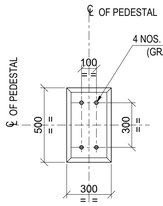


VIEW : 1 - 1
(TYP. DETAIL OF PEDESTAL MKD. P2)
(SCALE- 1:20)

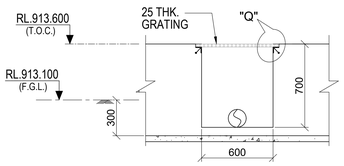


SECTION F-F
(SCALE - 1:25)

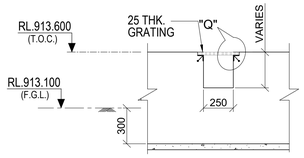


SECTION G-G
(SCALE - 1:25)

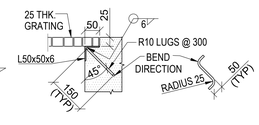


DETAIL - Q
(SCALE 1:10)

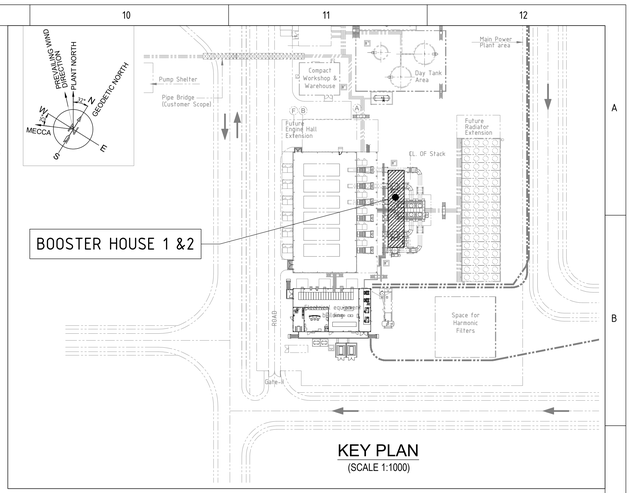


KEY PLAN
(SCALE 1:1000)

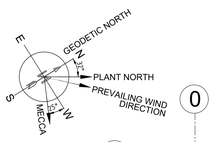


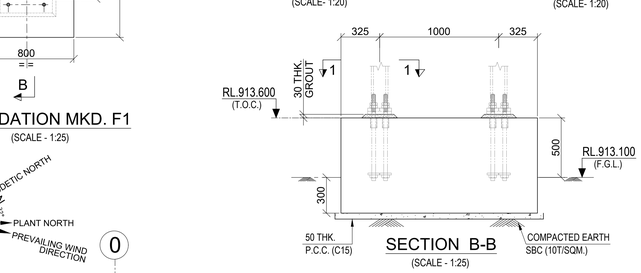


SECTION B-B
(SCALE - 1:25)

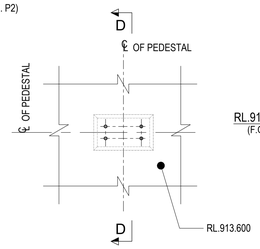


PEDESTAL MKD. P2
(SCALE - 1:25)

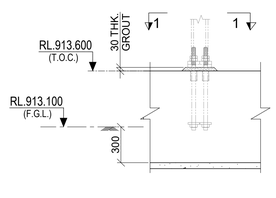


SECTION D-D
(SCALE - 1:25)

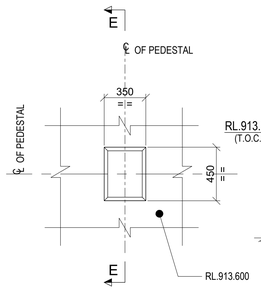


PEDESTAL MKD. P1
(SCALE - 1:25)

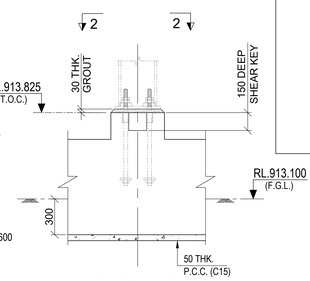


SECTION E-E
(SCALE - 1:25)

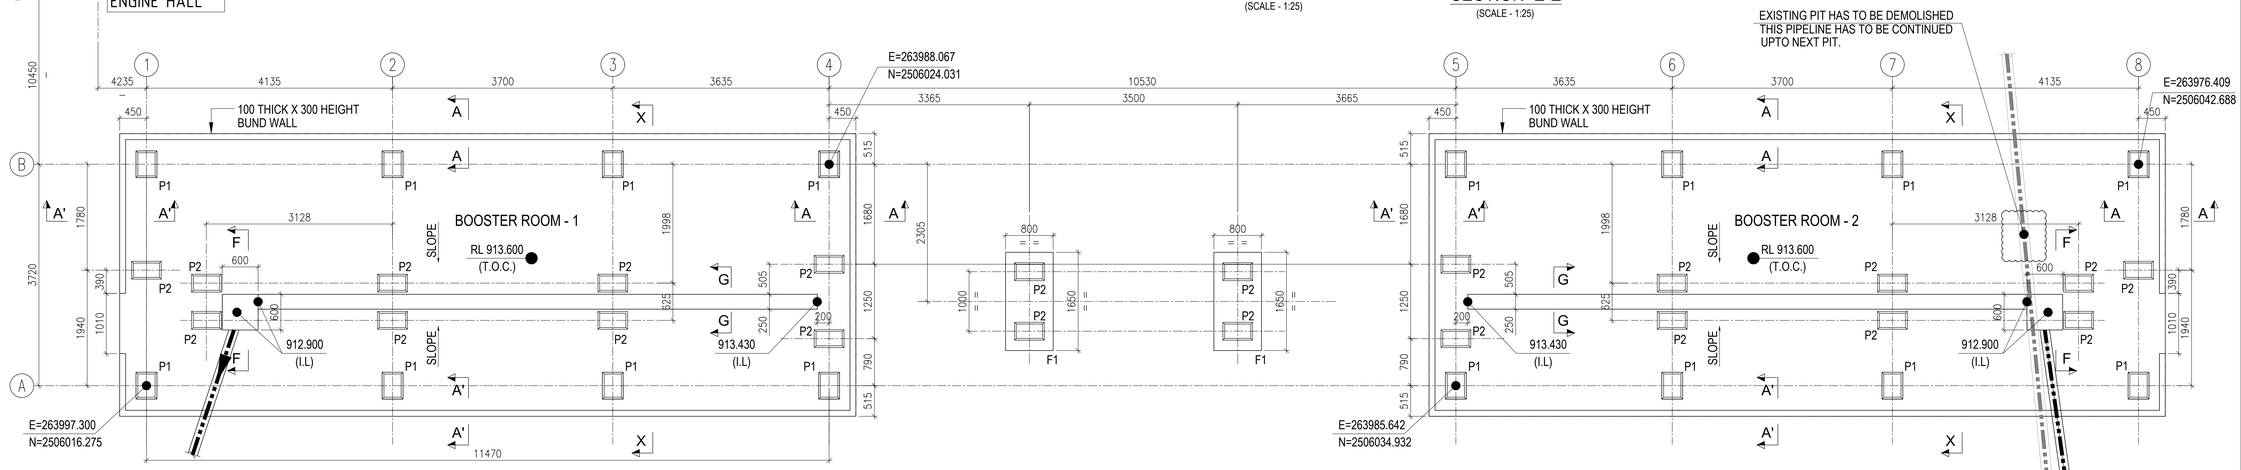

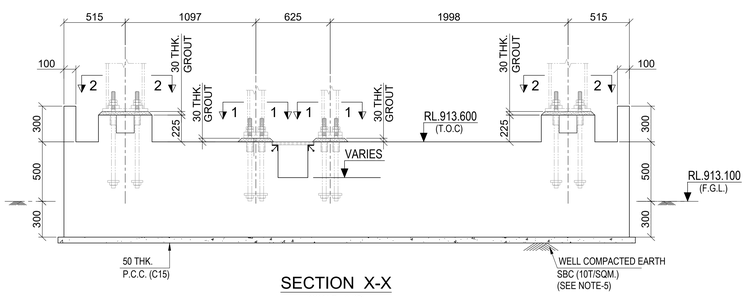

SECTION X-X
(SCALE - 1:25)

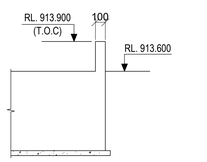

SECTION A-A
SECTION A'-A' (OPPOSITE HAND)
SCALE 1:30

FOUNDATION LAYOUT FOR BOOSTER HOUSE 1 & 2
(SCALE 1:50)

LEGEND :-

RL - REDUCED LEVEL.
T.O.C. - TOP OF CONCRETE.
F.G.L. - FINISHED GROUND LEVEL.
B.O.F. - BOTTOM OF FOOTING.
℄ - CENTRE LINE.
TYP. - TYPICAL.
THK. - THICK.
MKD. - MARKED.
G.A. - GENERAL ARRANGEMENT.
P.C.C. - PLAIN CEMENT CONCRETE.

NOTES :-

1. ALL DIMENSIONS ARE IN MILLIMETRES AND LEVELS AND CO-ORDINATES ARE IN METRES. UNLESS OTHERWISE STATED.
2. GRADE OF CONCRETE SHALL BE 35 MPa FOR FOUNDATION & 15 MPa FOR BLINDING CONCRETE.
3. GRADE OF REINFORCEMENT SHALL BE DEFORMED BAR 420 MPa (GRADE 60) - ASTM A615/A615M.
4. NET SAFE BEARING CAPACITY OF SOIL AT BOTTOM OF FOUNDATION CONSIDER 100KN/ SQ. M.
5. IF ANY PART OF FOUNDATION COMES ON BACKFILL ZONE OF ADJACENT FOUNDATION OR ANY LOOSE SOIL ARE ENCOUNTERED BELOW FOUNDATION LEVEL THE SAME SHALL BE REMOVED AND FILLED WITH PCC.
6. FOR GENERAL NOTES OF CIVIL WORKS & STANDARD REINFORCEMENT DETAIL REFER DRAWING NO. MD-216-1000-EG-CV-DED-1001 & 1005.
7. FOR ANCHOR BOLT DETAILS REFER DRAWING NUMBER MD-216-1000-EG-CV-DED-1003
8. THIS DRAWING SHALL BE READ IN CONJUNCTION WITH DRAWING NUMBER MD-216-49PR-EG-CV-GAD-2034.

DOCUMENT NUMBER	REFERENCE DOCUMENTS	REV	DATE	REVISION DESCRIPTION	DRN	CHK	ENG	APP	EMP
MD-216-49PR-EG-ST-GAD-2438	PLAN, SECTION & ELEVATION								
MD-216-49PR-EG-ST-GAD-2437	PLAN, SECTION & ELEVATION								
MD-216-49PR-EG-ST-GAD-2436	GA & DETAIL OF PLATFORM								
MD-216-49PR-EG-CV-GAD-2034	R.C DETAILS OF FOUNDATION								
MD-216-1000-EG-CV-DED-1003	ANCHOR BOLT STANDARD DETAILS								
MD-216-1000-EG-CV-DED-1003	ANCHOR BOLT STANDARD DETAILS	D01	17/02/2023	AS-BUILT	SYA	SJM	AVG	AG	
MD-216-1000-EG-ST-CRT-1001	CIVIL, STRUCTURAL & ARCHITECTURAL-DESIGN CRITERIA	C01	23/08/2021	ISSUED FOR CONSTRUCTION	SYA	SJM	AVG	AG	
MD-216-49PR-EG-ME-LAD-V553-1002	LAYOUT OF POWER GENERATION	A01	05/08/2021	ISSUED FOR APPROVAL	SYA	SJM	AVG	AG	

RESERVED FOR VENDOR LOGO AND DRAWING NUMBER

LARSEN & TOUBRO

This drawing is the property of LARSEN & TOUBRO and must not be passed on to any person or body not authorized by us to receive it nor be copied or otherwise made use either in full or in part by such person or body without our prior permission in writing.

Outotec

The content of these documents are the sole property of Outotec Oyj. Any rights not expressly granted herein are reserved. Reproduction, transfer or distribution of part or all of the contents in any form without prior written permission of Outotec is prohibited.

MA'ADEN معادن
Saudi Arabian Mining Company شركة معادن العربية السعودية

This document and the information contained herein is Ma'aden proprietary know-how. This document or any part thereof should not be reproduced, stored in a retrieval system or transmitted by any means, electronic or otherwise, or divulged without prior written permission of Ma'aden.

LARSEN & TOUBRO DRAWING NUMBER: 019045_008_C_G_24700_001 — REVISION: 2
OUTOTEC DRAWING NUMBER: 900707__GAU01__WG01__MTL01__49050 — DOCUMENT ID: OU100729275 — REVISION: 2

DRAWN	SYA	03/08/2021
CHECKED	SJM	04/08/2021
ENGINEER	AVG	03/08/2021
APPROVED	AG	05/08/2021
EMPLOYER		
SCALE	1:50,25,10	A1

MANSOURAH - MASSARAH GOLD PROJECT
GENERAL ARRANGEMENT DRAWING
POWER GENERATION: BOOSTER HOUSE
LAYOUT & DETAILS OF FOUNDATION

DRAWING NUMBER: MD - 216 - 49PR - EG - CV - GAD - 2033 — REV: D01