




SECTION C-C
(SCALE - 1:25)

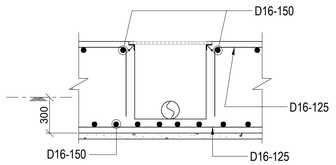


SECTION F-F
(R.C DETAILS)
(SCALE - 1:25)

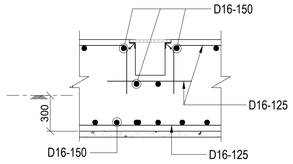


SECTION G-G
(R.C DETAILS)
(SCALE - 1:25)

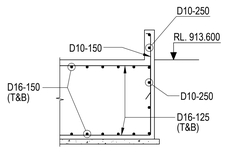


SECTION A-A
SECTION A'-A' (OPPOSITE HAND)
(R.C DETAIL)
SCALE 1:30

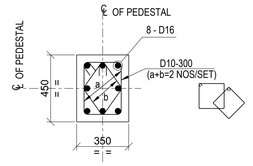


SECTION : 3 - 3
(TYP. RC DETAIL OF PEDESTAL MKD. P1)
(SCALE- 1:20)

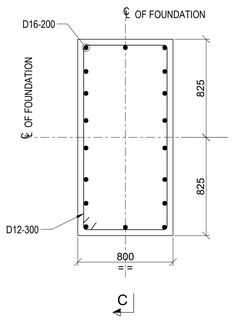

RC DETAIL OF FOUNDATION MKD. F1
(2 NO. REQUIRED)
(SCALE - 1:50)

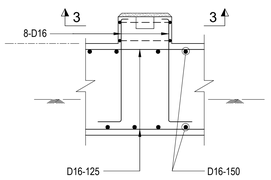

SECTION E-E
(R.C DETAILS)
(SCALE - 1:25)

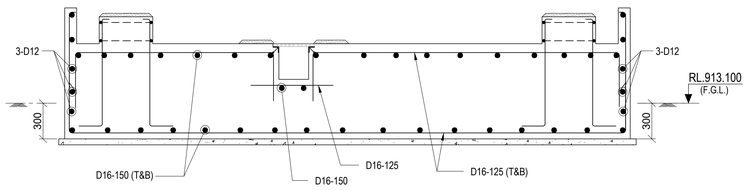

SECTION X-X
(SCALE - 1:25)

LEGEND :-

RL. - REDUCED LEVEL.
T.O.C. - TOP OF CONCRETE.
F.G.L. - FINISHED GROUND LEVEL.
B.O.F. - BOTTOM OF FOOTING.
℄ - CENTRE LINE.
TYP. - TYPICAL.
THK. - THICK.
MKD. - MARKED.
G.A. - GENERAL ARRANGEMENT.
R.C. - REINFORCED CONCRETE.
P.C.C. - PLAIN CEMENT CONCRETE.
T - TOP.
B - BOTTOM.

NOTES :-

1. ALL DIMENSIONS ARE IN MILLIMETRES AND LEVELS AND CO-ORDINATES ARE IN METRES. UNLESS OTHERWISE STATED.
2. GRADE OF CONCRETE SHALL BE 35 MPa FOR FOUNDATION & 15 MPa FOR BLINDING CONCRETE.
3. GRADE OF REINFORCEMENT SHALL BE DEFORMED BAR 420 MPa (GRADE 60) - ASTM A615/A615M.
4. NET SAFE BEARING CAPACITY OF SOIL AT BOTTOM OF FOUNDATION CONSIDER 100KN/ SQ. M.
5. CLEAR COVER TO MAIN REINFORCEMENT SHALL BE 75 mm FOR RAFT & 50 mm FOR COLUMN.
6. IF ANY PART OF FOUNDATION COMES ON BACKFILL ZONE OF ADJACENT FOUNDATION OR ANY LOOSE SOIL ARE ENCOUNTERED BELOW FOUNDATION LEVEL THE SAME SHALL BE REMOVED AND FILLED WITH PCC.
7. GENERAL NOTES FOR CIVIL WORKS & STANDARD REINFORCEMENT DETAIL REFER DRAWING NO. MD-216-1000-EG-CV-DED-1001 & 1005.
8. THIS DRAWING SHALL BE READ IN CONJUNCTION WITH DRAWING NUMBER MD-216-49PR-EG-CV-GAD-2033.

DOCUMENT NUMBER	REFERENCE DOCUMENTS	REV	DATE	REVISION DESCRIPTION	DRN	CHK	ENG	APP	EMP
		D01	17/02/2023	AS-BUILT	SYA	SJM	AVG	AG	
		C01	23/08/2021	ISSUED FOR CONSTRUCTION	SYA	SJM	AVG	AG	
MD-216-49PR-EG-CV-GAD-2033	LAYOUT & DETAILS OF FOUNDATION	A01	05/08/2021	ISSUED FOR APPROVAL	SYA	SJM	AVG	AG	

RESERVED FOR VENDOR LOGO AND DRAWING NUMBER

LARSEN & TOUBRO DRAWING NUMBER: O19045_008_C_G_24701_001 — REVISION: 2
OUTOTEC DRAWING NUMBER: 900707 __GAU01 __WG01__MTL01 __49051 — DOCUMENT ID: OU100729276 — REVISION: 2

LARSEN & TOUBRO
This drawing is the property of LARSEN & TOUBRO and must not be passed on to any person or body not authorized by us to receive it nor be copied or otherwise made use either in full or in part by such person or body without our prior permission in writing.

Outotec
The content of these documents are the sole property of Outotec Oyj. Any rights not expressly granted herein are reserved. Reproduction, transfer or distribution of part or all of the contents in any form without prior written permission of Outotec is prohibited.

MA'ADEN معادن
Saudi Arabian Mining Company شركة معادن العربية السعودية
This document and the information contained herein is Ma'aden proprietary know-how. This document or any part thereof should not be reproduced, stored in a retrieval system or transmitted by any means, electronic or otherwise, or divulged without prior written permission of Ma'aden.

DRAWN	SYA	03/08/2021
CHECKED	SJM	04/08/2021
ENGINEER	AVG	03/08/2021
APPROVED	AG	05/08/2021
EMPLOYER		
SCALE	1:50,25,10	A1

MANSOURAH - MASSARAH GOLD PROJECT
GENERAL ARRANGEMENT DRAWING
POWER GENERATION: BOOSTER HOUSE
R.C DETAILS OF FOUNDATION

DRAWING NUMBER: MD-216-49PR-EG-CV-GAD-2034 — REV: D01