


DRAWING NUMBER: MD-216-49PR-EG-CV-GAD-2035 | REV: D01

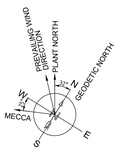


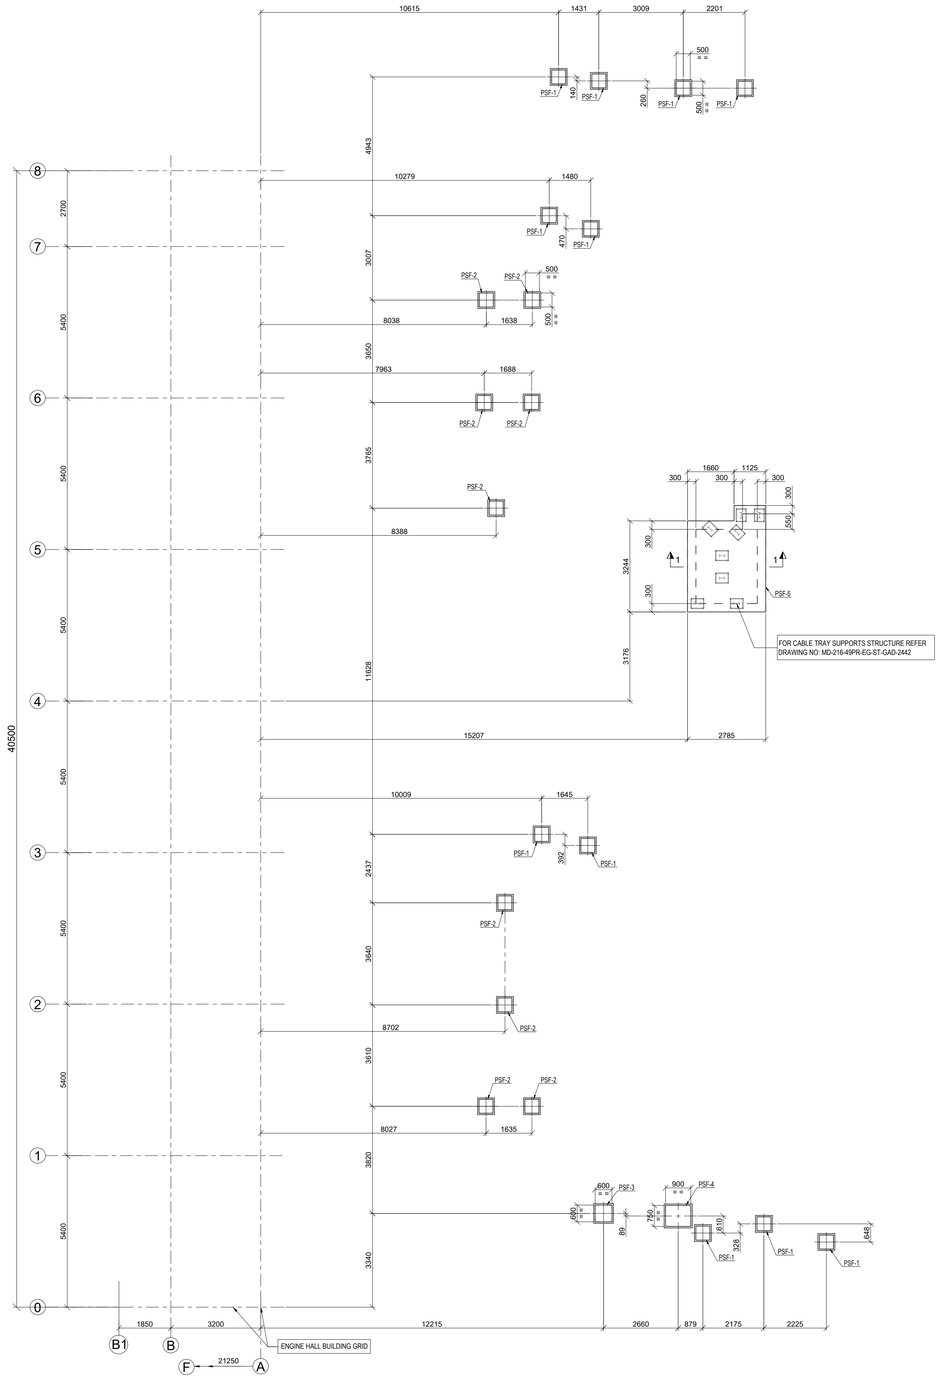


LAYOUT PLAN
(SCALE 1:75)

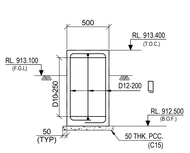


TYP. DETAIL OF PIPE SUPPORT FDN. MKD. PSF-1
SCALE 1:25

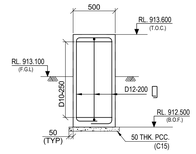


TYP. DETAIL OF PIPE SUPPORT FDN. MKD. PSF-2
SCALE 1:25

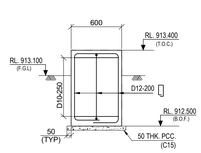

TYP. DETAIL OF PIPE SUPPORT FDN. MKD. PSF-3
SCALE 1:25

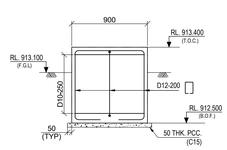

TYP. DETAIL OF PIPE SUPPORT FDN. MKD. PSF-4
SCALE 1:25

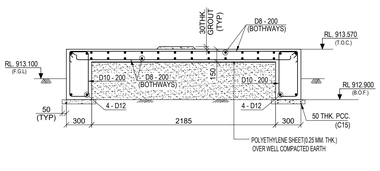

SECTION 1-1
TYP. DETAIL OF PIPE SUPPORT FDN. MKD. PSF-5
SCALE 1:25

LEGENDS :-

R.L. - REDUCED LEVEL
℄ - CENTRE LINE
T.O.S. - TOP OF STEEL
TYP. - TYPICAL
MKD - MARKED.
THK. - THICK
U/S B.P. - UNDER SIDE OF BASE PLATE
T.O - TOP OF
STIFF - STIFFENER
EQ - EQUAL
DIA - DIAMETER
PL - PLATE
Ø - DIAMETER
B/S - BOTH SIDE
HD - HOLDING DOWN
UNO - UNLESS NOTED OTHERWISE
FDN - FOUNDATION

NOTES:

1. ALL DIMENSIONS ARE IN MILLIMETRES AND LEVELS AND CO-ORDINATES ARE IN METRES UNLESS OTHERWISE STATED.
2. MINIMUM REINFORCED CONCRETE GRADE TO BE USED FOR SUPERSTRUCTURE & SUBSTRUCTURES IS M35(5000 PSI).
3. MINIMUM LEAN CONCRETE GRADE TO BE USED FOR THE SUB-STRUCTURES IS M15(2175 PSI).
4. ALL REINFORCING STEEL SHALL BE DEFORMED BILLET STEEL BARS CONFORMING TO ASTM-A615, WITH MINIMUM YIELD STRENGTH OF FY420 MPA .
5. CLEAR COVER TO REINFORCEMENT SHALL BE AS
   a) FOUNDATION = 50mm
   b WALL & COLUMN = 40mm
   c) SLAB = 25mm
6. THE NET SOIL BEARING CAPACITY CONSIDERED IN FOUNDATION DESIGN IS 100 KPA(REFER DOC 216-3000-EG-CV-CAL-1008-A02).
7. WATER PROOFING INSULATION SHALL BE AS PER PROJECT SPECS AND ITS MATERIAL TO BE APPROVED BY ENGINEER ON SITE.
8. FOR STANDARD REINFORCEMENT DETAIL & GENERAL NOTES FOR CIVIL WORKS REFER DRAWING NO. MD-216-1000-EG-CV-DED-1005 &1001.

DOCUMENT NUMBER	REFERENCE DOCUMENTS	REV	DATE	REVISION DESCRIPTION	DRN	CHK	ENG	APP	EMP
MD-216-49PR-EG-ST-GAD-2442	POWER PLANT - CABLE TRAY SUPPORTS STRUCTURE	D01	17/02/2023	AS-BUILT	PML	SJM	AVG	AG	
	PLAN, ELEVATION & SECTION	C01	22/02/2022	ISSUED FOR CONSTRUCTION AND REVISED AS PER EMPLOYER	PML	SJM	AVG	AG	
MD-216-49PR-EG-ST-GAD-2439	POWER PLANT - MISCELLANEOUS PIPE SUPPORTS			COMMENTS ON 19/02/2022 AND REVISED AS MARKED (CC01)	PML	SJM	AVG	AG	
	PLAN, ELEVATION & SECTION	A01	04/01/2022	ISSUED FOR APPROVAL	PML	SJM	AVG	AG	

DOCUMENT NUMBER	REFERENCE DOCUMENTS	REV	DATE	REVISION DESCRIPTION	DRN	CHK	ENG	APP	EMP

RESERVED FOR VENDOR LOGO AND DRAWING NUMBER

LARSEN & TOUBRO

This drawing is the property of LARSEN & TOUBRO and must not be passed on to any person or body not authorized by us to receive it nor be copied or otherwise made use either in full or in part by such person or body without our prior permission in writing.

Outotec

The content of these documents are the sole property of Outotec Oyj. Any rights not expressly granted herein are reserved. Reproduction, transfer or distribution of part or all of the contents in any form without prior written permission of Outotec is prohibited.

MA'ADEN معادن
Saudi Arabian Mining Company شركة المعادن العربية السعودية

This document and the information contained herein is Ma'aden proprietary know-how. This document or any part thereof should not be reproduced, stored in a retrieval system or transmitted by any means, electronic or otherwise, or divulged without prior written permission of Ma'aden.

LARSEN & TOUBRO DRAWING NUMBER: 019045_008_C_G_24704_001 | REVISION: 2
OUTOTEC DRAWING NUMBER: 900707__GAU01__WG01_MTL01__49061 | DOCUMENT ID: OU100738547 | REVISION: 2

DRAWN	PML	18/12/2021
CHECKED	SJM	20/12/2021
ENGINEER	AVG	18/12/2021
APPROVED	AG	04/01/2022
EMPLOYER		
SCALE	1:100,50,20,10	A0

MANSOURAH - MASSARAH GOLD PROJECT
GENERAL ARRANGEMENT DRAWING
POWER PLANT - MISCELLANEOUS PIPE SUPPORTS
FOUNDATION LAYOUT PLAN & DETAIL

DRAWING NUMBER: MD-216-49PR-EG-CV-GAD-2035 | REV: D01