MA'ADEN معادن

Saudi Arabian Mining Company شركة التعدين العربية السعودية

Project **Mansourah Massarah Gold Project**

Customer: **MA'ADEN GOLD AND BASE METALS (MA'ADEN)**

Title: **GENERAL ARRANGEMENT DRAWING 49PR POWER GENERATION SLUDGE SYSTEM - OILY WATER / SLUDGE TRANSFER PUMP UNIT - MANUAL**

Document Number: **MD-216-49PR-EG-ME-GAD-V553-1026**

Revision: **D01**

Revision Date: **28.11.2023**


Status: **AS-BUILT**


Outotec Document Number:	900707	GAU01	WG01	MTL01	45016	OU100677297	1
L&T Document Number:	O19045	008	M	V	12147	001	2


WÄRTSILÄ Wärtsilä Finland Oy Energy Business	Wartsila Document Number :
	DBAF509458

REVISION HISTORY

Rev	Date	Revision Text	Prepared By	Reviewed By	Approved By	Employer
A01	01.04.2020	FIRST ISSUE	Wartsila	SJK / DBH	NBR	
C01	17.06.2020	ISSUED FOR CONSTRUCTION. REVISED AS PER EMPLOYER COMMENTS DATED 27.04.2020	Wartsila	SJK / DBH	NBR	
D01	28.11.2023	AS-BUILT	NAEW	SJK	NBR	

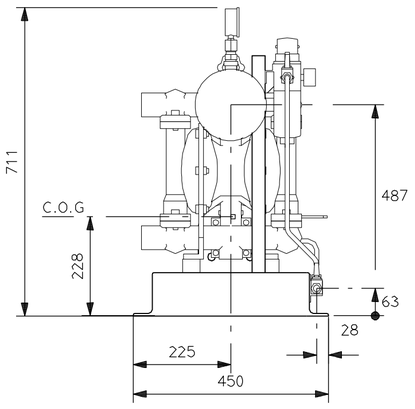

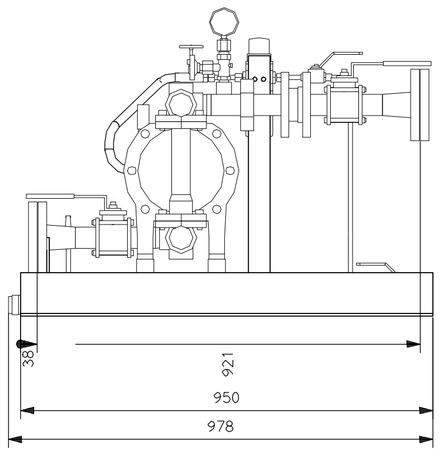

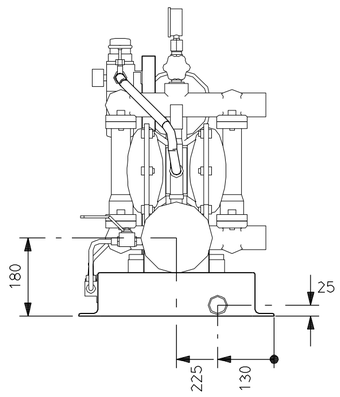

GENERAL INFORMATION

Service	Sludge system
Design category/Hazard category	Non classified
Empty weight/Operation weight	81/97 kg 179/214 lb
EARTHQUAKE LOADS ACCORDING IBC 2000 (See WDAAA242796)	
Fp	0.5 kN
M	0.1 kNm
Vbolt	0.1 kN
Nbolt	no tension

NOZZLE DATA

POS.	DESCRIPTION	SIZE	PN	STD/CLASS	REMARKS
A	Oily water inlet	DN50	PN16	EN1092-1/01	
B	Oily water outlet	DN50	PN16	EN1092-1/01	
C	Drain	R1"	-	-	Threaded
R	Operating air inlet	ø10	-	-	Ermeto

Counter flanges included *No counter flange at standard delivery.
Tolerance in location of connections according to EN-ISO 13920-B

REFERENCE DRAWINGS


Flow diagram:	4V76F4966
Device list:	9076F2727
List of document :	DBAC329446


TRANSPORT DIMENSIONS


Length	978 mm
Width	450 mm
Height	711 mm

FLOW DIAGRAM : MD-216-49PR-EG-PR-PFD-V553-1035

DEVICE LIST : MD-216-49PR-EG-ME-LST-V553-1026

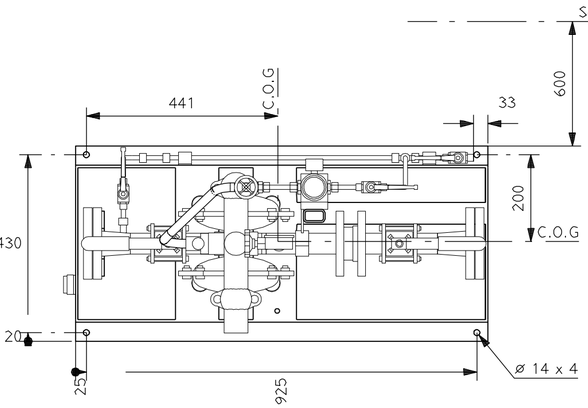

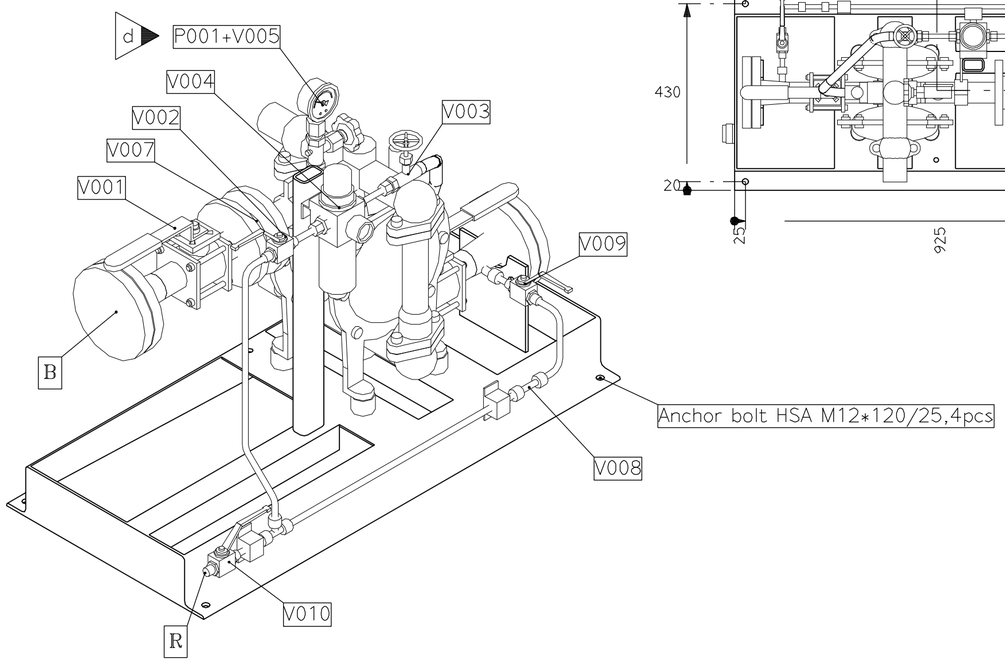

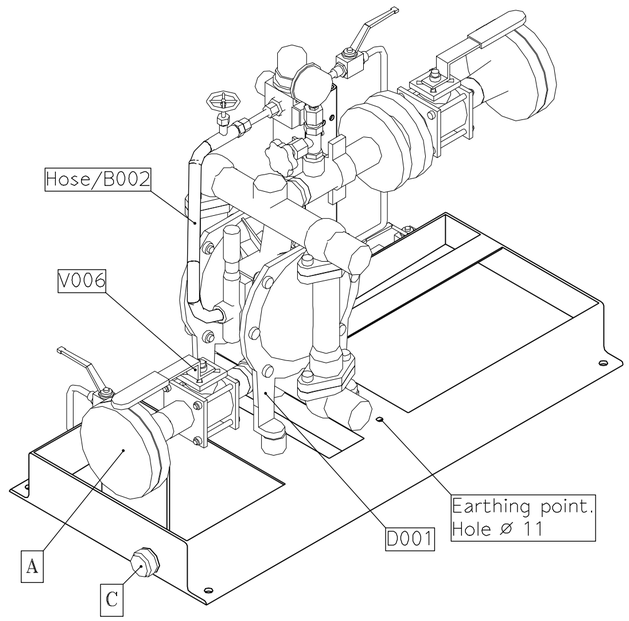

MA'ADEN DRAWING NUMBER : MD-216-49PR-EG-ME-GAD-V553-1026-D01

REV.	DATE	MADE	APPVD.	MEMO NO.	EXPLANATION
d	04-Feb-2016	ZIS	KTH		P001 is changed.
c	12 Aug 2008	PPÄ	VAKA		Air flushing line added & title box update
b	11 Dec 2006	JoEn	MFo		Unit drain moved

WÄRTSILÄ

© Wartsila Finland Oy Energy Solutions

Dimensional drawing

Oily Water / Sludge Transfer Pump Unit

DAD/DDD 901Manual

WFI-P STD

Product: - PDMS ASLY DRG: -

Proj. no. IN024

MADE	27 Aug 2002	VJOK/JOKINEN	Units: mm/kg
CHKD	27 Aug 2002	LSE/SNÅRE	Page No.
APPD	27 Aug 2002	MIJI/JUOPPERI	

Based on Document: – Customer Document: –

Scale: 1:10 Size: A2 Doc. ID: - MOX - /OilyWater/Sludge_TransferPump_Manual WDAAA236768 Rev. d

This drawing is the property of Wartsila and shall neither be copied, shown nor communicated to a third party without the consent of the owner.

Mansourah Massarah Gold Project
Comment Resolution Log Sheet / Compliance Report

PROJECT: MANSOURAH MASSARAH GOLD PROJECT **PROJECT NO.:** 216

STAGE: 4 - PROJECT EXECUTION. **REVIEW LOG DOC. NO. & REV.:**

ACONEX REFERENCE NO. & DATE: MAADEN-STRAN-000075, 27 April 2020

STATUS CODE: A - APPROVED, C - APPROVED WITH COMMENTS, R - REVISE & RESUBMIT & O - OTHERS (INFORMATION, REFERENCE, REVIEWED)

DOCUMENT NUMBER	Area / Title	Comment No.	PMC COMMENT DATE: 27 April 2020	Comment by	EPC Response DATE: 17 June 2020	Status	Remarks
MD-216-49PR-EG-ME-GAD-V553-1026-D01	49PR	1	Please use project drawing numbers.	Bechtel / Ma'aden	Project document numbers for flow diagram and device list against Wartsila's reference document numbers have been incorporated. Balance documents are Wartsila's internal documents and shall not be submitted by Wartsila to Maaden and hence Maaden document numbers for those documents are not applicable.	Closed	
MD-216-49PR-EG-ME-GAD-V553-1026-D01	49PR	2	Please include Equipment Numbers.	Bechtel / Ma'aden	This is OEM standard drawing. For, equipment numbers, please refer to document number MD-216-49PR-EG-ME-LST-V553-1026.	Closed	