MA'ADEN معادن
Saudi Arabian Mining Company شركة التعدين العربية السعودية

Project Mansourah Massarah Gold Project
Customer: MA'ADEN GOLD AND BASE METALS (MA'ADEN)

Title: PROCESS FLOW DIAGRAM
49PR POWER GENERATION
OILY WATER / SLUDGE SYSTEM

Document Number: MD-216-49PR-EG-PR-PFD-V553-1054
Revision: D01
Revision Date: 26.04.2024
Status: AS-BUILT

Outotec Document Number:	900707	GAU01	WG01	PFB01	45005	OU100728744	1
L&T Document Number:	O19045	008	U	V	12045	005	1

WÄRTSILÄ Wärtsilä Finland Oy Energy Business	Wartsila Document Number :
	DECA00003909

REVISION HISTORY

Rev	Date	Revision Text	Prepared By	Reviewed By	Approved By	Employer
A01	14.07.2021	ISSUED FOR APPROVAL	Wartsila	SJK	NBR	
D01	26.04.2024	AS-BUILT	Wartsila	SJK	NBR	

DRAWING NUMBER: MD-216-49PR-EG-PR-PFD-V553-1054 | REV: A01

THE CODES IN THE DIAGRAM ARE DESCRIBED IN DEVICE LIST No: DBAF489728


THE SYMBOLS USED IN DIAGRAM ARE DESCRIBED IN DOCUMENT No: DBAB669467


USE OF (A) (B) ... INDICATE CODING OF TERMINATION POINTS ON UNITS. EVERY UNIT TERMINATION POINT IS MARKED BEFORE SHIPMENT.

MORE DETAILED INFORMATION ABOUT UNIT COMPONENTS WILL BE FOUND IN UNIT/MODULE P&I DIAGRAMS + DEVICE LISTS.

WFI SUPPLY | CLIENT SUPPLY

NORMAL OPERATION.	
V (m³/h)	T (°C)
p (barⓖ)	v (m/s)

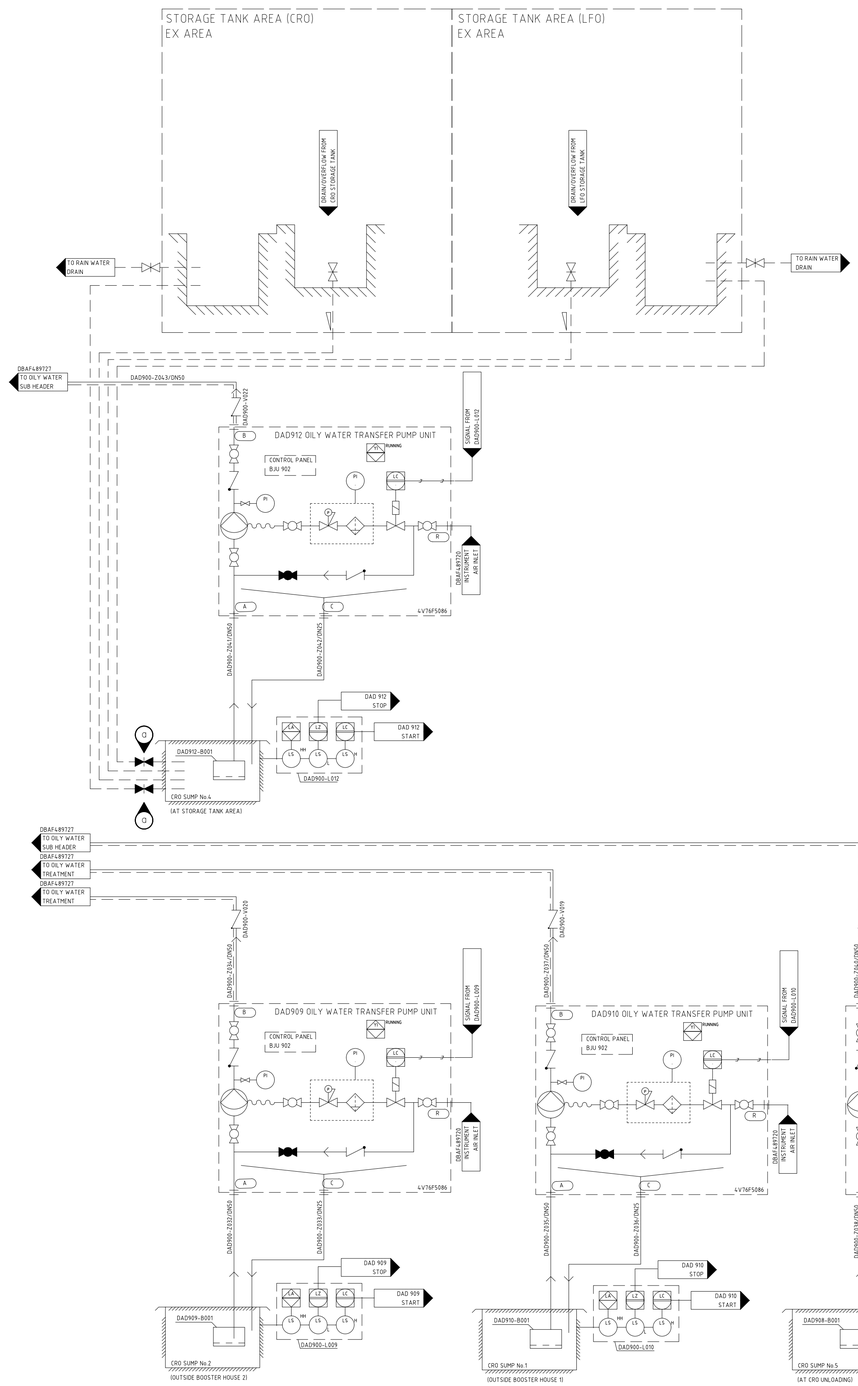

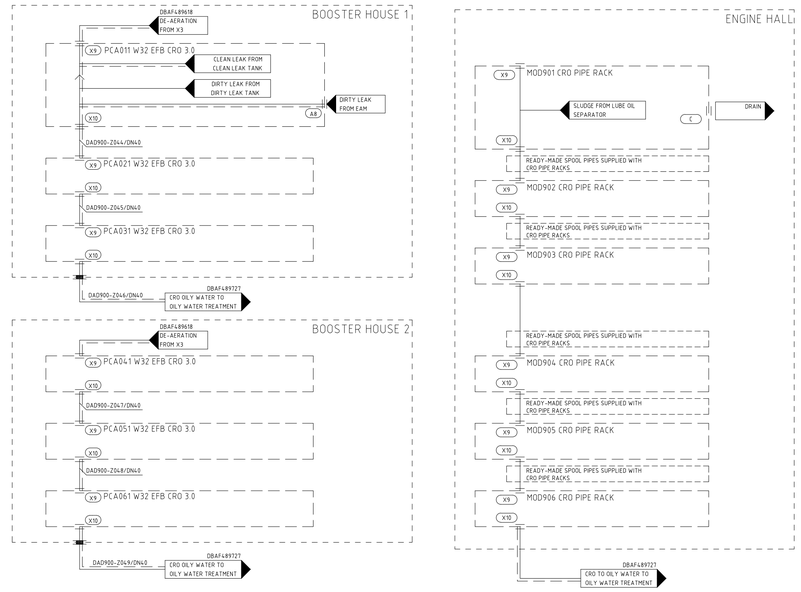

SL NO	WARTSILA DOC NO	MAADEN DOC NO
1	DBAF489727	MD-216-49PR-EG-PR-PFD-V553-1032
2	DBAF489727	MD-216-49PR-EG-PR-PFD-V553-1032

DOCUMENT NUMBER	REFERENCE DOCUMENTS	REV	DATE	REVISION DESCRIPTION	DRN	CHK	ENG	APP	EMP
		D01	26/04/2024	AS-BUILT		SJK		NBR	
		A01	14/07/2021	ISSUED FOR APPROVAL	--	SJK	--	NBR	

WÄRTSILÄ

© Wärtsilä Finland Oy Energy Business

DRAWING NUMBER	REVISION
DECA00003909	a

DATE	05/06/2021	DATE	06/06/2021	DATE	07/06/2021
DRAWN	Jenny Pusula	CHECKED	Joakim Soderling	APPROVED	Giridhar Bh

LARSEN & TOUBRO DRAWING NUMBER: O19045_008_U_V_12045_005 | REVISION: 1

OUTOTEC DRAWING NUMBER: 900707__GAU01__WG01__PFB01__45005 | DOCUMENT ID: OU100728744 | REVISION: 1

LARSEN & TOUBRO

This drawing is the property of LARSEN & TOUBRO and must not be passed on to any person or body not authorized by us to receive it nor be copied or otherwise made use either in full or in part by such person or body without our prior permission in writing.

Outotec

The content of these documents are the sole property of Outotec Oyj. Any rights not expressly granted herein are reserved. Reproduction, transfer or distribution of part or all of the contents in any form without prior written permission of Outotec is prohibited.

MA'ADEN معادن
Saudi Arabian Mining Company شركة المعادن العربية السعودية

This document and the information contained herein is Ma'aden proprietary know-how. This document or any part thereof should not be reproduced, stored in a retrieval system or transmitted by any means, electronic or otherwise, or divulged without prior written permission of Ma'aden.

DRAWN	-	-
CHECKED	SJK	10/07/2021
ENGINEER	-	-
APPROVED	NBR	14/07/2021
EMPLOYER		
SCALE	NTS	A1

MANSOURAH - MASSARAH GOLD PROJECT
PROCESS FLOW DIAGRAM
POWER GENERATION
OILY WATER / SLUDGE SYSTEM

DRAWING NUMBER: MD-216-49PR-EG-PR-PFD-V553-1054 | REV: D01

MA'ADEN معادن
Saudi Arabian Mining Company شركة التعدين العربية السعودية

BECHTEL

Mansourah Massarah Gold Project
Comment Resolution Log Sheet / Compliance Report

Outotec
LARSEN & TOUBRO

PROJECT:	**MANSOURAH MASSARAH GOLD PROJECT**	**PROJECT NO.:**	**216**		
STAGE:	**4 - PROJECT EXECUTION.**	**REVIEW LOG DOC. NO. & REV.:**			
ACONEX REFERENCE NO. & DATE:	MAADEN-STRAN-004092,15 August 2021				
STATUS CODE: A - APPROVED, C - APPROVED WITH COMMENTS, R - REVISE & RESUBMIT & O - OTHERS (INFORMATION, REFERENCE, REVIEWED)					

DOCUMENT NUMBER	Area / Title	Comment No.	PMC COMMENT	Comment by	EPC Response	Status	Remarks
			15-Aug-21				
MD-216-49PR-EG-PR-PFD-V553-1054-A01	49PR	1	Approval is subject to HAZOP review		This is OEM standard item	Closed	
MD-216-49PR-EG-PR-PFD-V553-1054-A01	49PR	2	Project number		Noted.	Closed	
MD-216-49PR-EG-PR-PFD-V553-1054-A01	49PR	3	Please include these documents in reference list		Noted.	Closed	

MA'ADEN معادن

Saudi Arabian Mining Company شركة التعدين العربية السعودية

Project Customer: Mansourah Massarah Gold Project
MA'ADEN GOLD AND BASE METALS (MA'ADEN)

Title: PROCESS FLOW DIAGRAM
49PR POWER GENERATION
OILY WATER / SLUDGE SYSTEM

Document Number: MD-216-49PR-EG-PR-PFD-V553-1032
Revision: D01
Revision Date: 30.04.2024
Status: AS-BUILT

Outotec Document Number:	900707	GAU01	WG01	PFB01	49017	OU100674578	5
L&T Document Number:	O19045	008	U	V	12045	001	5

WÄRTSILÄ Wärtsilä Finland Oy Energy Business	Wartsila Document Number :
	DBAF489727

REVISION HISTORY

Rev	Date	Revision Text	Prepared By	Reviewed By	Approved By	Employer
A01	10.03.2020	ISSUED FOR APPROVAL	Wartsila	SJK / DBH	NBR	
A02	11.09.2020	REVISED AS PER EMPLOYER COMMENTS DATED 02/04/2020.	Wartsila	SJK / DBH	NBR	
A03	29.10.2020	REVISED AS PER EMPLOYER COMMENTS DATED 08/10/2020.	Wartsila	SJK / DBH	NBR	
C01	26.11.2020	ISSUED FOR CONSTRUCTION	Wartsila	SJK / DBH	NBR	
C02	14.07.2021	ISSUED FOR APPROVAL. REVISED DUE TO HFO TO ALCO CONVERSION	Wartsila	SJK	NBR	
D01	30.04.2024	AS-BUILT	Wartsila	SJK	NBR	

DRAWING NUMBER MD-216-49PR-EG-PR-PFD-V553-1032 REV D01

DAY TANK AREA(ALCO AND DIESEL AREA)
EX AREA

DAY TANK AREA(LUBE OIL, SLUDGE AND OILY WATER)
(EX AREA)

THE CODES IN THE DIAGRAM ARE DESCRIBED IN DEVICE LIST No: DBAF489728

THE SYMBOLS USED IN DIAGRAM ARE DESCRIBED IN DOCUMENT No: DBAB669467

USE OF (A) (B) ... INDICATE CODING OF TERMINATION POINTS ON UNITS. EVERY UNIT TERMINATION POINT IS MARKED BEFORE SHIPMENT.

MORE DETAILED INFORMATION ABOUT UNIT COMPONENTS WILL BE FOUND IN UNIT/MODULE P&I DIAGRAMS + DEVICE LISTS.

WFI SUPPLY | CLIENT SUPPLY

NORMAL OPERATION.	
V (m³/h)	T (°C)
p (barg)	v (m/s)

TRACE HEATED AND INSULATED
UNDERGROUND PIPE
PIPE PENETRATING OUTER WALL

a) VALVE LOCATED IN VALVE PIT AND TO BE OPENED SUPERVISED
b) READY MADE AND LOOSE SUPPLY POOL PIPES SUPPLIED WITH EAM

DAB911 OILY WATER TRANSFER PUMP UNIT
DAB901 OILY WATER BUFFER TANK
50 m³ (30.8 m³)
FLOATING ROOF (INTERNAL)
DAB901-L005
DAB901-L006
DAB901-V001
DAB901-L004
DAB901-L002
DAB901-T002
DAB901-T001
DAB901-L011
DAD900-V016 DAD900-V002
DAD900-Z001/DN80
DAD900-Z005/DN80
DAD900-Z007/DN40
DAA900-V009 DAA900-V008
DAD900-V001
DAD900-V010
DAD900-V003
DAD900-Z016/DN80
DAD900-Z029/DN50
DAD900-Z030/DN25
DAD900-Z014/DN80
DAD900-Z028/DN25
DAD900-Z012/DN40
DAD900-Z017/DN80
DAD900-V029 DAD900-V021
DAD900-V023
DAD900-Z050/DN40
DAD900-V024
BLINDED CONNECTION TO FUTURE EXTENSION (EFB 7 DE-AERATION)
DAD900-Z018/DN50
DAD900-Z027/DN80
DAD900-V014
DAD900-V013
DAD900-V030
DAD900-Z026/DN50
DAD900-Z025/DN50
DAD900-Z024/DN50
DAD900-Z023/DN50
DAD900-Z022/DN25
DAD900-Z021/DN25
DAD900-Z037/DN50
DAD900-Z022/DN25
DAD904 OILY WATER TRANSFER PUMP UNIT
DAD907 OILY WATER TRANSFER PUMP UNIT
DAD903 OILY WATER TRANSFER PUMP UNIT
DAD915 OILY WATER TRANSFER PUMP UNIT
DAD915-V001
DAD904-B001
DAD907-B001
DAD903-B002
DAD915-B001
DAD900-L006
DAD900-L007
DAD900-L003
DAD900-L015
OILY WATER SUMP No.4 (OUTSIDE FTH)
OILY WATER SUMP No.5 (UNLOADING AREA)
OILY WATER SUMP No.3 (TRANSFER AREA SHELTER)
ALCO SUMP No.7 (NEAR PIPE BRIDGE 2 OUTSIDE FTH)
DAD911-B001 ALCO SUMP No.3 (OUTSIDE FTH)
4V76F5086
DRAIN/OVERFLOW FROM CDU DAY TANK
DRAIN/OVERFLOW FROM LFO DAY TANK
DRAIN/OVERFLOW FROM LFO BUFFER TANK
DRAIN/OVERFLOW FROM SERVICE LO TANK
DRAIN/OVERFLOW FROM USED LO TANK
DRAIN/OVERFLOW FROM NEW LO TANK
TO RAIN WATER DRAIN
DRAIN FROM FTH (CRO AREA)
DECA00003909 REJECTED EFFLUENT WATER
DRAIN FROM FTH (NON-ATEX AREA)
DRAIN FROM LFO UNLOADING AREA
DRAIN FROM LFO TRANSFER UNIT
DRAIN FROM LFO LOADING UNIT
DBAF489679 INSTRUMENT AIR
DBAB958328 TO SLUDGE TANK
DBAA352195
DBAF489726 OVERFLOW FROM SLUDGE TANK
DBAF489726 FROM SLUDGE TANK
DBAF489726 TO OW TREATMENT FEED PUMP UNIT
DBAF489679 FROM ALCO SEPARATOR UNITS
DECA00003909 SLUDGE FROM RACKS IN ENGINE HALL
DECA00003909 SLUDGE FROM EFBS IN BOOSTER HOUSE 2
DECA00003909 SLUDGE FROM EFBS IN BOOSTER HOUSE 1
DECA00003909 DAD 914 OILY WATER TRANSFER PUMP UNIT(X) (STORAGE TANKS AREA)
DECA00003909 DAD 908 OILY WATER TRANSFER PUMP UNIT(X) (ALCO UNLOADING)
DECA00003909 DAD 912 OILY WATER TRANSFER PUMP UNIT(X) (TRANSFER AREA SHELTER)
DAD 908 STOP
DAD 908 START
DAD 904 STOP
DAD 904 START
DAD 907 STOP
DAD 907 START
DAD 903 STOP
DAD 903 START
DAD 915 STOP
DAD 915 START
OW FROM ALCO SUMP NO. 1 (OUTSIDE BOOSTER HOUSE 1)
OW FROM ALCO SUMP NO. 2 (OUTSIDE BOOSTER HOUSE 2)
FUEL TREATMENT HOUSE
ENGINE HALL

PROCESS VALUES 1)

ITEM	MEDIUM	MAXIMUM ALLOWABLE VALUES 2)		NORMAL OPERATION VALUES 3)		
		p (barg)	T (°C)	p (barg)	T (°C)	V (m³/h)
1	OW	6	90	3	amb	3

1) ALL PROCESS VALUES ARE INDICATIVE
2) MAXIMUM ALLOWABLE VALUES ARE FOR DETERMINING PIPE WALL THICKNESS
3) VOLUME FLOW IN FAD(FREE AIR DELIVERY) AT 20 °C AND 1 ATM.
4) NORMAL OPERATION VALUES ARE DEFINED UNDER FOLLOWING CONDITIONS:
- ENGINE LOAD: 100 %
- AMBIENT TEMPERATURE: 28 °C
- RELATIVE HUMIDITY: 70 %
- SITE ELEVATION: 125 M

(1) (2) = PROCESS VALUE ITEM

REV	DATE	REVISION DESCRIPTION	DRN	CHK	ENG	APP	EMP
D01	30/04/2024	AS-BUILT		SJK		NBR	
C02	14/07/2021	ISSUED FOR APPROVAL. REVISED DUE TO HFO TO ALCO CONVERSION		SJK		NBR	
C01	26/11/2020	ISSUED FOR CONSTRUCTION		SJK/DBH		NBR	
A03	11/12/2020	REVISED AS PER EMPLOYER COMMENTS DATED 08/10/2020		SJK/DBH		NBR	
A02	11/09/2020	REVISED AS PER EMPLOYER COMMENTS DATED 02/04/2020		SJK/DBH		NBR	
A01	10/03/2020	ISSUED FOR APPROVAL		SJK/DBH		NBR	

DOCUMENT NUMBER | REFERENCE DOCUMENTS

WÄRTSILÄ

© Wärtsilä Finland Oy Energy Business

LARSEN & TOUBRO

This drawing is the property of LARSEN & TOUBRO and must not be passed on to any person or body not authorized by us to receive it nor be copied or otherwise made use either in full or in part by such person or body without our prior permission in writing.

Outotec

The content of these documents are the sole property of Outotec Oyj. Any rights not expressly granted herein are reserved. Reproduction, transfer or distribution of part or all of the contents in any form without prior written permission of Outotec is prohibited.

MA'ADEN معادن
Saudi Arabian Mining Company شركة المعادن العربية السعودية

This document and the information contained herein is Ma'aden proprietary know-how. This document or any part thereof should not be reproduced, stored in a retrieval system or transmitted by any means, electronic or otherwise, or divulged without prior written permission of Ma'aden.

DRAWING NUMBER DBAF489727 | REVISION m

DATE	19-Jul-2022	DATE	19-Jul-2022	DATE	20-Jul-2022
DRAWN	Krishnat Yadav	CHECKED	Henri Holmblad	APPROVED	Sandesh Salunke

LARSEN & TOUBRO DRAWING NUMBER O19045_008_U_V_12045_001 | REVISION 5

OUTOTEC DRAWING NUMBER 900707_GAU01_WG01_PFB01_49017 | DOCUMENT ID OU100674578 | REVISION 5

DRAWN		
CHECKED	SJK/DBH	27/02/2020
ENGINEER		
APPROVED	NBR	10/03/2020
EMPLOYER		
SCALE	NTS	A1

MANSOURAH - MASSARAH GOLD PROJECT
PROCESS FLOW DIAGRAM
POWER GENERATION
(D) OILY WATER TREATMENT SYSTEM 1(3)

DRAWING NUMBER MD-216-49PR-EG-PR-PFD-V553-1032 | REV D01

MA'ADEN معادن
Saudi Arabian Mining Company شركة التعدين العربية السعودية

BECHTEL

Mansourah Massarah Gold Project
Comment Resolution Log Sheet / Compliance Report

Outotec
LARSEN & TOUBRO

PROJECT:	**MANSOURAH MASSARAH GOLD PROJECT**	**PROJECT NO.:**	**216**		
STAGE:	**4 - PROJECT EXECUTION.**	**REVIEW LOG DOC. NO. & REV.:**			
ACONEX REFERENCE NO. & DATE:	MAADEN-STRAN-004120, 24 August 2021				
STATUS CODE: A - APPROVED, C - APPROVED WITH COMMENTS, R - REVISE & RESUBMIT & O - OTHERS (INFORMATION, REFERENCE, REVIEWED)					

DOCUMENT NUMBER	Area / Title	Comment No.	PMC COMMENT	Comment by	EPC Response	Status	Remarks
			24-Aug-21				
MD-216-49PR-EG-PR-PFD-V553-1032-C02	49PR	1	These P&IDs for the HFO to ALCO conversion need to be HAZOPed. Please provide evidence that HAZOP was conducted. See additional comments on MD 216 49PR EG PR PFD V553-1005 C02		As per Employer's requirement the fuel type was changed. Accordingly the fuel system necessary modification was done in this P&ID based on the OEM's recommendation. This is a OEM's standard package / system.	Closed	

MA'ADEN معادن

Saudi Arabian Mining Company شركة التعدين العربية السعودية

Project Mansourah Massarah Gold Project

Customer: MA'ADEN GOLD AND BASE METALS (MA'ADEN)

Title: PROCESS FLOW DIAGRAM
49PR POWER GENERATION
OILY WATER / SLUDGE SYSTEM

Document Number: MD-216-49PR-EG-PR-PFD-V553-1033

Revision: D01

Revision Date: 30.04.2024

Status: AS-BUILT

THIS DRAWING SUPERSEDES EARLIER DRAWING NUMBER MD-216-49PR-EG-ME-PFD-V553-1033

Outotec Document Number:	900707	GAU01	WG01	PFB01	49018	OU100674579	5
L&T Document Number:	O19045	008	U	V	12045	002	5

WÄRTSILÄ Wärtsilä Finland Oy Energy Business	Wartsila Document Number :
	DBAF489726

REVISION HISTORY

Rev	Date	Revision Text	Prepared By	Reviewed By	Approved By	Employer
A01	10.03.2020	ISSUED FOR APPROVAL	Wartsila	SJK / DBH	NBR	
A02	11.09.2020	REVISED AS PER EMPLOYER COMMENTS DATED 02/04/2020.	Wartsila	SJK / DBH	NBR	
A03	29.10.2020	REVISED AS PER EMPLOYER COMMENTS DATED 08/10/2020.	Wartsila	SJK / DBH	NBR	
C01	26.11.2020	ISSUED FOR CONSTRUCTION	Wartsila	SJK / DBH	NBR	
C02	14.07.2021	ISSUED FOR APPROVAL. REVISED DUE TO HFO TO ALCO CONVERSION	Wartsila	SJK	NBR	
D01	30.04.2024	AS-BUILT	Wartsila	SJK	NBR	

DRAWING NUMBER: MD-216-49PR-EG-PR-PFD-V553-1033
REV: D01

THE CODES IN THE DIAGRAM ARE DESCRIBED IN DEVICE LIST No: DBAF489728

THE SYMBOLS USED IN DIAGRAM ARE DESCRIBED IN DOCUMENT No: DBAB669467

USE OF (A) (B) ... INDICATE CODING OF TERMINATION POINTS ON UNITS. EVERY UNIT TERMINATION POINT IS MARKED BEFORE SHIPMENT.

MORE DETAILED INFORMATION ABOUT UNIT COMPONENTS WILL BE FOUND IN UNIT/MODULE P&I DIAGRAMS + DEVICE LISTS.


WFI SUPPLY | CLIENT SUPPLY

NORMAL OPERATION.

V (m³/h)	T (°C)
p (barg))	v (m/s)

TRACE HEATED AND INSULATED

a) VALVE SUPPLIED WITH DBB901 OWT UNIT.

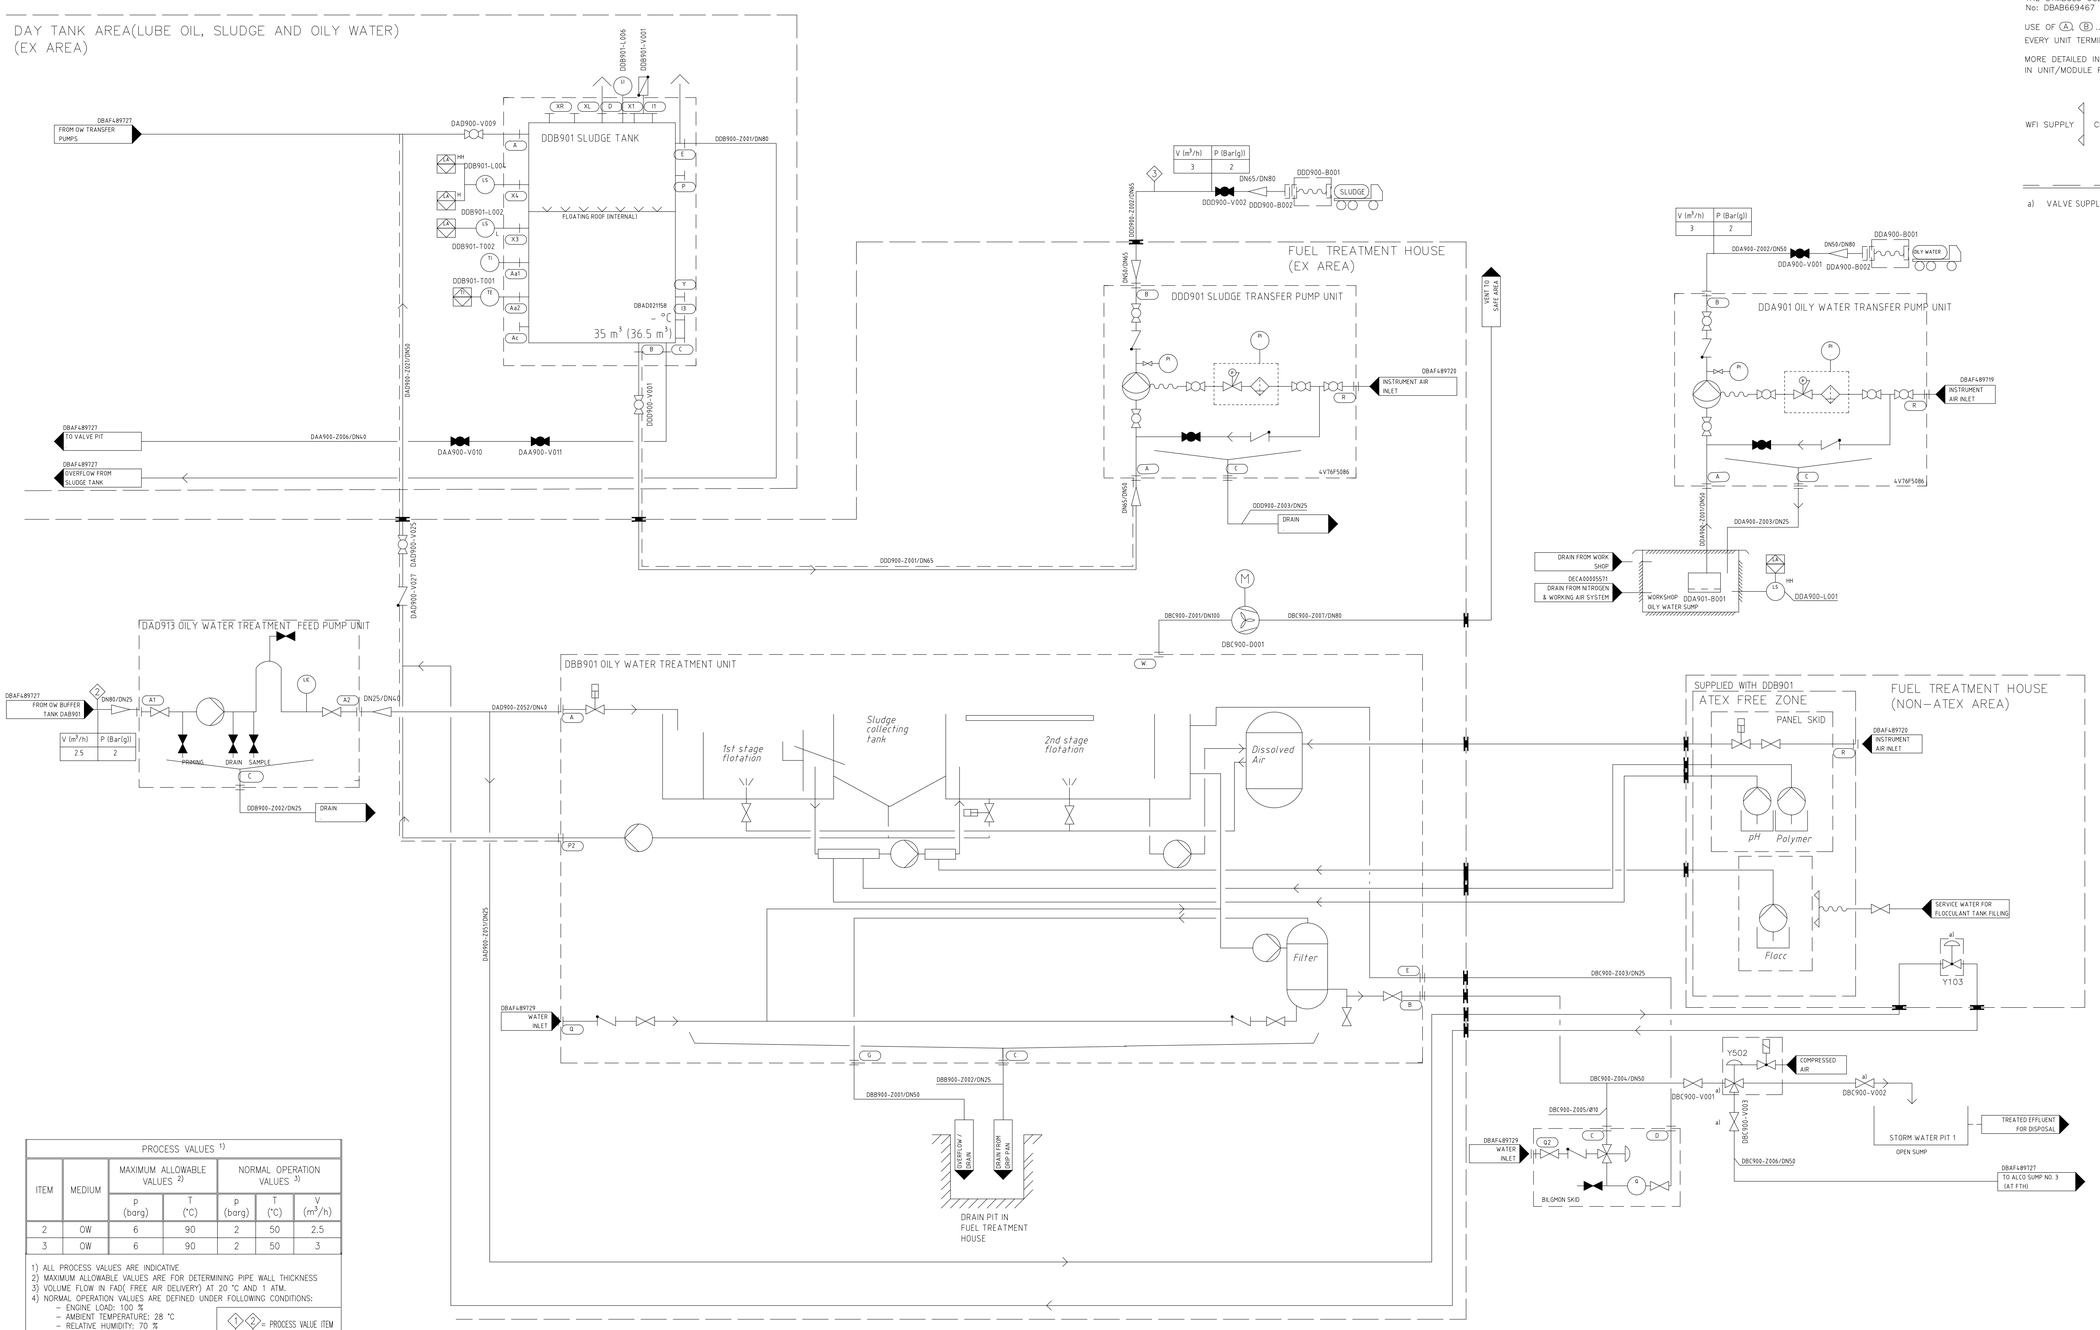

PROCESS VALUES [1]

ITEM	MEDIUM	MAXIMUM ALLOWABLE VALUES [2] p (barg)	MAXIMUM ALLOWABLE VALUES [2] T (°C)	NORMAL OPERATION VALUES [3] p (barg)	NORMAL OPERATION VALUES [3] T (°C)	NORMAL OPERATION VALUES [3] V (m³/h)
2	OW	6	90	2	50	2.5
3	OW	6	90	2	50	3

1) ALL PROCESS VALUES ARE INDICATIVE
2) MAXIMUM ALLOWABLE VALUES ARE FOR DETERMINING PIPE WALL THICKNESS
3) VOLUME FLOW IN FAD(FREE AIR DELIVERY) AT 20 °C AND 1 ATM.
4) NORMAL OPERATION VALUES ARE DEFINED UNDER FOLLOWING CONDITIONS:
- ENGINE LOAD: 100 %
- AMBIENT TEMPERATURE: 28 °C
- RELATIVE HUMIDITY: 70 %
- SITE ELEVATION: 125 M

(1)(2) = PROCESS VALUE ITEM

DOCUMENT NUMBER	REFERENCE DOCUMENTS	REV	DATE	REVISION DESCRIPTION	DRN	CHK	ENG	APP	EMP
		D01	30/04/2024	AS-BUILT		SJK		NBR	
		C02	14/07/2021	ISSUED FOR APPROVAL. REVISED DUE TO HFO TO ALCO CONVERSION		SJK		NBR	
		C01	26/11/2020	ISSUED FOR CONSTRUCTION		SJK/DBH		NBR	
		A03	29/10/2020	REVISED AS PER EMPLOYER COMMENTS DATED 08/10/2020		SJK/DBH		NBR	
		A02	11/09/2020	REVISED AS PER EMPLOYER COMMENTS DATED 02/04/2020		SJK/DBH		NBR	
		A01	10/03/2020	ISSUED FOR APPROVAL		SJK/DBH		NBR	

WÄRTSILÄ

© Wärtsilä Finland Oy
Energy Business

DRAWING NUMBER: DBAF489726 | REVISION: I

DATE	19-Jul-2022	DATE	19-Jul-2022	DATE	20-Jul-2022
DRAWN	Krishnat Yadav	CHECKED	Henri Holmblad	APPROVED	Sandesh Salunke

LARSEN & TOUBRO DRAWING NUMBER: 019045_008_U_V_12045_002 | REVISION: 5

OUTOTEC DRAWING NUMBER: 900707_GAU01_WG01_PFB01_49018 | DOCUMENT ID: OU100674579 | REVISION: 5

LARSEN & TOUBRO

This drawing is the property of LARSEN & TOUBRO and must not be passed on to any person or body not authorized by us to receive it nor be copied or otherwise made use either in full or in part by such person or body without our prior permission in writing.

Outotec

The content of these documents are the sole property of Outotec Oyj. Any rights not expressly granted herein are reserved. Reproduction, transfer or distribution of part or all of the contents in any form without prior written permission of Outotec is prohibited.

MA'ADEN معادن
Saudi Arabian Mining Company شركة معادن العربية السعودية

This document and the information contained herein is Ma'aden proprietary know-how. This document or any part thereof should not be reproduced, stored in a retrieval system or transmitted by any means, electronic or otherwise, or divulged without prior written permission of Ma'aden.

DRAWN		
CHECKED	SJK/DBH	27/02/2020
ENGINEER		
APPROVED	NBR	10/03/2020
EMPLOYER		
SCALE	NTS	A1

MANSOURAH - MASSARAH GOLD PROJECT
PROCESS FLOW DIAGRAM
POWER GENERATION
(D) OILY WATER TREATMENT SYSTEM 2(3)

DRAWING NUMBER: MD-216-49PR-EG-PR-PFD-V553-1033 | REV: D01

MA'ADEN معادن
Saudi Arabian Mining Company شركة التعدين العربية السعودية

BECHTEL

Mansourah Massarah Gold Project
Comment Resolution Log Sheet / Compliance Report

Outotec
LARSEN & TOUBRO

PROJECT:	**MANSOURAH MASSARAH GOLD PROJECT**	**PROJECT NO.:**	**216**		
STAGE:	**4 - PROJECT EXECUTION.**	**REVIEW LOG DOC. NO. & REV.:**			
ACONEX REFERENCE NO. & DATE:	MAADEN-STRAN-004120, 24 August 2021				
STATUS CODE: A - APPROVED, C - APPROVED WITH COMMENTS, R - REVISE & RESUBMIT & O - OTHERS (INFORMATION, REFERENCE, REVIEWED)					

DOCUMENT NUMBER	Area / Title	Comment No.	PMC COMMENT	Comment by	EPC Response	Status	Remarks
			24-Aug-21				
MD-216-49PR-EG-PR-PFD-V553-1033-C02	49PR	1	These P&IDs for the HFO to ALCO conversion need to be HAZOPed. Please provide evidence that HAZOP was conducted. See additional comments on MD 216 49PR EG PR PFD V553-1005 C02		As per Employer's requirement the fuel type was changed. Accordingly the fuel system necessary modification was done in this P&ID based on the OEM's recommendation. This is a OEM's standard package / system.	Closed	